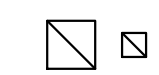
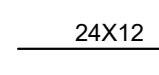
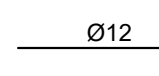
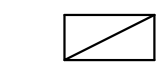
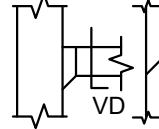


MECHANICAL SYMBOLS

	CEILING DIFFUSER SUPPLY
	CEILING DIFFUSER RETURN/EXHAUST
	RECTANGULAR DUCT (WIDTH X DEPTH)
	ROUND DUCT (DIAMETER)
	ROUND DUCT CROSS SECTION
	POINT OF NEW CONNECTION
	SUPPLY AIR RECTANGULAR DUCT GOING UP/DOWN
	RETURN AIR RECTANGULAR DUCT GOING UP/DOWN
	VOLUME DAMPER W/ ACCESS DOOR

MECHANICAL ABBREVIATIONS

AFF	ABOVE FINISHED FLOOR
CFM	CUBIC FEET OF AIR PER MINUTE
E	EXISTING
FC	FLEXIBLE CONNECTION
HEF	HOOD EXHAUST FAN
MAU	MAKE UP AIR UNIT
N	NEW
RTU	ROOF TOP UNIT
SAE	SAME AS EXISTING
VD	VOLUME CONTROL DAMPER
VIF	VERIFY IN FIELD

GENERAL NOTES

- CONTRACTOR SHALL SURVEY THE AREA OF THIS WORK BEFORE SUBMITTING A BID AND SHALL BE RESPONSIBLE FOR NOTIFYING THE ARCHITECT OF ANY CONDITIONS WHICH WOULD PREVENT THE INSTALLATION OF THE WORK AS SHOWN ON DRAWINGS.
- ALL APPLICABLE CODES, LAWS AND REGULATIONS GOVERNING OR RELATING TO ANY PORTION OF THIS WORK ARE HEREBY INCORPORATED INTO AND MADE A PART OF THESE SPECIFICATIONS, AND THEIR PROVISIONS SHALL BE CARRIED OUT BY THE CONTRACTOR WHO SHALL INFORM THE OWNER, PRIOR TO SUBMITTING A PROPOSAL, OF ANY WORK OR MATERIALS WHICH VIOLATE ANY OF THE ABOVE LAWS AND REGULATIONS. ANY WORK DONE BY THE CONTRACTOR CAUSING SUCH VIOLATION SHALL BE CORRECTED BY THE CONTRACTOR.
- BEFORE PROCEEDING WITH ANY WORK IN OCCUPIED OR USED AREAS, THE CONTRACTOR SHALL APPLY TO OWNER FOR PERMISSION TO ENTER SUCH AREAS. THE CONTRACTOR IS OBLIGED TO PERFORM HIS WORK ONLY AT THE TIMES DESIGNATED BY OWNER. THERE WILL BE NO ADDITIONAL COMPENSATION FOR THE WORK PERFORMED AFTER HOURS OR ON OFF-DAYS WITHOUT PRIOR WRITTEN APPROVAL.
- THE WORK IN THE BUILDING SHALL BE DONE WHEN AND AS DIRECTED, AND IN A MANNER SATISFACTORY TO THE OWNER. THE WORK SHALL BE PERFORMED SO AS TO CAUSE THE LEAST POSSIBLE INCONVENIENCE AND DISTURBANCE TO THE PRESENT OCCUPANTS.
- THE CONTRACTOR'S PROPOSAL FOR ALL WORK SHALL BE PREDICATED ON THE PERFORMANCE OF THE WORK DURING REGULAR WORKING HOURS. WHEN SO DIRECTED, HOWEVER, THE CONTRACTOR SHALL INSTALL WORK IN OVERTIME AND THE ADDITIONAL COST TO BE CHARGED THEREFORE SHALL BE ONLY THE "PREMIUM" PORTION OF THE WAGES PAID.
- CONTRACTOR SHALL ASCERTAIN THE APPROPRIATE METHOD FOR BRINGING THE UNITS INTO AND THROUGH THE BUILDING TO POSITION UNIT IN LOCATION SHOWN ON THE PLANS. WHERE NECESSARY, EQUIPMENT SHALL BE SHIPPED FROM MANUFACTURER IN SECTIONS OF SIZE SUITABLE FOR MOVING THROUGH RESTRICTIVE SPACES. COORDINATE WITH BUILDING OWNER APPROPRIATE TIMES OF DAY SUCH EQUIPMENT MAY BE MOVED THROUGH ALL AREAS.
- DUCTWORK AND PIPING IS SHOWN DIAGRAMMATICALLY AND DOES NOT SHOW ALL OFFSETS, DROPS AND RISES OF RUNS. THE CONTRACTOR SHALL MAKE ALLOWANCE IN PRICING FOR ROUTING OF DUCTWORK AND PIPING TO AVOID OBSTRUCTIONS. EXACT LOCATIONS ARE SUBJECT TO APPROVAL OF ARCHITECT. COORDINATION WITH THE OTHER TRADES IS REQUIRED.
- SUPPORT ALL DUCTWORK AND PIPING FROM BUILDING STRUCTURE AND/OR FRAMING IN AN APPROVED MANNER. WHERE OVERHEAD CONSTRUCTION DOES NOT PERMIT FASTENING OR SUPPORTS FOR EQUIPMENT, FURNISH ADDITIONAL FRAMING. INSERTS SHALL BE STEEL, SLOTTED TYPE AND FACTORY PAINTED. SINGLE ROD SHALL BE SIMILAR TO GRINNELL FIG. 281. MULTI-ROD SHALL BE SIMILAR TO FEE & MASON SERIES 9000 WITH END CAPS AND CLOSURE STRIPS. MAXIMUM LOADING INCLUDING PIPES, DUCTWORK CONTENTS AND COVERING SHALL NOT EXCEED 75% OF RATED INSERT CAPABILITY. WHEN SUPPORTING FROM BUILDING USE BEAM CLAMPS IN APPROVED MANNER.
- PROVIDE ALL NECESSARY FLASHING AND COUNTER FLASHING TO MAINTAIN THE WATERPROOFING INTEGRITY OF THIS BUILDING AS REQUIRED BY THE INSTALLATION OR REMOVAL OF PIPES, DUCTS, LOUVERS, CONDUIT, AND EQUIPMENT. PROVIDE EQUIPMENT CURBS AND DUNNAGE STEEL AS REQUIRED.
- SEAL OPENINGS AROUND DUCTS AND PIPING THROUGH PARTITIONS, WALLS AND FLOORS (NOT IN SHAFTS) WITH MINERAL WOOL OR OTHER NONCOMBUSTIBLE MATERIAL (FIBERGLASS INSULATION IS NOT ACCEPTABLE).
- WHERE PENETRATIONS THROUGH FIRE RATED WALLS ARE NOT FIRE PROOFED THIS CONTRACTOR SHALL BE RESPONSIBLE TO SEAL SAME TO MAINTAIN THE RATED INTEGRITY.
- INSTALL WORK SO AS TO BE READILY ACCESSIBLE FOR OPERATION, MAINTENANCE AND REPAIR. MINOR DEVIATIONS FROM DRAWINGS MAY BE MADE TO ACCOMPLISH THIS, BUT CHANGES WHICH INVOLVE EXTRA COST SHALL NOT BE MADE WITHOUT APPROVAL.
- ACCESS DOORS ARE REQUIRED FOR ALL BUILDING SERVICE VALVES THAT RUN THROUGH THE SPACE, AND ACCESS DOOR SHALL HAVE THE EQUAL RATED CAPACITY (1HR, 2HR, ETC.) AS WALL. COORDINATE ALL LOCATIONS OF ACCESS DOORS WITH THE ARCHITECT.
- REMOVABLE ACCESS TILE AND/OR ACCESS DOOR ARE REQUIRED IN HUNG CEILINGS, SHAFTS AND WALLS FOR ALL VOLUME AND FIRE DAMPERS, AUTOMATIC DAMPERS AND ALL OTHER MECHANICAL EQUIPMENT AND DEVICES. HVAC CONTRACTOR TO FURNISH ACCESS LOCATION REQUIREMENTS TO GENERAL CONTRACTOR. ACCESS TILE IDENTIFICATION: PROVIDE BUTTONS, TABS, AND MARKERS TO IDENTIFY LOCATION OF CONCEALED VALVES, DAMPERS AND EQUIPMENT.
- THE CONTRACTOR SHALL KEEP ALL EQUIPMENT AND MATERIALS, AND ALL PARTS OF THE BUILDING, EXTERIOR SPACES AND ADJACENT STREETS, SIDEWALKS AND PAVEMENTS, FREE FROM MATERIAL AND DEBRIS RESULTING FROM THE EXECUTION OF THIS WORK. EXCESS MATERIALS WILL NOT BE PERMITTED TO ACCUMULATE EITHER ON THE INTERIOR OR THE EXTERIOR.
- MATERIALS AND WORKMANSHIP, UNLESS OTHERWISE NOTED, SHALL BE IN ACCORDANCE WITH BUILDING STANDARDS.
- ALL EQUIPMENT SHALL BE PROVIDED WITH ONE YEAR WARRANTY PARTS AND LABOR AND FIVE YEARS ON COMPRESSORS. WARRANTY PERIOD BEGINS UPON PROJECT ACCEPTANCE
- ALL MATERIAL AND EQUIPMENT TO BE NEW UNLESS OTHERWISE NOTED AND SHALL BE IN ACCORDANCE WITH BUILDING STANDARDS.
- THE CONTRACTOR SHALL BE RESPONSIBLE FOR HIS WORK WITH ITS COMPLETION AND FINAL ACCEPTANCE AND SHALL REPLACE ANY OF THE SAME WHICH MAY BE DAMAGED, LOST, OR STOLEN WITHOUT ADDITIONAL COST TO THE OWNER.
- THE CONTRACTOR SHALL BE RESPONSIBLE FOR THE FAILURE OF ANY DUCTWORK SYSTEM OR EQUIPMENT TO FUNCTION PROPERLY UPON COMPLETION OF HIS WORK UPON SAID SYSTEM OR EQUIPMENT.
- SUBMIT SHOP DRAWING OF ALL WORK WHICH MUST BE APPROVED BY THE ARCHITECT AND ENGINEER BEFORE WORK COMMENCES.
- INSURANCE: IN ACCORDANCE WITH BUILDING REQUIREMENTS THE CONTRACTOR SHALL INCLUDE A HOLD HARMLESS CLAUSE FOR OWNER AND ENGINEER.
- THE FINAL ACCEPTANCE WILL BE MADE AFTER THE CONTRACTOR HAS ADJUSTED HIS EQUIPMENT, BALANCED THE VARIOUS SYSTEMS, DEMONSTRATED THAT IT FULFILLS THE REQUIREMENTS OF THE DRAWINGS AND SPECIFICATIONS AND HAS FURNISHED ALL THE REQUIRED CERTIFICATES OF INSPECTION AND APPROVAL.
- SPECIFICATIONS ARE OF SIMPLIFIED FORM AND INCLUDE INCOMPLETE SENTENCES. WORDS OR PHRASES SUCH AS "THE CONTRACTOR SHALL," "SHALL BE," "FURNISH," "PROVIDE," "A," "THE," AND "ALL" HAVE BEEN OMITTED FOR BREVITY.
- WHERE A CONFLICT EXISTS BETWEEN THE DRAWINGS, THE SPECIFICATIONS OR ANY OTHER CONSTRUCTION DOCUMENT, THE ONE WITH THE MOST STRINGENT REQUIREMENT(S) SHALL APPLY.

DEFINITIONS:

- "PROVIDE": TO SUPPLY, INSTALL AND CONNECT UP COMPLETE AND READY FOR SAFE AND REGULAR OPERATION THE PARTICULAR WORK REFERRED TO UNLESS SPECIFICALLY OTHERWISE NOTED.
- "INSTALL": TO ERECT, MOUNT AND CONNECT COMPLETE WITH RELATED ACCESSORIES.
- "FURNISH" OR "SUPPLY": TO PURCHASE, PROCURE, ACQUIRE AND DELIVER COMPLETE WITH RELATED ACCESSORIES.

SCOPE OF WORK

SCOPE OF WORK

- THE WORK UNDER CONTRACT INCLUDES ALL LABOR, MATERIALS AND APPLIANCES NECESSARY FOR THE FURNISHING, INSTALLING AND TESTING, COMPLETE AND READY FOR SAFE OPERATION OF THE SYSTEMS AS DESCRIBED IN THE SPECIFICATIONS, FLOOR PLAN(S) DESIGN, DETAIL DRAWINGS, NOTES, RFIS, ETC. FOR THIS PROJECT. WORK SHALL BE INSTALLED IN A NEAT, WORKMANLIKE MANNER.
- THE CONTRACTOR SHALL GIVE NECESSARY NOTICE, FILE DRAWINGS AND SPECIFICATIONS WITH THE DEPARTMENT HAVING JURISDICTION, OBTAIN PERMITS OR LICENSES NECESSARY TO CARRY OUT THIS WORK AND PAY ALL FEES THEREFORE. THE CONTRACTOR SHALL ARRANGE FOR INSPECTION AND TESTS OF ANY OR ALL PARTS OF THE WORK IF SO REQUIRED BY AUTHORITIES AND PAY ALL CHARGES FOR SAME. THE CONTRACTOR SHALL PAY ALL COSTS FOR, AND FURNISH TO THE OWNER BEFORE FINAL BILLING, ALL CERTIFICATES NECESSARY AS EVIDENCE THAT THE WORK INSTALLED CONFORMS WITH ALL REGULATIONS WHERE THEY APPLY TO THIS WORK.
- THE CONTRACTOR SHALL FURNISH A WRITTEN GUARANTEE TO REPLACE OR REPAIR PROMPTLY AND ASSUME RESPONSIBILITY FOR ALL EXPENSES INCURRED FOR ANY WORKMANSHIP AND EQUIPMENT IN WHICH DEFECTS DEVELOP WITHIN ONE YEAR FROM THE DATE OF FINAL CERTIFICATE FOR PAYMENT AND/OR FROM DATE OR ACTUAL USE OF EQUIPMENT OR OCCUPANCY OF SPACES, BY OWNER, INCLUDED UNDER THE VARIOUS PARTS OF THE WORK, WHICHEVER DATE IS EARLIER. THIS WORK SHALL BE DONE AS DIRECTED BY THE OWNER. THIS GUARANTEE SHALL ALSO PROVIDE THAT WHERE DEFECTS OCCUR, THE CONTRACTOR WILL ASSUME RESPONSIBILITY FOR ALL EXPENSES INCURRED IN REPAIRING AND REPLACING WORK OF OTHER TRADES AFFECTED BY DEFECTS, REPAIRS OR REPLACEMENTS IN EQUIPMENT SUPPLIED BY THE CONTRACTOR.

SPECIFICATIONS

SECTION 0001 - NOTICE TO BIDDERS

1.1 BIDDERS REPRESENTATIONS

- THE BIDDER BY MAKING A BID REPRESENTS THAT:
- THE BIDDER HAS READ AND UNDERSTANDS THE BIDDING DOCUMENTS, TO THE EXTENT THAT SUCH DOCUMENTATION RELATES TO THE WORK FOR WHICH THE BID IS SUBMITTED, AND FOR OTHER PORTIONS OF THE PROJECT, IF ANY, BEING BID CONCURRENTLY OR PRESENTLY UNDER CONSTRUCTION.
- THE BID IS MADE IN COMPLIANCE WITH THE BIDDING DOCUMENTS.
- THE SPECIFICATIONS AND DRAWINGS ARE INTENDED TO SERVE JOINTLY AS A BASIS FOR THE BIDDER TO SUBMIT A CONTRACT PRICE FOR THE MATERIAL AND LABOR.
- SHOULD CONFLICTS OR DISCREPANCIES OCCUR WITHIN THE BIDDING DOCUMENTS, THE ITEM OR ITEMS IN DISPUTE THAT REPRESENT THE GREATER COST SHALL PREVAIL IN THE FINAL BID.
- THE BID IS BASED UPON THE MATERIALS, EQUIPMENT AND SYSTEMS REQUIRED BY THE BIDDING DOCUMENTS WITHOUT EXCEPTION.

1.2 EXISTING CONDITIONS AND COORDINATION

- THE BIDDER HAS VISITED THE SITE, BECOME FAMILIAR WITH LOCAL CONDITIONS UNDER WHICH THE WORK IS TO BE PERFORMED, AND HAS CORRELATED THE BIDDER'S OBSERVATIONS WITH THE REQUIREMENTS OF THE PROPOSED BIDDING DOCUMENTS.
 - THE BIDDER SHALL PROPOSE COORDINATION OF WORK SUCH THAT CONFLICTS WITH OTHER TRADES AND SPACE ALLOCATIONS ARE AVOIDED.
- 1.3 RESPONSIBILITIES
- THE BIDDER UNDERSTANDS THAT ANY CONTRACTOR SHALL BE FULLY RESPONSIBLE FOR THE TIMELY COMPLETION AND ACCEPTANCE OF THEIR WORK AND THAT ANY ITEMS DAMAGED, LOST, OR STOLEN DURING TIME OF CONSTRUCTION SHALL BE REPAIRED OR REPLACED WITHOUT ANY ADDITIONAL COST TO THE OWNER.
 - THE BIDDER UNDERSTANDS THAT ANY PROPOSED WORK IN OCCUPIED TENANT SPACES SHALL BE PERFORMED DURING TIMES OF NON-TENANT OCCUPANCY OR AS SCHEDULED OR DIRECTED BY THE BUILDING MANAGER.
 - THE BIDDER UNDERSTANDS THAT ANY PROPOSED SHUTDOWN OF EXISTING SYSTEMS DURING CONSTRUCTION SHALL BE PRE-ARRANGED WITH THE BUILDING MANAGER AND THAT SUCH SHUTDOWNS ARE TO BE KEPT TO A MINIMUM.

END OF SECTION 0001

SECTION 0101 - QUALITY OF WORK

1.1 WORKMANSHIP

- ALL WORK SHALL BE FREE FROM DEFECTS IN MATERIALS AND WORKMANSHIP FOR A PERIOD OF ONE YEAR FROM DATE OF FINAL ACCEPTANCE.
- ALL DEFECTS WHICH DEVELOP OR ARE DISCOVERED WITHIN THIS PERIOD SHALL BE REPAIRED BY THE CONTRACTOR TO THE SATISFACTION OF THE ARCHITECT OR BUILDING MANAGER AT NO ADDITIONAL COST TO THE OWNER.
- UPON COMPLETION OF THE WORK THE CONTRACTOR SHALL REMOVE FROM THE SITE, ALL TOOLS, DEMOLISHED APPLIANCES AND ANY SURPLUS MATERIAL.

1.2 CODE COMPLIANCE

- ALL WORK SHALL MEET ALL STATE AND LOCAL CODES HAVING JURISDICTION.

END OF SECTION 0101

SECTION 0102 -REQUIRED DOCUMENTS

1.1 SHOP DRAWINGS

- A SET OF PRINTS FOR ANY MECHANICAL WORK INCLUDING BUT NOT LIMITED TO, DUCTWORK AND PIPING LAYOUT SHALL BE SUBMITTED FOR APPROVAL TO THE ENGINEER PRIOR TO CONSTRUCTION OR PURCHASE OF MATERIALS.
- 1.2 SUBMITTALS

- EQUIPMENT SUBMITTALS OF ALL PROPOSED MECHANICAL AND ANCILLARY EQUIPMENT INCLUDING ALL ACCESSORIES SHALL BE SUBMITTED TO THE ENGINEER FOR REVIEW. ALL PERTINENT MODELS, SIZES, ACCESSORIES, AND CHOICES SHALL BE CHECKED, PRINTED, OR OTHERWISE INDICATED ON THE SUBMITTALS.

1.3 RECORD DRAWINGS

- UPON COMPLETION OF THE WORK, A RECORD DRAWING SHALL BE SUBMITTED TO THE OWNER DEPICTING ALL SUBSEQUENT CHANGES, ADDITIONS AND OR CORRECTIONS TO THE CONTRACT DRAWINGS AND OR CONTRACT SCOPE MADE DURING CONSTRUCTION. THIS DRAWING SHALL REPRESENT A COMPLETE RECORD OF THE WORK INSTALLED.

1.4 EQUIPMENT OPERATING INSTRUCTIONS

- ON COMPLETION AND ACCEPTANCE OF WORK, THIS CONTRACTOR SHALL FURNISH WRITTEN INSTRUCTIONS, EQUIPMENT MANUALS AND DEMONSTRATE TO THE OWNER THE PROPER OPERATION AND MAINTENANCE OF ALL EQUIPMENT AND APPARATUS FURNISHED UNDER THIS CONTRACT.
- THESE INSTRUCTIONS SHALL BE TYPED ON 8-1/2 IN. X 11 IN. PAPER AND BOUND IN THREE-RING BINDERS WITH CLEAR ACETATE COVERS. THE CONTRACTOR SHALL GIVE THREE COPIES OF THE INSTRUCTIONS TO THE OWNER AND ONE ELECTRONIC COPY TO THE ENGINEER.
- THE INSTRUCTION BOOKLET SHALL BE ORGANIZED IN SECTIONS, WITH ONE SECTION PER SYSTEM. THE COVER OF THE INSTRUCTION BOOKLET SHALL BEAR THE NAME, ADDRESS AND PHONE NUMBER OF THE PROJECT, ARCHITECT, ENGINEER, MECHANICAL CONTRACTOR AND SUBCONTRACTORS.

END OF SECTION 0102

SECTION 230593 - TESTING, ADJUSTING, AND BALANCING FOR HVAC

1.1 SUMMARY

- TESTING, ADJUSTING, AND BALANCING FOR THE FOLLOWING:

- MOTORS.
- CONDENSING UNITS.
- AIR SYSTEM: CONSTANT VOLUME

1.2 QUALITY ASSURANCE

- THE CONTRACTOR SHALL PROCURE THE SERVICES OF A TESTING, ADJUSTING AND BALANCING (TAB) SPECIALIST WHO SPECIALIZES IN HEATING, VENTILATION AND AIR CONDITIONING SYSTEMS. THE TAB AGENT SHALL HAVE THE FOLLOWING QUALIFICATIONS: AABC, NEBB OR TABB CERTIFIED.

1.3 EXECUTION

- THE TAB SPECIALIST SHALL PERFORM FLOW MEASUREMENTS OF ALL EXISTING AIR AND HYDRONIC SYSTEMS THAT ARE TO REMAIN OR TO BE INCORPORATED INTO NEW WORK PRIOR TO THE STARTING OF WORK IN THE PROJECT SCOPE. A REPORT OF THESE MEASUREMENTS, INDICATING ANY AND ALL DEFICIENCIES SHALL BE SUBMITTED FOR OWNER REVIEW.
- THE TAB SPECIALIST SHALL PERFORM FLOW MEASUREMENTS OF ALL NEW AIR AND HYDRONIC SYSTEMS AS LISTED ABOVE IN THE PROJECT SCOPE. A REPORT OF THESE MEASUREMENTS, INDICATING ANY AND ALL DEFICIENCIES SHALL BE SUBMITTED FOR OWNER REVIEW.
- THE REPORT SHALL INDICATE A SCHEMATIC DIAGRAM INDICATING LOCATIONS OF ALL EQUIPMENT TESTED AND MEASUREMENT LOCATIONS.
- PRIOR TO FINAL INSPECTION OF THE WORK, THE TAB SPECIALIST SHALL BALANCE ALL SYSTEMS AS INDICATED ABOVE TO THE REQUIREMENTS OF THE DESIGN.
- THE CONTRACTOR SHALL HAVE FURNISH AND INSTALL ALL ADDITIONAL BALANCING EQUIPMENT, PRESSURE TAPS, GAUGES AND OTHER EQUIPMENT AS REQUIRED FOR A PROPERLY BALANCED SYSTEM AT NO ADDITIONAL COST TO THE OWNER. SUCH ADDITIONAL EQUIPMENT SHALL ADHERE IN STRICT ACCORDANCE WITH THE RESPECTIVE EQUIPMENT MANUFACTURER'S RECOMMENDATIONS.
- THE CONTRACTOR SHALL HAVE THE TESTING AND BALANCING SPECIALIST COORDINATE ALL WORK OF THIS SECTION WITH THE BUILDING MANAGER. BALANCING WORK SHALL NOT CONFLICT WITH OTHER WORK SO AS TO MAINTAIN COMPLETION WITHIN THE SPECIFIED TIME.
- ALL INSTRUMENTS USED FOR TAB SHALL BE MAINTAINED IN GOOD WORKING CONDITION AND ACCURATELY CALIBRATED.
- TOLERANCES: PLUS OR MINUS 5 PERCENT OF DESIGN VALUES.
- INSPECTIONS: RANDOM CHECKS BY OWNER OR ARCHITECT TO VERIFY FINAL TESTING, ADJUSTING, AND BALANCING REPORT.
- ADDITIONAL TESTS: RANDOM TESTS WITHIN 90 DAYS OF COMPLETING TAB TO VERIFY BALANCE CONDITIONS AND SEASONAL TESTS.

END OF SECTION 230593

ISSUE	DESCRIPTION	DATE
00	INITIAL ISSUE	06/23/2025
01	CLIENT REVISION	01/15/2026

DOB APPROVAL STAMP:

DATE: 06/02/2025
PROJECT NO.: Z166-24
DRAWN BY: NYE
CHECKED BY: NYE
SCALE: AS NOTED

DRAWING TITLE:

MECHANICAL SYMBOL,
NOTES & SPECIFICATIONS

DRAWING NO.:


M-001

GENERAL NOTES:

- A. NEW DUCTWORK SHOWN ON PLAN ARE SCHEMATIC ONLY. CONTRACTOR SHALL COORDINATE WITH OTHER TRADES FOR PIPING AND DUCTWORK ROUTING. OFFSET AND RUN PIPING, DUCTWORK INSIDE THE STRUCTURE IF REQUIRED, PROVIDE ANY EXTRA PIPING, DUCTWORK, FITTINGS, INSULATIONS AND OTHER ACCESSORIES IN ORDER TO COMPLETE THE INSTALLATION.
- B. COORDINATE LOCATIONS AND SIZES OF INTAKE & EXHAUST OPENINGS WITH OWNER AND RESPECTIVE ENGINEER.
- C. EQUIPMENT SIZES, DIMENSIONS AND REQUIRED CONNECTIONS SHALL BE VERIFIED WITH THE ACTUAL EQUIPMENT SELECTED VENDOR DRAWINGS BEFORE FABRICATION OF DUCTWORK, PIPING ETC.
- D. DUCT SIZES SHOWN ON PLANS ARE CLEAR INSIDE AIR STREAM DIMENSIONS.
- E. CONTRACTOR SHALL COORDINATE ALL ELECTRICAL REQUIREMENTS FOR ALL HVAC BASED ON ACTUAL EQUIPMENT SELECTED PRIOR TO INSTALLATION.
- F. COORDINATE WITH ALL TRADES FOR MATERIALS IN RATED AND PLENUM SPACES.
- G. NEW DUCTWORK IN CONCEALED AREAS MAY BE RECTANGULAR WITH EQUIVALENT CROSS SECTIONAL FLOW AREA.
- H. PROVIDE INTERNAL INSULATION FOR ALL EXPOSED DUCTWORK AND EXTERNAL FOR ALL DUCTWORK IN CONCEALED AREAS.
- I. PROVIDE FIRE OR FIRE+SMOKE DAMPER WHEREVER DUCTS ARE CROSSING FIRE/SMOKE RATED WALLS/BARRIERS. COORDINATE WITH ARCHITECTURAL DRAWINGS FOR FIRE RATINGS OF THE WALLS.
- J. ARCHITECTURAL LAYOUT AND DIMENSIONS FOR EQUIPMENT TO TAKE PRECEDENCE OVER MEP.
- K. ACOUSTICALLY LINE THE FIRST 10'-0" OF BOTH SUPPLY AND RETURN DUCTS.
- L. THE ENTIRE INSTALLATION SHALL BE GUARANTEED FREE OF DEFECTS AND CONTRACTOR SHALL REPAIR AND / OR REPLACE ANY DEFECTIVE MATERIALS OR EQUIPMENT AT NO COST TO THE OWNER FOR A MINIMUM PERIOD OF ONE YEAR FROM THE DATE OF ACCEPTANCE BY ARCHITECT OR ENGINEER.
- M. THE CONTRACTOR SHALL, UPON COMPLETION OF PROJECT, PERFORM A COMPLETE TEST AND BALANCE OF ALL EQUIPMENT. PROVIDE A WRITTEN REPORT TO THE ARCHITECT. ALL CAPACITIES MUST BE SET TO WITHIN $\pm 10\%$ OF AMOUNTS INDICATED ON THE FLOOR PLAN AND SCHEDULES.




MECHANICAL PLAN NOTES: (E)

1. NOT USED.
2. NOT USED.
3. NOT USED.
4. HOOD-1(E) HAS (1) EXHAUST COLLAR @1481 CFM, (2) MUA COLLAR @607 CFM EACH, & (2) AC COLLAR AT 174 CFM EACH. CONTRACTOR TO ADJUST CFM AS MENTIONED.
5. HOOD-2(E) HAS (1) EXHAUST COLLAR @1983 CFM, (2) MUA COLLAR @792 CFM EACH, & (2) AC COLLAR AT 250 CFM EACH. CONTRACTOR TO ADJUST CFM AS MENTIONED.
6. NOT USED.
7. COMPLETE AREA IS SERVED BY EXISTING RTU. COMPLETE EXISTING SYSTEM TO REMAIN AS IT IS.
8. EXISTING HOOD ALONG WITH ALL ACCESSORIES TO REMAIN AS IT IS.
9. CONTRACTOR TO FILED VERIFY THAT NEW EQUIPMENT ADDED UNDER HOOD-2(E) IS WITHIN COVERAGE AREA OF EXISTING HOOD.

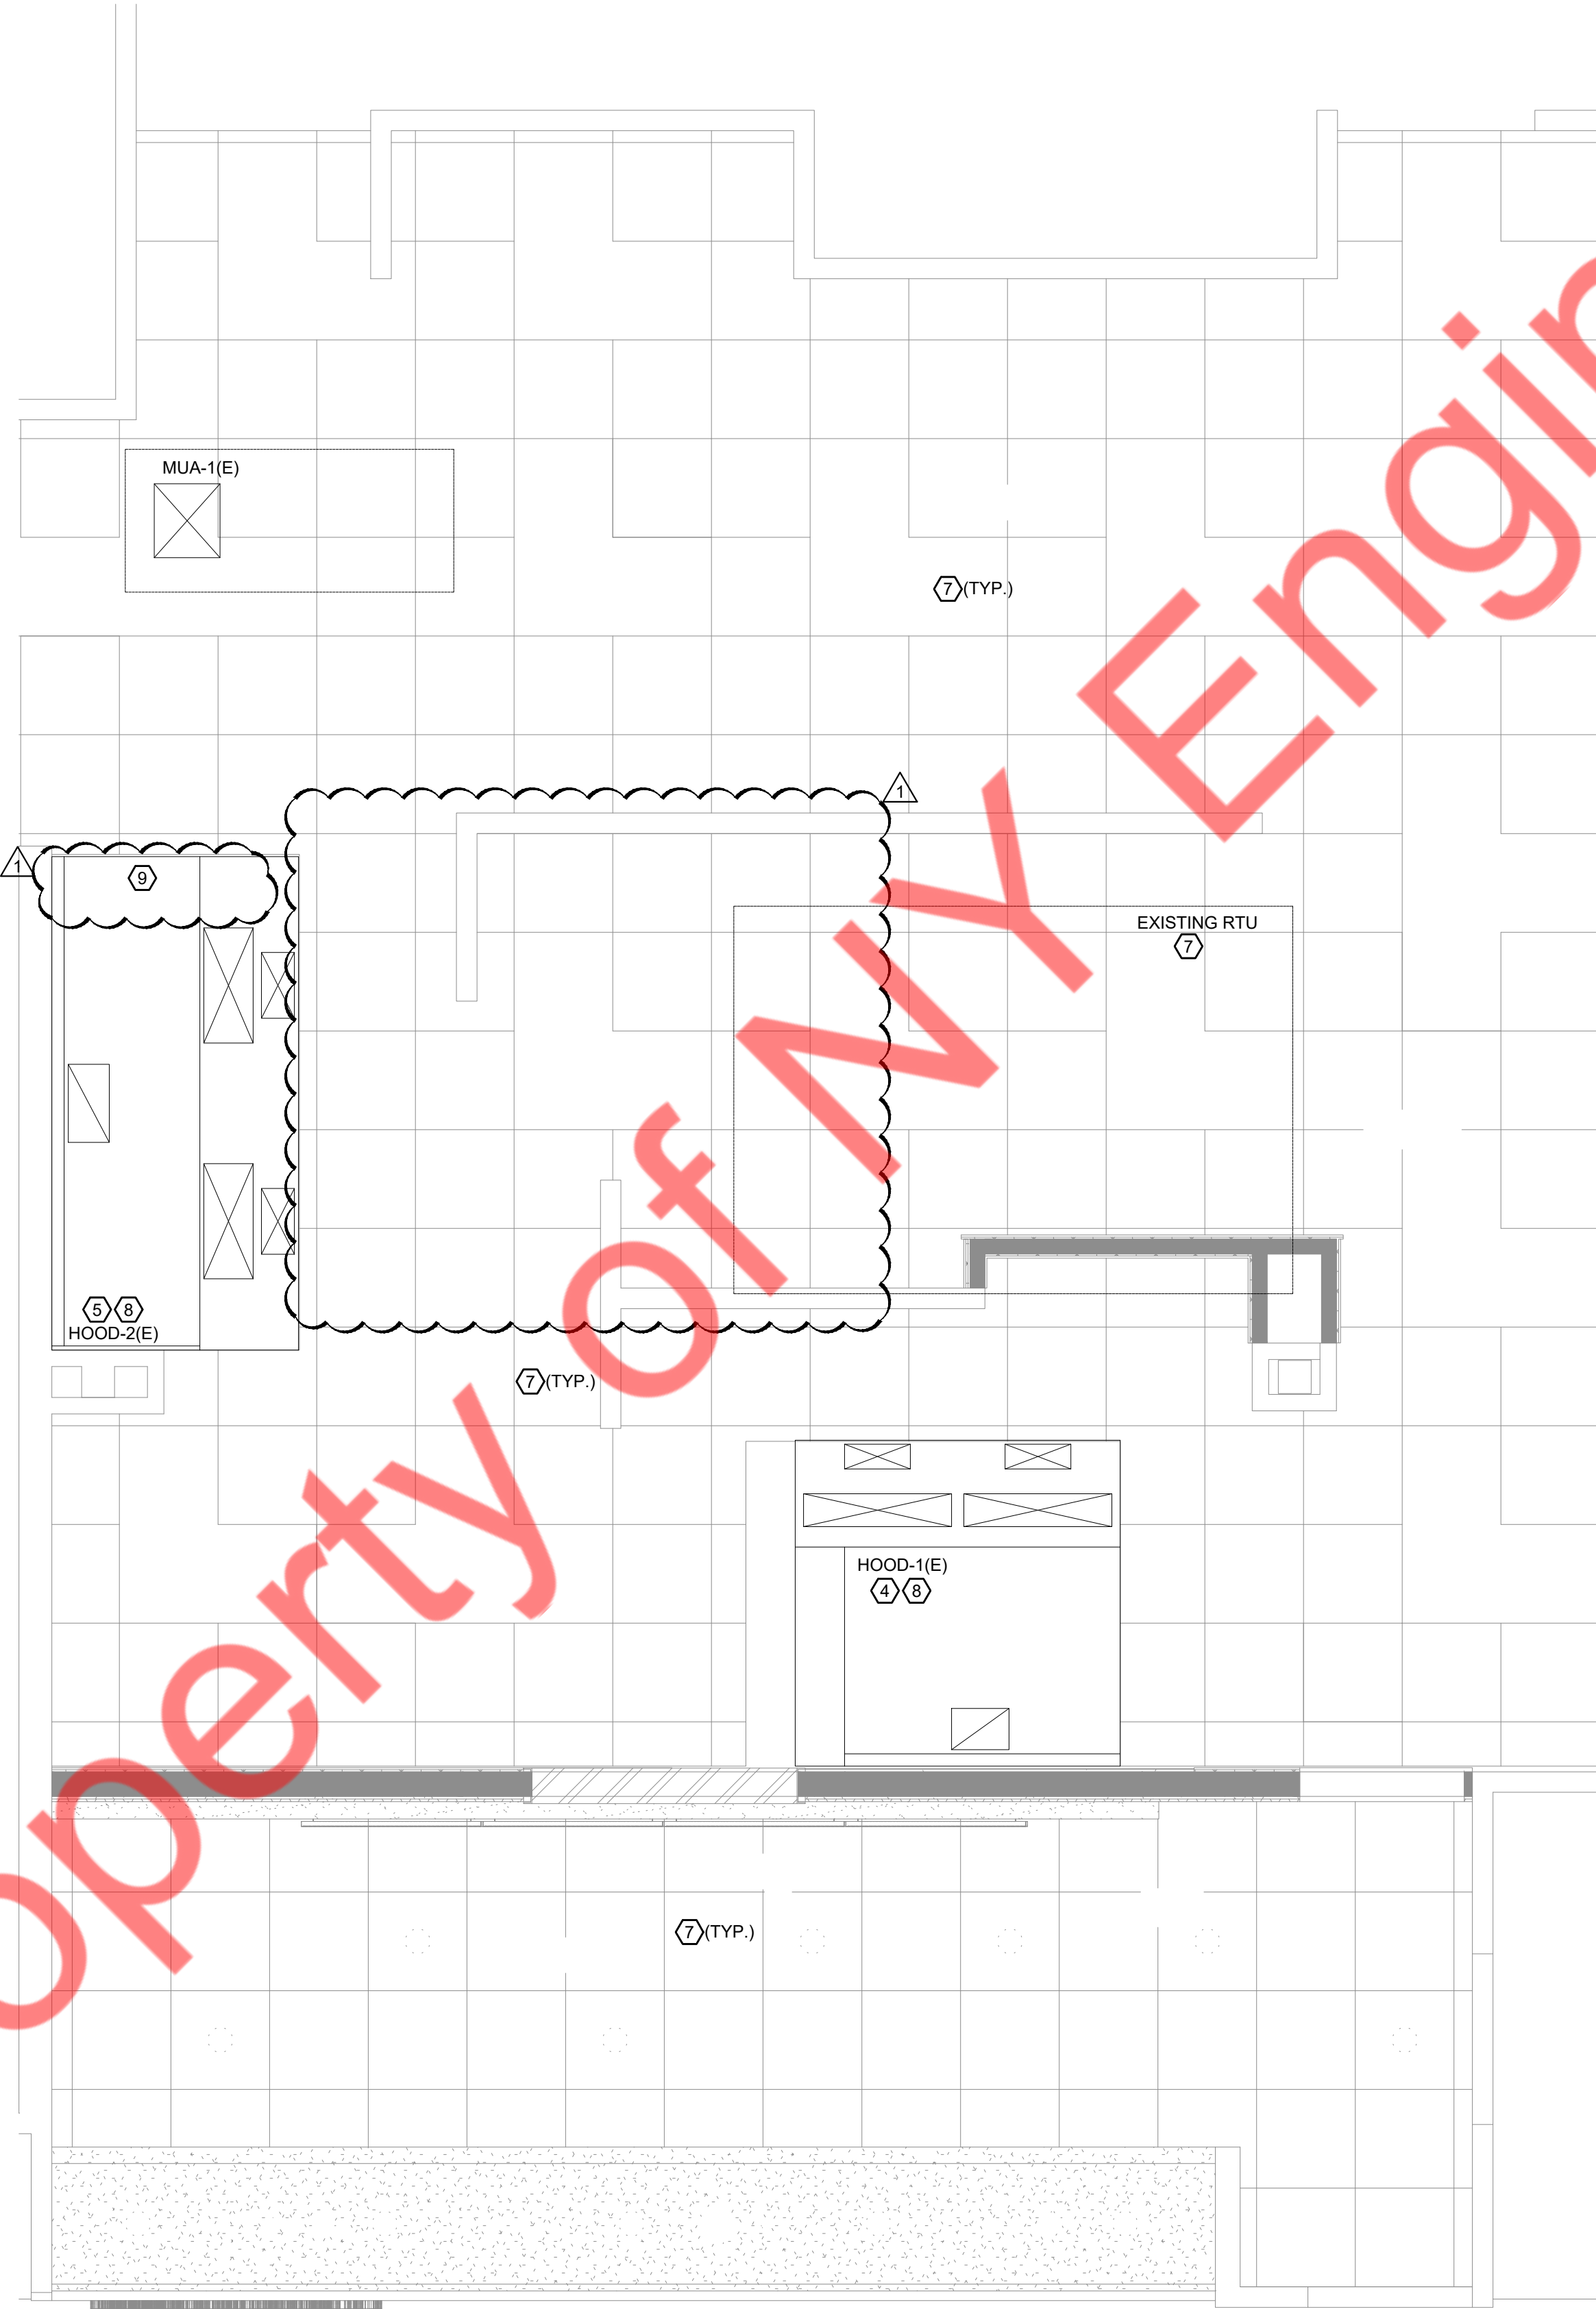

1 MECHANICAL FLOOR PLAN
3/8" = 1'-0"

ISSUE	DESCRIPTION	DATE
00	INITIAL ISSUE	06/23/2025
01	CLIENT REVISION	01/15/2026

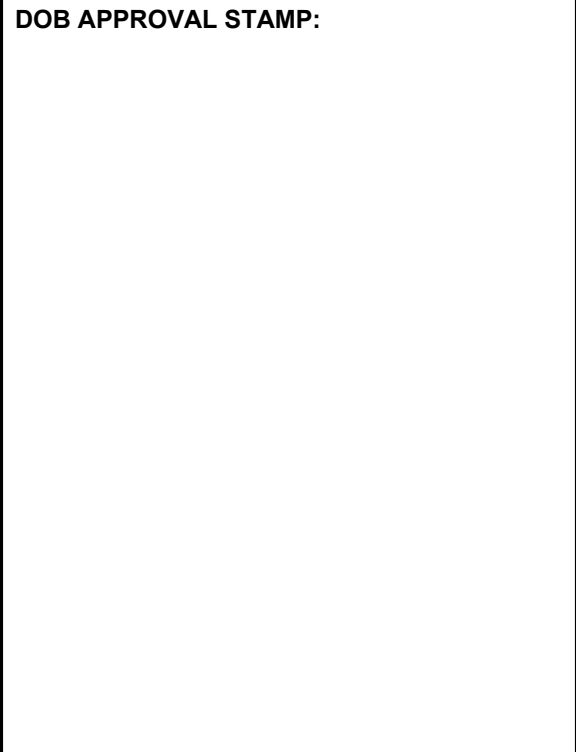  


DATE:	06/02/2025
PROJECT NO.:	Z166-24
DRAWN BY:	NYE
CHECKED BY:	NYE
SCALE:	AS NOTED

DRAWING TITLE:
MECHANICAL FLOOR PLAN

DRAWING NO.:
M-100


- GENERAL NOTES:
- A. COORDINATE LOCATIONS AND SIZES OF ROOF OPENINGS WITH OWNER AND LL ROOFING CONTRACTOR. PROVIDE NEW OPENING IF REQUIRED AND CLOSE USED OPENINGS.
 - B. EQUIPMENT SIZES, DIMENSIONS AND REQUIRED CONNECTIONS SHALL BE VERIFIED WITH THE ACTUAL EQUIPMENT SELECTED VENDOR DRAWINGS AND SITE BEFORE FABRICATION OF DUCTWORK, PIPING ETC.
 - C. CONTRACTOR SHALL COORDINATE ALL ELECTRICAL REQUIREMENTS FOR ALL HVAC BASED ON ACTUAL EQUIPMENT SELECTED PRIOR TO INSTALLATION.
 - D. CONTRACTOR SHALL COORDINATE EQUIPMENT WEIGHTS AND SUPPORTS BASED ON ACTUAL EQUIPMENT SELECTED.
 - E. COORDINATE ALL EQUIPMENT WITH STRUCTURAL DRAWING.
 - F. MAINTAIN ALL CODE AND MANUFACTURERS RECOMMENDED CLEARANCE AROUND ALL ROOF EQUIPMENT.
 - G. ALL SOURCE OF MECHANICAL INTAKE SHALL MAINTAIN 10 FEET SEPARATION BETWEEN ANY SOURCE OF EXHAUST. CONTRACTOR IS RESPONSIBLE TO ADJUST DUCT LENGTH AS NEEDED.

- MECHANICAL PLAN NOTES: (H)
- 1. EXISTING MECHANICAL EQUIPMENT TO REMAIN ALONG WITH ALL ACCESSORIES.
 - 2. NOT USED.
 - 3. NOT USED.

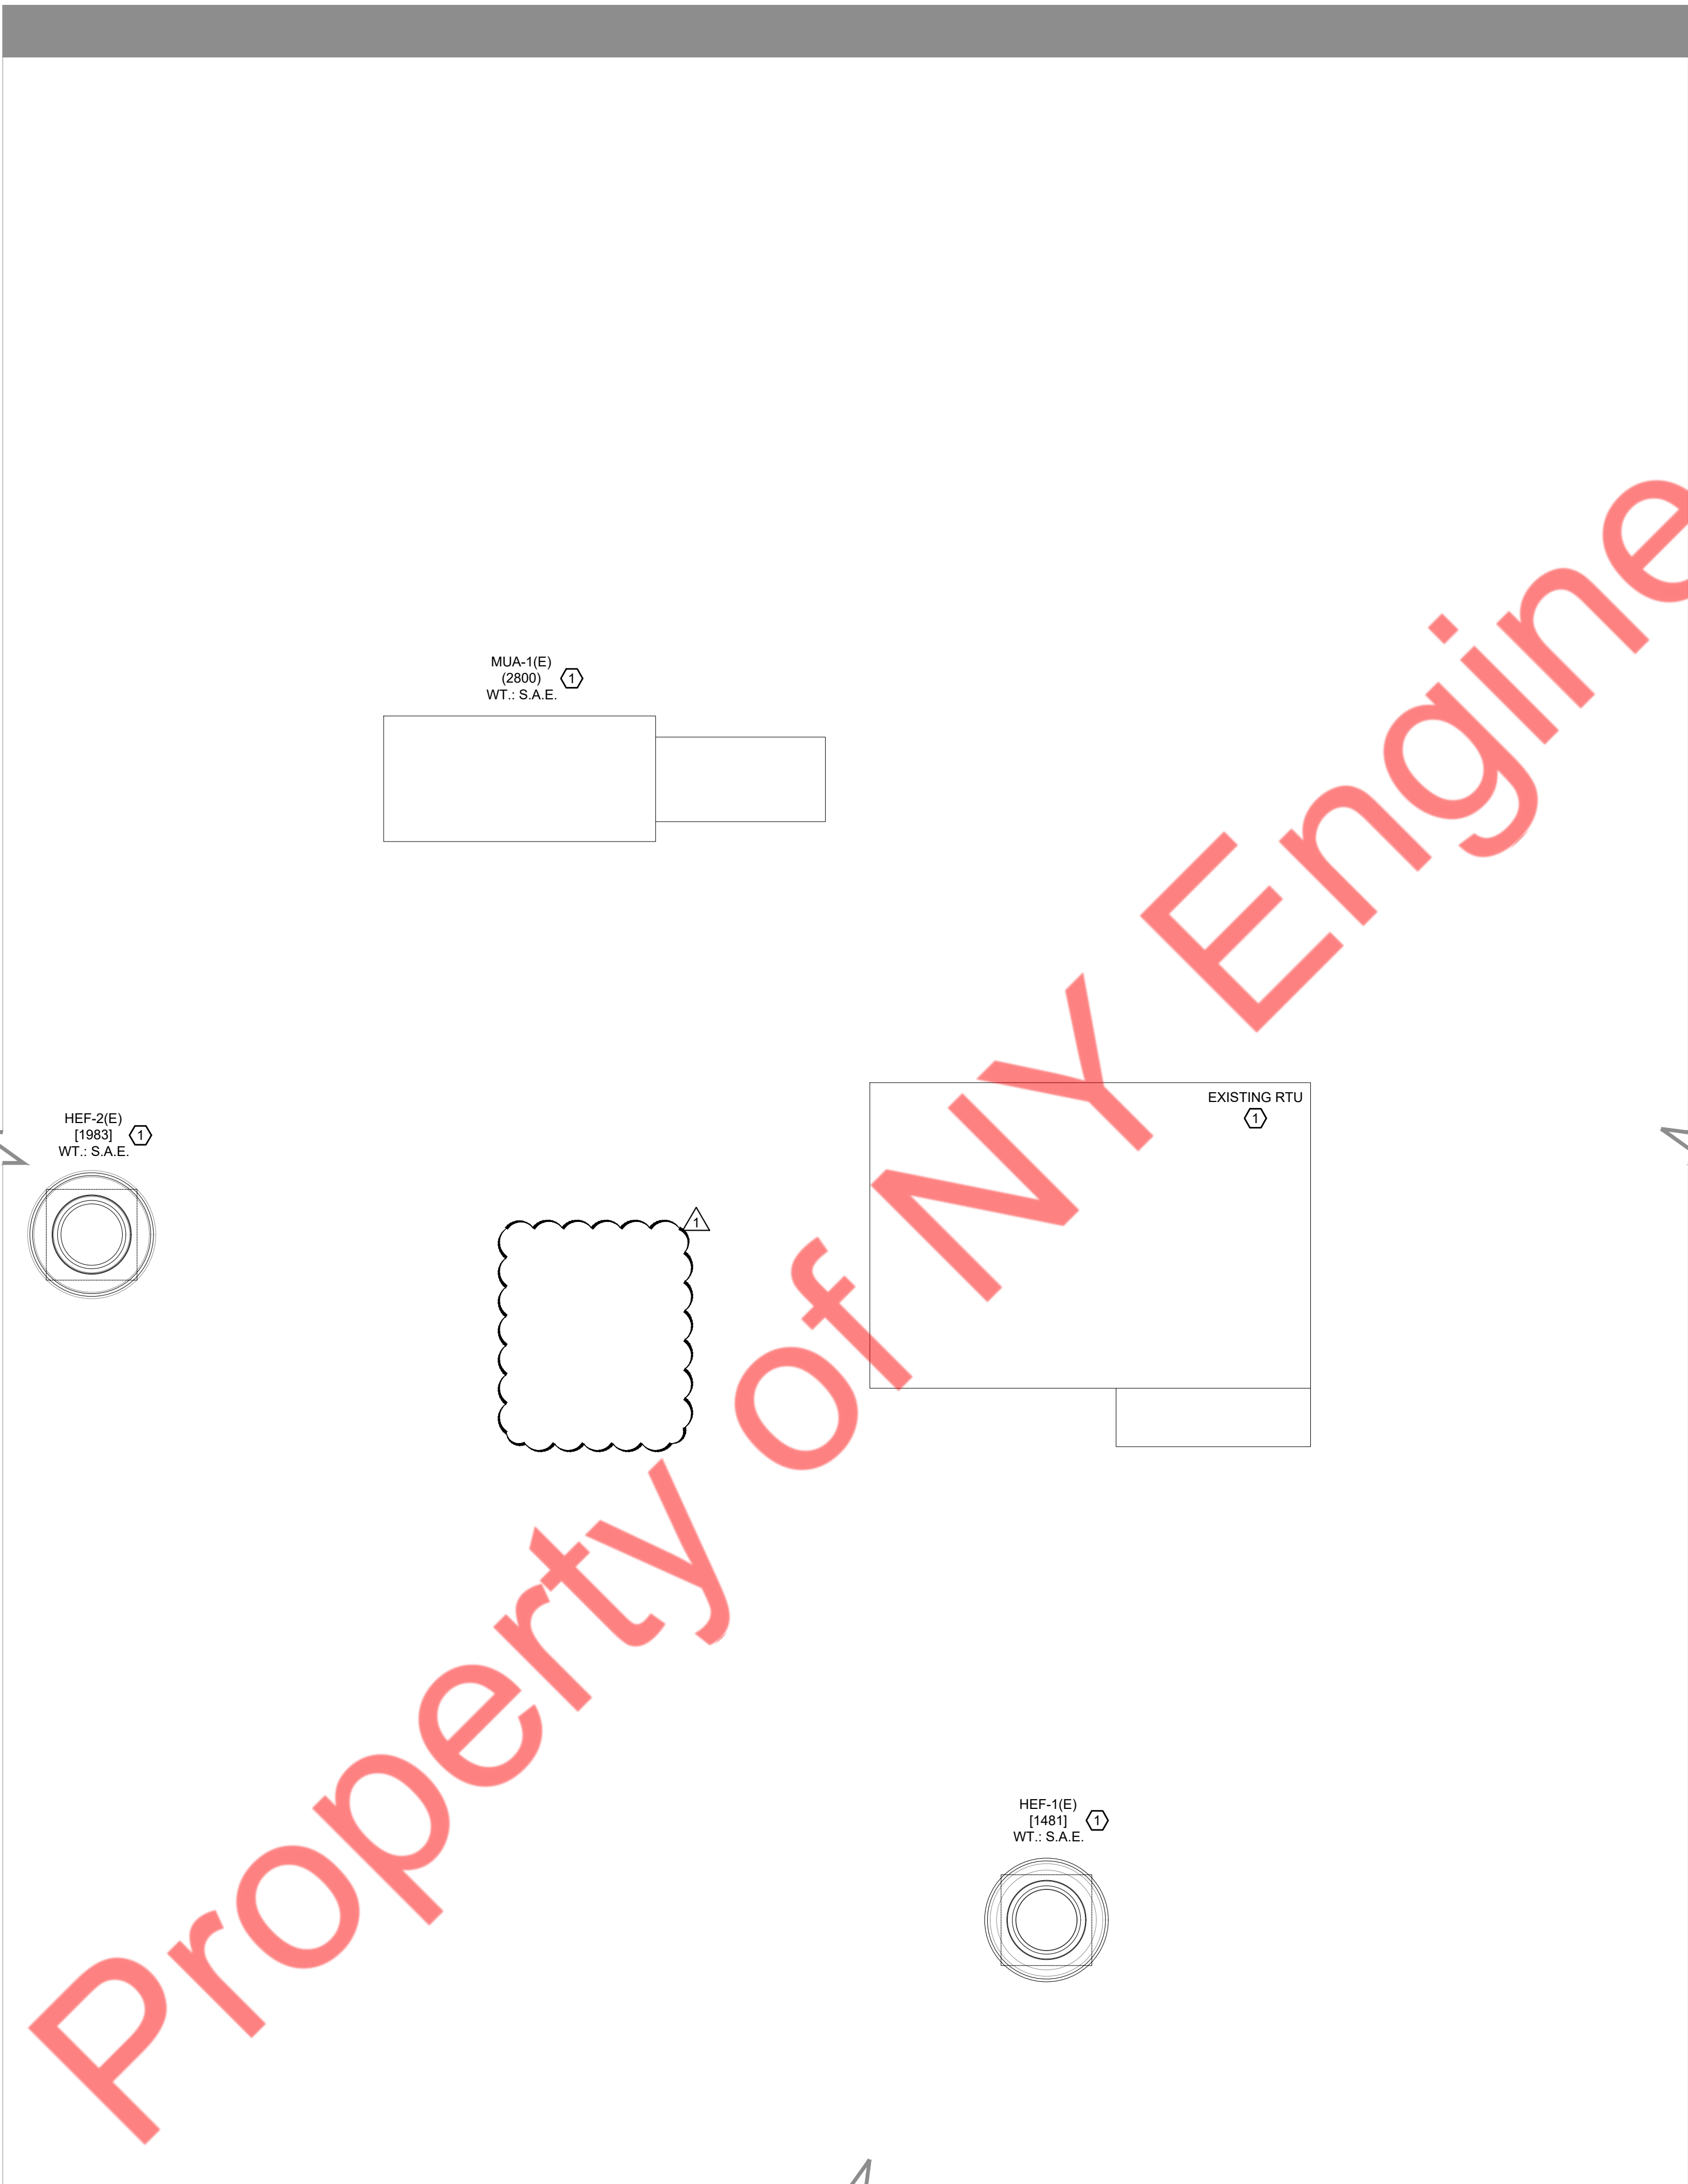


(1) MECHANICAL ROOF PLAN
3/8" = 1'-0"

ISSUE	DESCRIPTION	DATE
00	INITIAL ISSUE	06/23/2025
01	CLIENT REVISION	01/15/2026

 

DOB APPROVAL STAMP:

 

DATE:	06/02/2025
PROJECT NO.:	Z166-24
DRAWN BY:	NYE
CHECKED BY:	NYE
SCALE:	AS NOTED

DRAWING TITLE:
MECHANICAL
ROOF PLAN

DRAWING NO.:
M-101

ELECTRICAL SPECIFICATION

1. GENERAL:
- A. THE "GENERAL CONDITIONS OF THE CONTRACT FOR CONSTRUCTION," AIA DOCUMENT, LATEST EDITION, AND THESE SPECIFICATIONS AS APPLICABLE ARE PART OF THIS CONTRACT.

B. DRAWING ARE DIAGRAMMATIC AND INDICATE GENERAL ARRANGEMENT OF SYSTEMS AND WORK. CONDUIT ROUTING IS SHOWN DIAGRAMMATICALLY AND DOES NOT SHOW ALL OFFSETS, DROPS AND RISES OF RUNS. THE CONTRACTOR SHALL ALLOW IN HIS PRICE FOR ROUTING OF CONDUIT TO AVOID OBSTRUCTIONS. COORDINATION WITH EXISTING SERVICES, INCLUDING THOSE OF OTHER TRADES, IS REQUIRED, MAINTAIN HEADROOM AND SPACE CONDITIONS.

C. BIDDERS, BEFORE SUBMITTING PROPOSALS, SHALL VISIT AND CAREFULLY EXAMINE THE AREA AFFECTED BY THIS WORK TO FAMILIARIZE THEMSELVES WITH THE EXISTING CONDITIONS AND THE DIFFICULTIES THAT WILL ATTEND THE EXECUTION OF THIS WORK. SUBMISSION OF A PROPOSAL WILL BE CONSTRUED AS EVIDENCE THAT SUCH AN EXAMINATION HAS BEEN MADE, AND LATER CLAIMS WILL NOT BE RECOGNIZED FOR EXTRA LABOR, EQUIPMENT, OR MATERIALS, REQUIRED BECAUSE OF DIFFICULTIES ENCOUNTERED WHICH COULD HAVE BEEN FORESEEN HAD SUCH AN EXAMINATION BEEN MADE.

D. INSTALL WORK SO AS TO BE READILY ACCESSIBLE FOR OPERATION, MAINTANANCE AND REPAIR, MINOR DEVIATIONS FROM DRAWING MAY BE MADE TO ACCOMPLISH THIS, BUT CHANGES WHICH INVOLVE EXTRA COST SHALL NOT BE MADE WITHOUT APPROVAL.

E. REMOVAL AND RELOCATION OF CERTAIN EXISTING WORK MAY BE NECESSARY FOR THE PERFORMANCE OF THE GENERAL WORK. ALL EXISTING CONDITIONS CANNOT BE COMPLETELY DETAILED ON THE DRAWINGS. THE CONTRACTOR SHALL SURVEY THE SITE AND INCLUDE ALL CHANGES AND CHARGES IN MAKING UP THE WORK PROPOSAL.

F. CONNECTIONS TO EXISTING WORK: INSTALL NEW WORK AND CONNECT TO EXISTING WORK WITH MINIMUM INTERFERENCE TO EXISTING FACILITIES. TEMPORARY SHUTDOWNS OF EXISTING SERVICES SHALL BE PERFORMED AT NO ADDITIONAL CHARGES. AT TIMES NOT TO INTERFERE WITH NORMAL OPERATION OF EXISTING FACILITIES AND ONLY WITH WRITTEN CONSENT OF OWNER. ALARM AND EMERGENCY SYSTEMS SHALL NOT BE INTERRUPTED. MAINTAIN CONTINUOUS OPERATION OF EXISTING FACILITIES AS REQUIRED WITH NECESSARY TEMPORARY CONNECTIONS BETWEEN NEW AND EXISTING WORK. CONNECT NEW WORK TO EXISTING WORK IN NEAT AND ACCEPTABL MANNER. RESTORE EXISTING DISTURBED WORK TO ORIGINAL CONDITION, INCLUDING MAINTENANCE OF WIRING CONTINUITY AS REQUIRED.

G. DISCONNECT, REMOVE AND/OR RELOCATE EXISTING MATERIAL, EQUIPMENT AND OTHER WORK AS NOTED OR REQUIRED FOR PROPER INSTALLATION OF NEW WORK.

H. THE CONTRACTOR SHALL KEEP ALL EQUIPMENT AND MATERIALS, AND ALL PARTS OF THE BUILDING EXTERIOR SPACES AND ADJACENT STREETS, SIDEWALKS AND PAVEMENTS, FREE FROM MATERIAL AND DEBRIS RESULTING FROM THE EXECUTION OF THIS WORK. EXCESS MATERIALS WILL NOT BE PERMITTED TO ACCUMULATE EITHER ON THE INTERIOR OR THE EXTERIOR.

I. SEAL OPENINGS THROUGH PARTITIONS, WALLS AND FLOORS WITH MINERAL WOOL OR OTHER NONCOMBUSTIBLE MATERIAL, UNLESS OTHERWISE NOTED.

J. PROVIDE ALL NECESSARY FLASHING AND COUNTER FLASHING TO MAINTAIN THE WATERPROOFING INTEGRITY OF THE BUILDING AS REQUIRED BY THE INSTALLATION OR REMOVAL OF CONDUIT AND EQUIPMENT; PROVIDE EQUIPMENT CURBS AS REQUIRED.

K. ALL EXISTING MATERIAL, EQUIPMENT AND CONSTRUCTION DEBRIS TO BE REMOVED UNDER THIS CONTRACT SHALL BECOME THE PROPERTY OF THE CONTRACTOR WITH THE EXCEPTION OF SPECIFIC EQUIPMENT ND APPARATUS REQUESTED BY THE BUILDING REPRESENTATIVE. ARCHITECT OR AS NOTED TO BE RELOCATED ON THE DRAWINGS. REMOVED EQUIPMENT SHALL BE PROPERLY DISPOSED OF BY THIS CONTRACTOR.

L. THE CONTRACTOR'S PROPOSAL FOR ALL WORK SHALL BE PREDICATED ON THE PERFORMANCE OF THE WORK DURING REGULAR WORKING HOURS. WHEN SO DIRECTED, HOWEVER, THE CONTRACTOR SHALL INSTALL WORK DURING OVERTIME HOURS AND THE ADDITIONAL COST TO BE CHARGED THEREFORE SHALL BE ONLY THE "PREMIUM" PORTION OF THE WAGES PAID.

M. UNLESS OTHERWISE SPECIFICALLY NOTED OR SPECIFIED, INCLUDE ALL CUTTING AND PATCHING OF EXISTING FLOORS, WALLS, PARTITIONS AND OTHER MATERIALS IN THE EXISTING BUILDING. THE CONTRACTOR SHALL RESTORE THESE AREAS TO ORIGINAL CONDITIOIN.

N. ALL MATERIAL AND EQUIPMENT SHALL BE NEW UNLESS OTHERWISE NOTED AND SHALL BE IN ACCORDANCE WITH BUILDING STANDARDS.

O. INSURANCE: PROVIDE IN ACCORDANCE WITH OWNER/BUILDING REQUIREMENTS AND SHALL INCLUDE A HOLD HARMLESS CLAUSE FOR OWNER AND ENGINEER.

P. THE FINAL ACCEPTANCE SHALL BE MADE AFTER THE CONTRACTOR HAS ADJUSTED HIS EQUIPMENT, TESTED THE VARIOUS SYSTEMS, DEMONSTRATED THAT IT FULFILLS THE REQUIREMENTS OF THE DRAWINGS AND SPECIFICATIONS AND HAS FURNISHED ALL THE REQUIRED CERTIFICATED OF INSPECTION AND APPROVAL.
2. 2. GENERAL PROVISIONS FOR ELECTRICAL WORK:
- A. DEFINITIONS:
- 1) "PROVIDE": TO FURNISH, INSTALL AND CONNECT UP COMPLETE AND READY FOR SAFE AND REGULAR OPERATION THE PARTICULAR WORK REFERRED TO UNLESS SPECIFICALLY OTHERWISE NOTED.

2) "INSTALL": TO ERECT, MOUNT AND CONNECT COMPLETE WITH RELATED ACCESSORIES.

3) "FURNISH" OR "SUPPLY": TO PURCHASE, PROCURE, ACQUIRE, AND DELIVER COMPLETE WITH RELATED ACCESSORIES.

4) "WORK": LABOR, MATERIALS, EQUIPMENT, APPARATUS, CONTROLS, ACCESSORIES AND OTHER ITEMS REQUIRED FOR PROPER AND COMPLETE INSTALLATION.

5) "WIRING": RACEWAY, FITTINGS, WIRE, BOXES, AND RELATED ITEMS.

6) "CONCEALED": EMBEDDED IN MASONRY OR OTHER CONSTRUCTION, INSTALLED IN FURRED SPACES, WITHIN DOUBLE PARTITIONS OR HUNG CEILINGS, IN TRENCHES, IN CRAWL SPACES, OR IN ENCLOSURES

7) "EXPOSED": NOT INSTALLED UNDERGROUND OR "CONCEALED" AS DEFINED ABOVE.

- 8) "SIMILAR" OR "EQUAL": EQUAL IN MATERIALS, WEIGHT, SIZE, DESIGN AND EFFICIENCY OF SPECIFIED PRODUCT.
- B. TEMPORARY LIGHT AND POWER: PROVIDE TEMPORARY LIGHT AND POWER SYSTEMS AT EARLIEST POSSIBLE DATE WITHIN THE CONSTRUCTION AREAS FOR THE REQUIREMENTS OF ALL TRADES AS HEREIN DESCRIBED. EXTEND SYSTEMS TO NEW CONSTRUCTION AS SOON AS PHYSICALLY POSSIBLE. MAINTAIN SYSTEM DURING WORKING OWNER. PROVIDE ALL REQUIRED MAINTENANCE, INCLUDING LAMPS AND SOCKETS.
- C. QUALITY ASSURANCE
- 1) QUALITY OF MATERIALS: ALL EQUIPMENT SHALL BE NEW SPECIFICATION GRADE, FREE FROM DEFECTS AND LISTED BY APPROVED TESTING AGENCY AND BEARING THEIR LABEL MATERIALS AND EQUIPMENT OF SIMILAR APPLICATION SHALL BE OF SAME MANUFACTURER, EXCEPT AS NOTED.

2) GUARANTEE: ALL MATERIALS AND WORKMANSHIP SHALL BE GUARANTEED AS DEFINED IN PARAGRAPH 2.C.

3) CURRENT CHARACTERISTICS:

a. SERVICE: 120/208 VOLT, 3 PHASE, 4 WIRE, 60 HERTZ WITH GROUNDED NEUTRAL.

4) HEIGHTS OF OUTLETS:

a. FROM FINISHED FLOOR TO CENTERLINE OF OUTLETS FOR:

- RECEPTACLES AND TELEPHONES: 1 FT-6 IN.

- WALL SWITCHES: 4 FT-0 IN.

- WALL FIXTURES: 7 FT-0 IN.

- MOTOR CONTROLLERS: 5 FT-0 IN.

- CLOCKS: 7 FT 6 IN

b. EXCEPTIONS: AT JUNCTION OF DIFFERENT WALL FINISH MATERIALS, ON MOLDING OR BREAK IN WALL SURFACE, IN VIOLATION OF CODE, OR AS NOTED OR DIRECTED.
- D. PRODUCT DELIVERY, STORAGE AND HANDLING
- 1) MOVING OF EQUIPMENT: WHERE NECESSARY, SHIP IN CARTED SECTIONS OF SIZE TO PERMIT PASSING THROUGH AVAILABLE SPACES.

2) ACCESSIBILITY: FOR OPERATION, MAINTENANCE AND REPAIR, MINOR DEVIATIONS SHALL BE PERMITTED, CHANGES OF MAGNITUDE OR INVOLVING EXTRA COST ARE NOT PERMISSIBLE WITHOUT REVIEW. GROUP CONCEALED ELECTRICAL EQUIPMENT REQUIRING ACCESS WITH EQUIPMENT FREELY ACCESSIBLE THROUGH ACCESS DOORS.
- E. MATERIALS
- 1) NAMEPLATES: PROVIDE BLACK LAMICOID SHEET WITH 3/4 IN. WHITE LETTERING, FASTENED WITH EPOXY CEMENT FOR EACH DISCONNECT SWITCH, CIRCUIT BREAKER, PANEL, CABINET, TRANSFORMER, ENCLOSURE, MOTOR CONTROLLER AND THE LIKE. NAMEPLATES SHALL DESCRIBE THE NAME AND NUMBER OF EACH COMPONENT.

2) CABLE TAGS: TAG EACH CONDUCTOR PASSING THROUGH SPLICE OR PULLBOX WITH A WHITE LINEN TAG, INDICATING POINT OF ORIGIN AND TERMINATION OF THE CIRCUIT.

3) INSERTS AND SUPPORTS:

a. INSERTS: STEEL, SLOTTED TYPE, FACTORY PAINTED.

- SINGLE ROD: SIMILAR TO GRINNELL FIG. 281.

- MULTI-ROD: SIMILAR TO FEE AND MASON SERIES 9000 WITH END CAPS AND CLOSURE STRIPS.

- CLIP FORM NAILS FLUSH WITH INSERTS.

- MAXIMUM LOADING 75 PERCENT OF RATING.

b. SUPPORTS FROM BUILDING CONSTRUCTION: INSERTS, BEAM CLAMPS, STEEL FISHPLATES (IN CONCRETE FILL ONLY), CANTILEVER BRACKETS OR OTHER MEANS. SUBMIT FOR REVIEW.
- C. GROUPED LINES AND SERVICES: TRAPEZE HANGERS OF BOLTED ANGLES OR CHANNELS.
- D. WHERE BUILDING CONSTRUCTION IS INADEQUATE: PROVIDE ADDITIONAL FRAMING. SUBMIT FOR REVIEW.
- F. PAINT SHALL BE THE BEST GRADE FOR ITS PURPOSE. DELIVER INORIGINAL SEALED CONTAINERS AND APPLY IN ACCORDANCE WITH MANUFACTURER'S INSTRUCTIONS. COLORS SHALL BE AS SELECTED BY ARCHITECT OR ENGINEER. UTILIZE GALVANIZED IRON PRIMER ON PANEL AND PULL BOXES, AFTER FABRICATION. UTILIZE HOT DIPPED GALVANIZED OR DIPPED IN ZINC BASED PRIMER FOR: OUTLET BOXES, JUNCTION BOXES, CONDUIT HANGERS, RODS, INSERTS AND SUPPORTS. ZINC BASED PRIMER WITH FINISH TO MATCH BRUSH AND CLEAN WORK PRIOR TO CONCEALING, PAINTING AND ACCEPTANCE. PAINTED EXPOSED WORK SOILED OR DAMAGED, CLEAN AND REPAIR TO MATCH ADJOINING WORK BEFORE FINAL ACCEPTANCE. REMOVE DEBRIS FROM INSIDE AND OUTSIDE OF MATERIAL AND EQUIPMENT.
- G. FINAL LOCATIONS AND MOUNTING ORIENTATIONS OF ALL SWITCHES, RECEPTACLES AND LIGHT FIXTURES SHALL BE VERIFIED WITH ARCHITECT.
- H. ALL ACCESS DOOR LOCATIONS SHALL BE REVIEWED BY ARCHITECT PRIOR TO INSTALLATION.
3. SCOPE OF WORK:
- A. SCOPE OF WORK SHALL CONSIST OF PROVIDING LABOR, MATERIALS, EQUIPMENT, SERVICES AND FEES NECESSARY FOR COMPLETE AND SAFE INSTALLATION IN CONFORMING WITH THE 2020 NATIONAL ELECTRIC CODE (NEC) WITH LOCAL ADOPTIONS, AND ALL OTHER APPLICABLE INDUSTRY, NATIONAL AND LOCAL CODES AND AUTHORITIES HAVING JURISDICTION, AS INDICATED ON DRAWINGS AND HEREIN SPECIFIED.
- B. ALL DRAWINGS, PLANS, DETAILS, SPECIFICATIONS AND SPECIFICATION ADDENDA ARE MADE PART OF THIS CONTRACT AND SHALL APPLY TO ALL WORK UNDER THE CONTRACT UNLESS OTHERWISE AMENDED, MODIFIED, SUPPLIED OR SPECIFIED HEREIN.
- C. THE CONTRACTOR SHALL FURNISH A WRITTEN GUARANTEE TO REPLACE OR REPAIR PROMPTLY AND ASSUME RESPONSIBILITY FOR ALL EXPENSES INCURRED FOR ANY WORKMANSHIP AND EQUIPMENT IN WHICH DEFECTS DEVELOP WITHIN ONE YEAR FROM THE DATE OF FINAL CERTIFICATE FOR PAYMENT AND/OR FROM DATE OF ACTUAL USE OF EQUIPMENT OR OCCUPANCY OF SPACES BY OWNER INCLUDED UNDER THE VARIOUS PARTS OF THE WORK, WHICHEVER, DATE IS EARLIER, THIS WORK SHALL BE DONE AS DIRECTED BY THE OWNER. THIS GUARANTEE SHALL ALSO PROVIDED THAT WHERE DEFECTS OCCUR, THE CONTRACTOR WILL ASSUME RESPONSIBILITY OF OTHER TRADES AFFECTED BY DEFECTS, REPAIRS OR

- REPLACEMENTS IN EQUIPMENT SUPPLIED BY THE CONTRACTOR.
- D. THE CONTRACTOR SHALL GIVE NECESSARY NOTICE, FILE DRAWINGS AND SPECIFICATIONS WITH ALL DEPARTMENTS HAVING JURISDICTION, WORK AND PAY ALL FEES THEREFORE. THE CONTRACTOR SHALL ARRANGE FOR INSPECTION AND TESTS OF ANY OR ALL PARTS OF THE WORK IF SO REQUIRED BY AUTHORITIES AND PAY ALL CHARGES FOR SAME. THE CONTRACTOR SHALL PAY ALL COSTS FOR, AND FURNISH TO THE OWNER BEFORE FINAL BILLING, ALL CERTIFICATES NECESSARY AS EVIDENCE THAT THE WORK INSTALLED CONFORMS WITH ALL REGULATIONS WHERE THEY APPLY TO THIS WORK.
- E. CONTRACTOR SHALL PERFORM ALL CONTROLLED INSPECTIONS IN ACCORDANCE WITH THE BUILDING CODE. SECURE ALL REQUIRED PERMITS AND APPROVALS AND TRANSMIT SAME TO OWNER. CONTRACTOR SHALL BE RESPONSIBLE FOR ALL FEES.
- F. AREAS WITH NO ELECTRICAL WORK SHALL REMAIN AS IS. CONTRACTOR SHALL MAINTAIN CONTINUITY OF ALL ELECTRICAL SYSTEMS TO ALL AREAS NOT COVERED BY THIS RENOVATION AND SHALL PROVIDE 48 HOUR NOTICE TO LANDLORD OF ANY PLANNED POWER INTERRUPTIONS OR SIGNAL SYSTEM OUTAGES.
4. SHOP DRAWINGS
- A. PRIOR TO THE INSTALLATION OF ANY WORK AND PROCUREMENT OF EQUIPMENT, CONTRACTOR SHALL PROVIDE COMPLETE SETS OF COORDINATED SHOP DRAWINGS OF ALL NEW AND EXISTING EQUIPMENT, INDICATING CAPACITY, DIMENSIONS AND SEQUENCE OF OPERATION FOR WRITTEN APPROVAL BY THE ARCHITECT AND ENGINEER.
- B. INDICATE ON EACH SHOP DRAWINGS SUBMITTED:
- 1) PROJECT NAME AND LOCATION

2) NAME OF ARCHITECT AND ENGINEER

3) ITEM IDENTIFICATION

4) APPROVAL STAMP OF PRIME CONTRACTOR
- C. SUBMISSIONS:
- 1) SUBMISSIONS 11 IN. X 17 IN. OR SMALLER: IF THE SUBMISSION IS A CATALOG CUT, THEN THE CONTRACTOR SHALL SUBMIT ONE ORIGINAL AND TWO COPIES, OTHERWISE, HE SHALL SUBMIT THREE COPIES. THE ARCHITECT WILL FORWARD THE ORIGINAL AND ONE COPY (TWO COPIES WHEN NO ORIGINAL IS RECEIVED) TO THE ENGINEER. ALL CATALOG CUTS SHALL BE COMPLETE.

2) SUBMISSIONS LARGER THAN 11 IN. X 17 IN.: SUBMIT TWO PRINTS AND ONE PAPER SEPIA TO THE ARCHITECT. THE ARCHITECT WILL FORWARD ONE PRINT AND THE PAPER SEPIA TO THE ENGINEER.
- D. SUBMIT SHOP DRAWINGS FOR THE FOLLOWING:
- 1) SAFETY/DISCONNECT SWITCHES

2) FUSES

3) CIRCUIT BREAKERS

4) PANELBOARDS/LOADCENTER (INCLUDING DIMENSIONS, SCHEDULES, AND CATALOG CUTS).

5) RACEWAYS

6) WIRE AND CABLE

7) WALL SWITCHES

8) INSERTION RECEPTACLES

9) MOMENTARY CONTACT SWITCHES

10) TIME SWITCHES

11) LIGHTING FIXTURES.

12) TRANSFORMER.
- E. ASSIST AND PROVIDE ALL NECESSARY INFORMATION, DIAGRAMS, SKETCHES, ETC. TO THE HVAC CONTRACTOR FOR THE PREPARATION OF COORDINATED SHOP DRAWINGS INDICATING ROUTING OF FEEDERS, CONTROL CONDUITS, RECESSED FIXTURES AND ADJACENT NEARBY PIPING AND DUCTWORK WHERE APPLICABLE, CERTIFIED BY ALL TRADES THAT COORDINATION HAS BEEN ESTABLISHED. SUBMIT FOUR(4) BOOKBOUND OPERATING AND SERVICE MANUALS WHICH SHALL INCLUDE COPIES OF ALL SHOP DRAWING, PROVIDE SHOP DRAWINGS FOR PANELS, FIXTURES, WIRING DEVICES, CONDUIT, CABLE, DISCONNECT SWITCH, RELAYS, CONTRACTORS, AND OTHER SYSTEMS AS DIRECTED BY THE ENGINEER.
5. AS-BUILT DRAWINGS AND EQUIPMENT OPERATIONAL INSTRUCTIONS
- A. UPON COMPLETION AND ACCEPTANCE OF WORK, CONTRACTOR SHALL FURNISH WRITTEN INSTRUCTIONS AND EQUIPMENT MANUALS AND DEMONSTRATE TO THE OWNER THE PROPER OPERATION AND MAINTENANCE OF ALL EQUIPMENT AND APPARATUS FURNISHED UNDER THIS CONTRACT.
- B. THESE INSTRUCTIONS SHALL BE TYPED ON 8-1/2 IN. X 11 IN. PAPER A BOUND IN THREE RING BINDERS WITH CLEAR ACETATE COVERS. CONTRACTOR SHALL GIVE THREE COPIES OF THE INSTRUCTIONS TO THE OWNER AND ONE COPY TO THE ENGINEER.
- C. THE INSTRUCTION BOOKLET SHALL BEAR THE NAME, ADDRESS AND TELEPHONE NUMBER OF THE PROJECT, ARCHITECT AND ENGINEER.
- D. REPRODUCIBLE "AS-BUILT" DRAWINGS SHALL BE PROVIDED INDICATING THE AS INSTALLED CONDITIONS OF THE WORK. "AS-BUILT" DRAWINGS SHALL BE PROVIDED TO THE ARCHITECT AFTER COMPLETION OF THE INSTALLATION.
6. LOW-VOLTAGE DISTRIBUTION EQUIPMENT:
- A. PROVIDE COMPLETE EQUIPMENT INCLUDING: SWITCHES, FUSES, CIRCUIT BREAKERS, PANELS AND TRANSFORMERS.
- B. ALL EQUIPMENT SHALL CONFORM TO NEMA, ANSI AND IEEE STANDARDS.
- C. DISCONNECT SWITCHES SHALL BE FUSED OR NONFUSED AS NOTED. VOLTAGE SHALL BE AS REQUIRED, SWITCHES SHALL BE HEAVY DUTY, EXCEPT AS NOTED, AND HORSEPOWER RATED FOR MOTOR LOADS. TOGGLE TYPE SWITCHES SHALL BE NONFUSED, LOAD BREAK, HAVING MAXIMUM RATINGS OF 20 AMP AT 600 VOLTS AND 30 AMP AT 240 VOLTS. TWO-POLE SWITCHES SHALL BE SIMILAR TO HART AND HEGEMAN NO. 6808F. THREE-POLE SWITCHES SHALL BE SIMILAR TO HART AND HEGEMAN NO. 7810F. KNIFE-BLADE TYPE SWITCHES SHALL BE LOAD BREAK, QUICK-MAKE, QUICK-BREAK, UL CLASS R UP TO 600 AMP. MAXIMUM RATING EXCEPT AS NOTED SHALL BE 800 AMP. ARC QUENCHERS SHALL BE PROVIDED. SWITCHES SHALL BE SIMILAR TO GENERAL ELECTRIC QMR. ALL SWITCH ENCLOSURES SHALL BE DEAD FRONT, NEMA TYPE 1, EXCEPT AS NOTED.

7. FUSES:
- A. CIRCUITS 0 TO 600 AMPERES SHALL BE PROTECTED BY FUSES SIMILAR TO CURRENT LIMITING BUSSMAN LOW-PEAK DUAL-ELEMENT TIME-DELAY LPN-RK (AMP)SP (250V) /LPS-RK (AMP)SP (600V) OR LPJ (AMP)SP (600V) (UL CLASS RK1 OR CLASS J), AND BE LISTED BY UL WITH AN INTERRUPTING RATING OF 300,000 AMPERES RMS SYMMETRICAL.
- B. MOTOR CIRCUITS - ALL INDIVIDUAL MOTOR CIRCUITS WITH FULLLOAD AMPERE RATINGS (FLA) OF 480 AMPERES OR LESS SHALL BE PROTECTED BY FUSES SIMILAR TO CURRENT LIMITINGBUSSMANN LOW-PEAK DUAL-ELEMENT TIME-DELAY LPN-RK (AMP)SP (250V) /LPS-RK (AMP)SP (600V) OR LPJ (AMP)SP (600V) (UL CLASS RK1 OR CLASS J), AND BE LISTED BY UL WITH AN INTERRUPTING RATING OF 300,000 AMPERES RMS SYMMETRICAL.
- C. ALL FUSES SHALL BE PROVIDED BY SAME MANUFACTURER.
- D. PROVIDE 1 SPACE MATCHING FUSE FOR EACH SET OF 3.
- E. CIRCUIT BREAKERS: MOLDED CASE BREAKERS SHALL BE THERMAL-MAGNETIC, QUICK-MAKE-QUICK-BREAK, BOLT-ON TYPE, MANUALLY OPERATED WITH INSULATED TRIP-FREE HANDLE. MULTI-POLE TYPE BREAKERS SHALL CONTAIN INTERNAL TRIP BAR. TERMINALS SHALL BE SUITABLE FOR COPPER OR ALUMINUM CABLE. FURNISH AUXILIARY DEVICES WHERE REQUIRED FOR SHUNT-TRIPPING, OPEN AND CLOSE MOTOR OPERATOR AND ALARM INDICATION. ENCLOSURES SHALL BE DEAD FRONT, NEMA TYPE 1, EXCEPT AS NOTED. FRAMES, IC AND INTERCHANGEABLE TRIPS SHALL BE AS FOLLOWS, UNLESS OTHERWISE NOTED:

1) 120 VOLTS, 100-AMP FRAME: 10,000 AMPS, 1 POLE.

2) 120/240 VOLTS, 225-AMP FRAME: 22,000 AMPS MINIMUM
8. DISTRIBUTION PANELBOARDS, CIRCUIT BREAKER TYPE:
- A. THREE PHASE, 4 OR 5 WIRE, COPPER BUS BARS, WITH 2, 3, OR 4 WIRE BRANCHES, AS NOTED. CAPACITY OF PANEL AND CIRCUITS, AS NOTED BELOW, PANELBOARD TO HAVE GROUND BUS SAME SIZE AS PHASE BUSES.
- B. CABINETS: CODE GAUGE GALVANIZED SHEET STEEL PRIMED AND PAINTED WITH TRIM AND DOOR, TYPE AS NOTED, LAP AND RIVET CORNERS OR FORM AS APPROVED.
- C. TRIM: ONE PIECE FULL FINISH PRIMED AND PAINTED SHEET STEEL. TRIM SHALL BE MOUNTED WITH A CONTINUOUS PIANO HINGE CONFIGURED IN SUCH A MANNER THAT IT SHALL BE POSSIBLE TO GAIN FULL ACCESS TO CIRCUIT BREAKERS AND WIRING GUTTERS WITHOUT REMOVING THE TRIM. PROVIDE A MULTI-PIN CYLINDER LOCK (YALE, CORBIN OR EQUAL) TO LATCH THE TRIM. KEYS SHALL BE MILLED.
- D. HARDWARE: MULTI-PIN, CYLINDER LOCKS WITH MILLED KEYS. ALL PANELS SHALL BE KEVED ALIKE. DOOR OVER 48" HIGH SHALL BE EQUIPPED WITH A CHROME PLATED VAULT HANDLE, BUILT-IN LOCK AND 3-POINT CATCH FASTENING DOOR AT TOP, BOTTOM AND CENTER.
- E. HINGES: CONCEALED, CONTINUOUS PIANO HINGE AS DESCRIBED ABOVE.
- F. DIRECTORY HOLDER: MEAL FRAME WITH NONBREAKABLE TRANSPARENT COVER AND DIRECTORY CARD. ENTRIES TO BE TYPEWRITTEN BY ELECTRICAL CONTRACTOR. PROVIDE AN ENGRAVED LAMINATED NAMEPLATE ADJACENT TO EACH BRANCH BREAKER. MOUNT WITH SELF TAPPING MACHINE SCREWS.
- G. FURNISH MULTI-CABLE LUGS WHERE REQUIRED. DOUBLE LUGGING NOT PERMITTED. SECURE LUGS TO BUS BY STUD BOLTS.
- H. PANELBOARD CONSTRUCTION FOR BOLTED TYPE BREAKERS. MINIMUM SHORT CIRCUIT RATING 25,000 AMPERES, RMS SYMMETRICAL FOR ALL 120/208V APPLICATIONS. INDIVIDUAL CIRCUIT BREAKERS SHALL HAVE MINIMUM 100A FRAME, TRIPS SIZED AS SHOW ON THE PLANS.
- I. MINIMUM GUTTER SPACES: PANELS WITH 225 AMPERE MAINS, 5-3/4" MINIMUM, 400 AMPERES AND OVER, MINIMUM GUTTERS 8", FOR PANELS WITH THROUGH FEEDERS, INCREASE GUTTER WIDTH BY 2" MINIMUM AND PROVIDE A SHEET STEEL BARRIER BETWEEN THE PANEL GUTTER AND THE THROUGH FEEDER PORTION OF THE BACK BOX. BRANCH CIRCUIT BREAKERS SHALL BE MECHANICALLY INTERLOCKED WHEN SHOWN ON DRAWINGS.
- J. DISTRIBUTION AND SUB-DISTRIBUTION PANELBOARDS SHALL BE A MINIMUM OF 30" WIDE AND 10" DEEP.
- K. PANELBOARD SHALL HAVE MAIN CIRCUIT BREAKER OR MAIN LUGS AS INDICATED ON THE DRAWINGS. QUANTITY, POLES AND TRIP RATINGS OF BRANCH CIRCUIT BREAKERS TO BE AS INDICATED ON DRAWINGS.
- L. PANELBOARD SHALL HAVE ENGRAVED WHITE CORE, BLACK LAMACOID NAMEPLATE SCREWED ONTO PANE TRIM WITH DESIGNATION LISTED (PANELBOARD NAME, VOLTAGE, RATING OR MAINS IN AMPS).
9. DISTRIBUTION PANELBOARDS, SWITCH AND FUSE:
- A. THREE PHASE, 3 OR 4 WIRE WITH COPPER BUS BARS. ALL THROUGH BUS SHALL BE INSULATED.
- B. NEMA CLASS 1 CONSTRUCTION TO ACCOMMODATE FUSIBLE, INDIVIDUALLY ENCLOSED SWITCHES, FRONT REMOVABLE, SWITCH AND DOOR INTERLOCKS. COVERS TO BE PAD-LOCKABLE.
- C. PANELBOARD SHALL BE CONSTRUCTED OF CODE-GAUGE STEEL, GRAY FINISH OVER RUST INHIBITOR, FOR SURFACE MOUNTING. BOX AND PANEL FRAME SHALL BE FLANGED AND REINFORCED FOR RIGID SUPPORT OF INTERIOR AND ACCURATE ALIGNMENT OF INTERIOR WITH FRONT. TRIMS TO BE FASTENED TO BACK BOX WITH SCREWS.
- D. ALL BRANCH SWITCHES SHALL HAVE INDIVIDUAL ENGRAVED LAMICOID NAMEPLATES (BLACK WITH WHITE CORE).
- E. DISTRIBUTION PANELBOARD CONSTRUCTION MINIMUM SHORT CIRCUIT RATING 25,000 AMPERES, REMS SYMMETRICAL FOR ALL 120/208V APPLICATIONS. APPLICATIONS.
- F. DISCONNECTS
- 1) DISCONNECT SWITCHES SHALL CONFORM TO NEMA AND UL STANDARDS, AND SHALL BE HORSEPOWER RATED.

2) SWITCHING MECHANISM SHALL BE QUICK-MAKE, QUICK-BREAK, SINGLE THROW WITH EXTERNAL OPERATING HANDLE MECHANICALLY INTERLOCKED WITH ENCLOSURE COVER TO PROVIDE ACCESS TO INTERIOR WHEN DISCONNECT IS IN OFF POSITION ONLY. PROVIDE MEANS TO LOCK OPERATING HANDLE IN THE OPEN AND CLOSED POSITION. DESIGNATE ON THE ENCLOSURE THE OPEN AND CLOSED POSITION OF THE OPERATING HANDLE.

3) SWITCHES SHALL BE OF THE DOUBLE STATIONARY CONTACT TYPE.

4) SWITCHES SHALL BE EQUIPPED WITH REJECTION TYPE FUSE HOLDERS, FUSIBLE AS SHOWN ON THE DRAWINGS, PROVIDE COMPLETE WITH FUSES AS SCHEDULED.

DOB APPROVAL STAMP:

DATE: 06/02/2025
PROJECT NO.: Z166-24
DRAWN BY: NYE
CHECKED BY: NYE
SCALE: AS NOTED

DRAWING TITLE:

ELECTRICAL SPECIFICATIONS
(1 OF 2)

DRAWING NO.:


E-002

LIGHTING PLAN GENERAL NOTES:

1. CONTRACTOR IS ADVISED THAT ADJUSTMENTS TO EMERGENCY AND EXIT LIGHT FIXTURE LOCATIONS/QUANTITIES MAY BE REQUIRED BY AHJ UPON FINAL INSPECTION.
2. E.C. TO UPDATE CIRCUIT NUMBERS IF REQUIRED.
3. E.C. TO COORDINATE WITH ARCHITECT/OWNER FOR EXISTING CONDITION IN FIELD.
4. E.C. SHALL VERIFY ALL THE EXISTING CONNECTION IN FIELD. INFORM ENGINEER FOR ANY DISCREPANCY FOUND.
5. E.C. TO VERIFY THE OPERABLE CONDITION OF EXISTING LIGHTING FIXTURE AND LIGHTING CONTROL IN FIELD. E.C. TO ENSURE THAT EXISTING LIGHTING CONTROL IS COMPLYING WITH ASHRAE 90.1-2019 CODE REQUIREMENTS. UPDATE/PROVIDE NEW CONTROLS AS REQUIRED IF EXISTING CONTROLS NOT OPERABLE/NOT COMPLYING PER LOCAL CODE REQUIREMENT. BASE BID ACCORDINGLY.
6. E.C. TO VERIFY THE CIRCUIT NUMBERS FOR ALL EXISTING & NEWLY ADDED LIGHTING FIXTURE AS PER FIELD CONDITION OF PANEL BOARD.
7. THE HATCHING AREA'S LIGHT FIXTURE, LIGHTING CONTROL & ITS ELECTRICAL CONNECTION SHALL REMAIN. E.C. SHALL VERIFY THE OPERABLE CONDITION OF EXISTING LIGHT FIXTURE, LIGHTING CONTROL & ITS ELECTRICAL CONNECTION IN FIELD. REPLACE IF FOUND INOPERABLE. BASE BID ACCORDINGLY.
8. LIGHTING FIXTURES SUPPLIED BY CANOPY MANUFACTURER. ELECTRICAL CONTRACTOR TO INSTALL AND CONNECT FIXTURES.

LIGHTING PLAN KEY NOTES: (#)

1. EXISTING LIGHT FIXTURE, LIGHTING CONTROL AND ITS ELECTRICAL CONNECTION SHALL REMAIN. E.C. SHALL VERIFY THE OPERABLE CONDITION OF EXISTING LIGHT FIXTURE & IT'S ELECTRICAL CONNECTION IN FIELD. REPLACE IF FOUND IN OPERABLE. BASE BID ACCORDINGLY.
2. EXISTING CAMERA AND ITS ELECTRICAL CONNECTION SHALL REMAIN. E.C. SHALL VERIFY THE OPERABLE CONDITION OF EXISTING CAMERA & IT'S ELECTRICAL CONNECTION IN FIELD. REPLACE IF FOUND IN OPERABLE. BASE BID ACCORDINGLY.
3. RELOCATE THE EXISTING CAMERA, ASSOCIATE WIRING, JUNCTION BOX, ELECTRICAL CONNECTION TO THE NEW LOCATION AS INDICATED IN PLAN. BASE BID ACCORDINGLY.
4. EXISTING CHICK-FIL-A SIGNAGE AND ITS ELECTRICAL CONNECTION SHALL REMAIN. E.C. SHALL VERIFY THE OPERABLE CONDITION OF EXISTING CHICK-FIL-A SIGNAGE & IT'S ELECTRICAL CONNECTION IN FIELD. REPLACE IF FOUND IN OPERABLE. BASE BID ACCORDINGLY.
5. NOT USED.

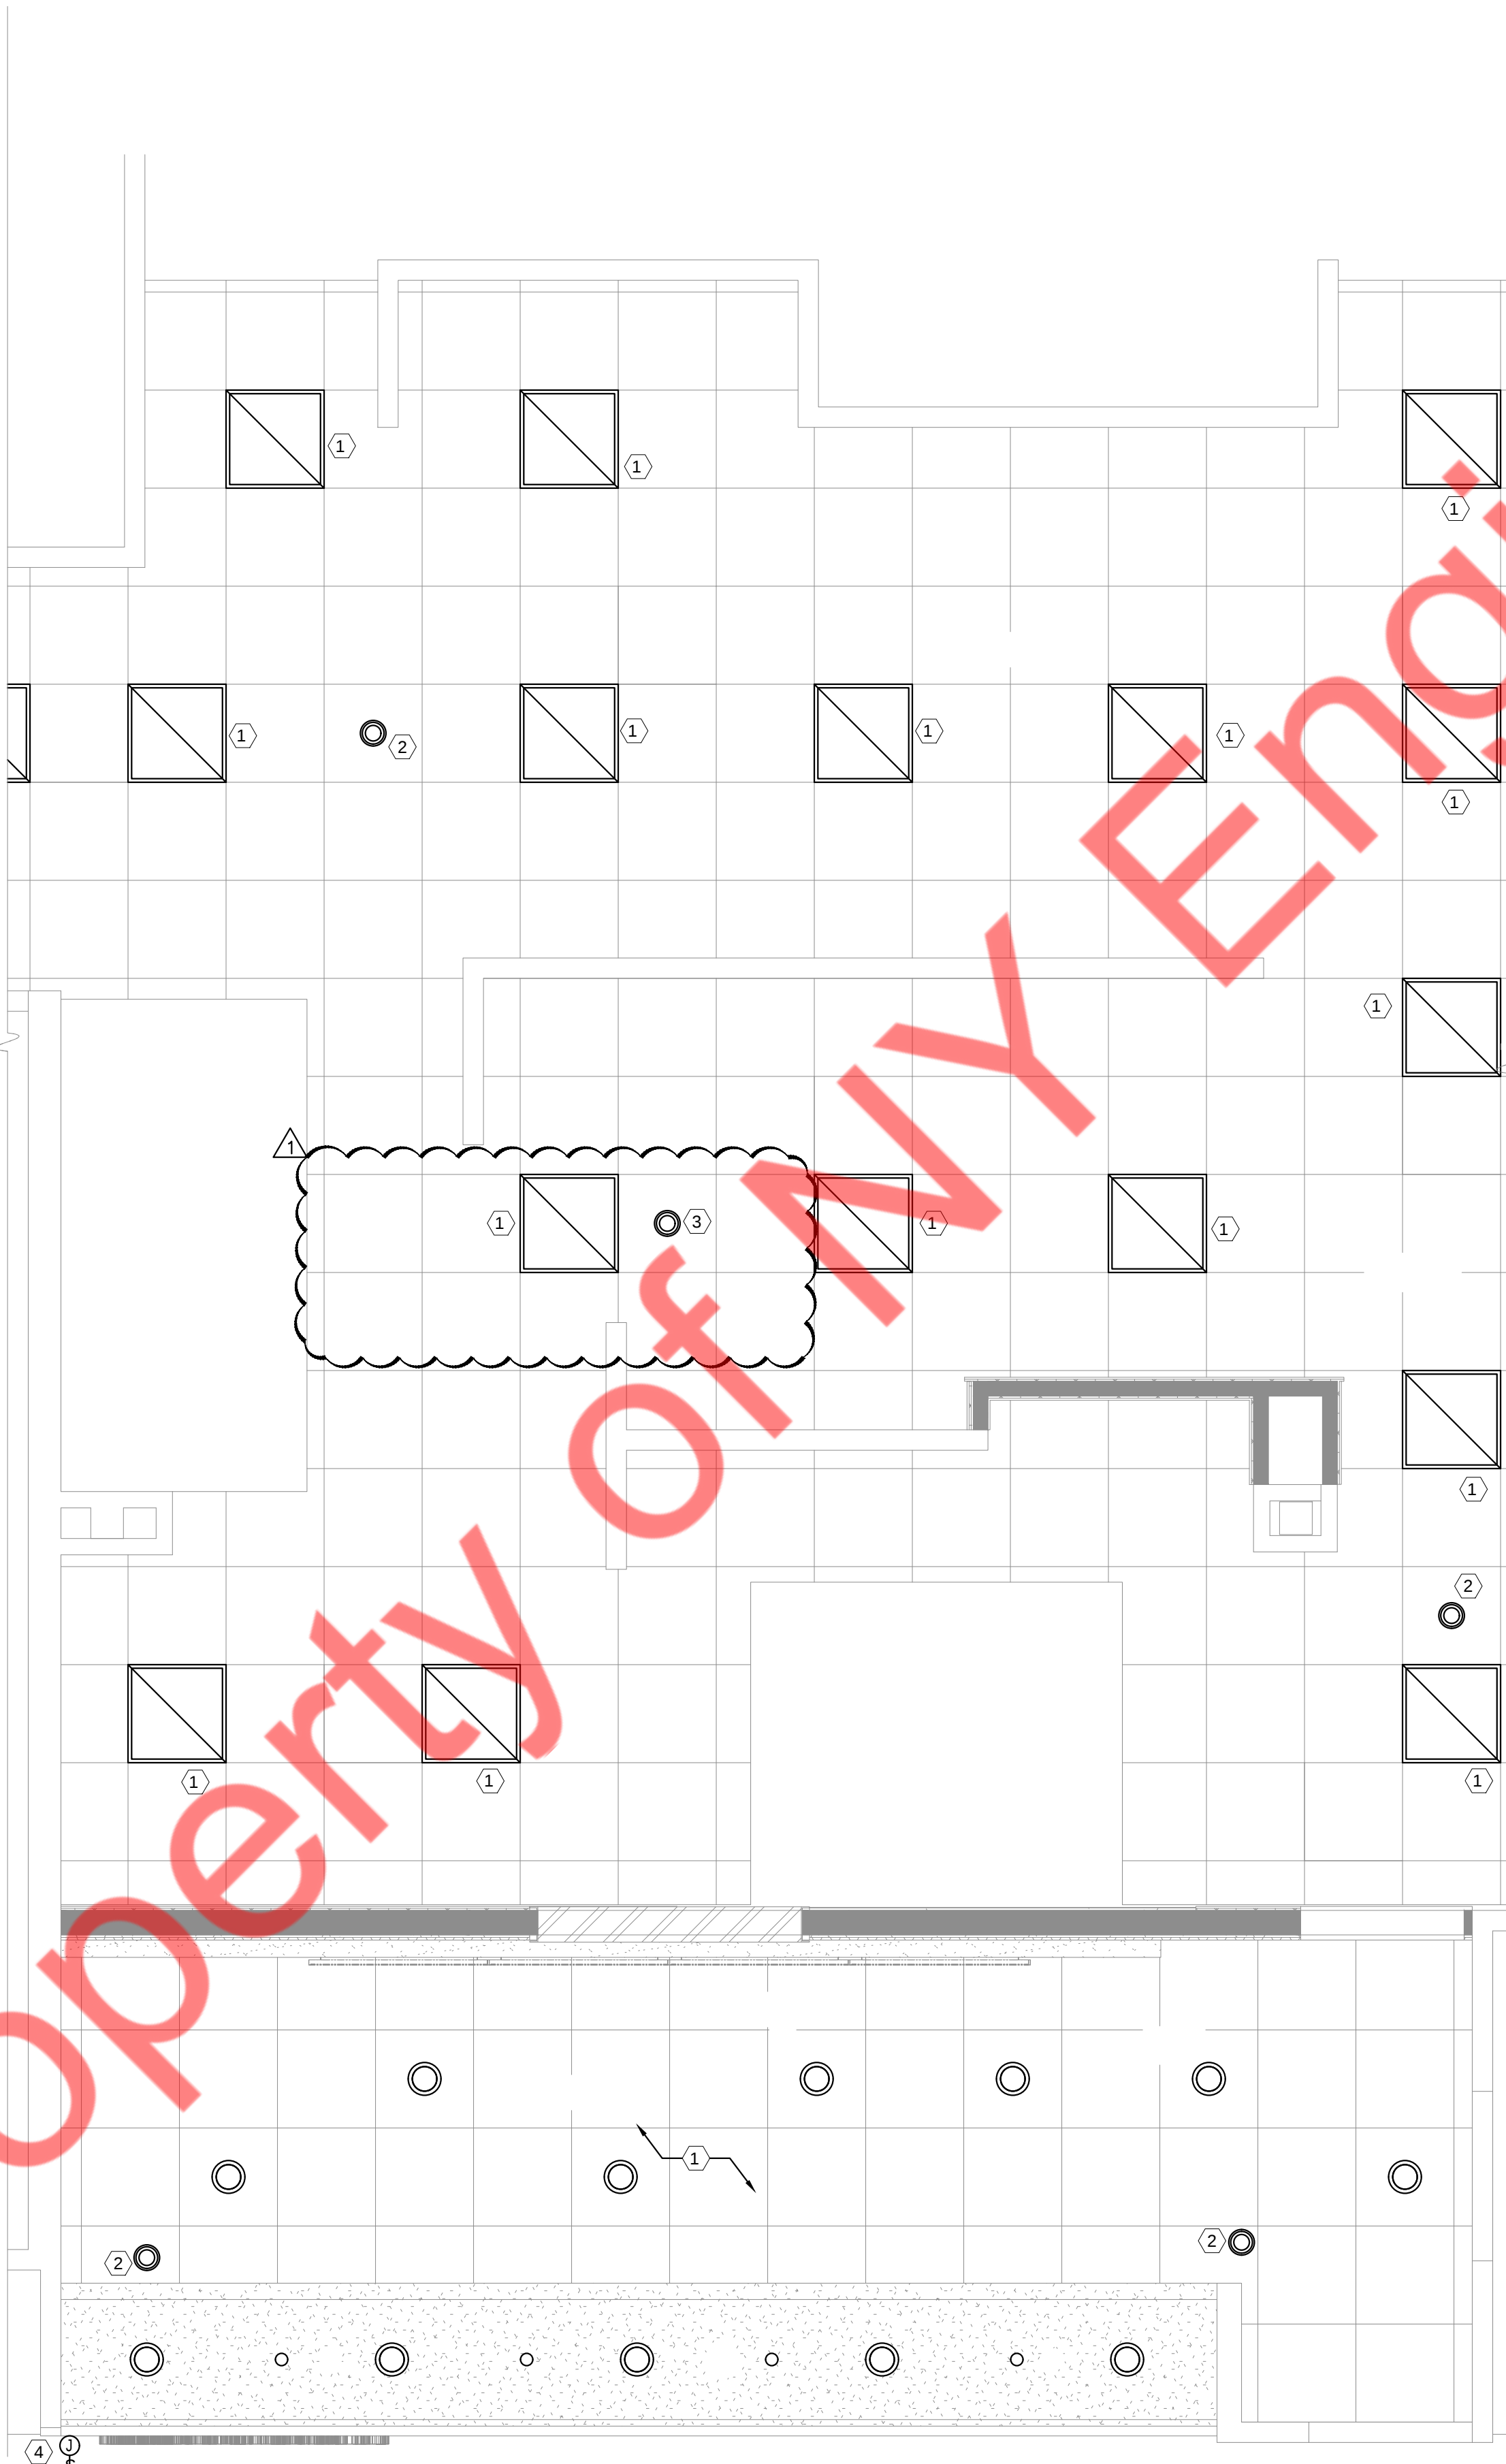

1 LIGHTING PLAN
3/8" = 1'-0"

ISSUE	DESCRIPTION	DATE
00	INITIAL ISSUE	06/23/2025
01	CLIENT REVISION	01/15/2026

DOB APPROVAL STAMP:

DATE:	06/02/2025
PROJECT NO.:	Z166-24
DRAWN BY:	NYE
CHECKED BY:	NYE
SCALE:	AS NOTED

DRAWING TITLE:
LIGHTING PLAN


DRAWING NO.:
E-101

1. ALL SINGLE-PHASE RECEPTABLES RATED 50A AND 150V TO GROUND OR LESS, AND THREE PHASE RECEPTABLES RATED 100A AND 150V TO GROUND OR LESS INSTALLED IN THE BATHROOMS, KITCHEN, ROOFTOPS & OUTDOORS SHALL HAVE "GFCI" PROTECTION FOR PERSONNEL PER NEC 2020, 210.8(B).
2. SEE ARCHITECTURAL ELEVATIONS FOR PLACEMENT OF DEVICES.
3. EXISTING ELECTRICAL CONNECTION TO ALL EXISTING HVAC EQUIPMENTS SHALL REMAIN. E.C. SHALL VERIFY THE OPERABLE CONDITION OF EXISTING ELECTRICAL CONNECTION IN FIELD. REPLACE IF FOUND INOPERABLE. BASE BID ACCORDINGLY.
4. E.C. SHALL VERIFY EXACT POWER DISTRIBUTION IN FIELD. INFORM ENGINEER FOR ANY DISCREPANCY FOUND.
5. ELECTRICAL PANEL SHALL HAVE FRONT CLEARANCE AS PER NEC 110.26.
6. E.C. TO FIELD VERIFY THE EXACT LOCATION OF EXISTING ELECTRICAL PANELS. E.C. SHALL VERIFY THE OPERABLE CONDITION OF EXISTING ELECTRICAL PANELS IN FIELD.
7. E.C. SHALL VERIFY THE EXACT ELECTRICAL REQUIREMENT INCLUDING RECEPTACLE, CIRCUIT BREAKER AND CABLES FOR EXISTING/RELOCATED EQUIPMENTS IN FIELD AND ACCORDINGLY UPDATE THE ELECTRICAL CONNECTION FOR EXISTING EQUIPMENTS IF REQUIRED. INFORM ENGINEER FOR ANY DISCREPANCY FOUND. BASE BID ACCORDINGLY.
8. FOR KITCHEN EQUIPMENT SCHEDULE REFER TO ARCHITECTURAL SHEET K-801 & K-802. E.C. SHALL VERIFY AND PROVIDE THE EXACT ELECTRICAL REQUIREMENT INCLUDING RECEPTACLE, R/LUS, CORD, CIRCUIT BREAKER AND CABLES FOR ALL THE KITCHEN EQUIPMENTS IN COORDINATION WITH EQUIPMENT SUPPLIER/MANUFACTURER IN FIELD. BASE BID ACCORDINGLY.

1. E.C. TO COORDINATE WITH ARCHITECT AND VERIFY THE RELOCATED AND EXISTING EQUIPMENT IN THE FIELD & ACCORDINGLY RELOCATE ASSOCIATED RECEPTACLES/ELECTRICAL OUTLETS. E.C. TO EXTEND BRANCH CIRCUIT INCLUDING BUT NOT LIMITED TO CONDUIT BRANCH WIRE ETC. BASE BID ACCORDINGLY.
2. CONTRACTOR SHALL PROVIDE POWER AND NECESSARY WIRING FOR THE HOOD CONTROL PANEL. SEE THE HALTON DRAWINGS FOR WIRING REQUIREMENTS.
3. E.C. SHALL VERIFY EXIST POWER, ELECTRICAL CONNECTION REQUIREMENT & MOUNTING HEIGHT WITH KITCHEN EQUIPMENT MANUFACTURER. MAKE POWER PROVISION ACCORDINGLY. BASE BID ACCORDINGLY.
4. E.C. SHALL COORDINATE THE GENERAL RECEPTACLES LOCATION AND EXACT MOUNTING HEIGHT WITH ARCHITECT /FRANCHISEE PRIOR TOO ROUGH IN. BASE BID ACCORDINGLY.

ITEM NO.	DESCRIPTION	QUANTITY	VOLTAGE	PHASE	AMPS	KW	CONNECTION TYPE	REMARK
420	SINGLE UNDERCOUNTER REFRIGERATOR (27")	1	115	1	4.7	0.54	NEMA 5-15	
422A	REFRIGERATED EQUIPMENT STAND (36")	1	115	1	6.7	0.77	NEMA 5-15	
440C	ICE BATH BREADING TABLE	2	120	1	1	0.12	NEMA 5-15	
442WCL	SINGLE UPRIGHT REFRIGERATOR (30" WIDE)	1	115	1	7	0.81	NEMA 5-15	
503	EGG STATION	2	208	1	12.6	2.90	NEMA 6-20P	
505VL	VECTOR OVEN	2	208	1	38	7.90	NEMA 6-50P	
523	PRESSURE FRYER	1	208	3	38	13.50	NEMA 15-50	
524	DUAL SIDE CLAMSHELL GRILL	1	208	3	-	9.00	NEMA 15-50	
563D	DOUBLE TIER SANDWICH SLIDE (38")	1	120	1	9.18	1.73	NEMA 1L14-20	
580H	VISUAL HOT HOLDING CABINET (5x2)	2	120	1	16	1.92	NEMA 5-20	
F444SL	FUTURE SINGLE THAWING CABINET (32" WIDE)	1	115	1	12	1.38	DIRECT	
F315W	FUTURE 10 HEAD BEV DISPENSER	1	115	1	10	1.15	NEMA 5-15	

E.C.TO VERIFY EXACT VOLTAGE, NO OF WIRES, BREAKER AND POWER CONNECTION REQUIREMENT OF THE EQUIPMENT WITH KITCHEN EQUIPMENT VENDOR. ANY DISCREPANCIES SHALL BE COMMUNICATED WITH ENGINEER ON RECORD PRIOR TO BIDDING/ROUGH-IN.

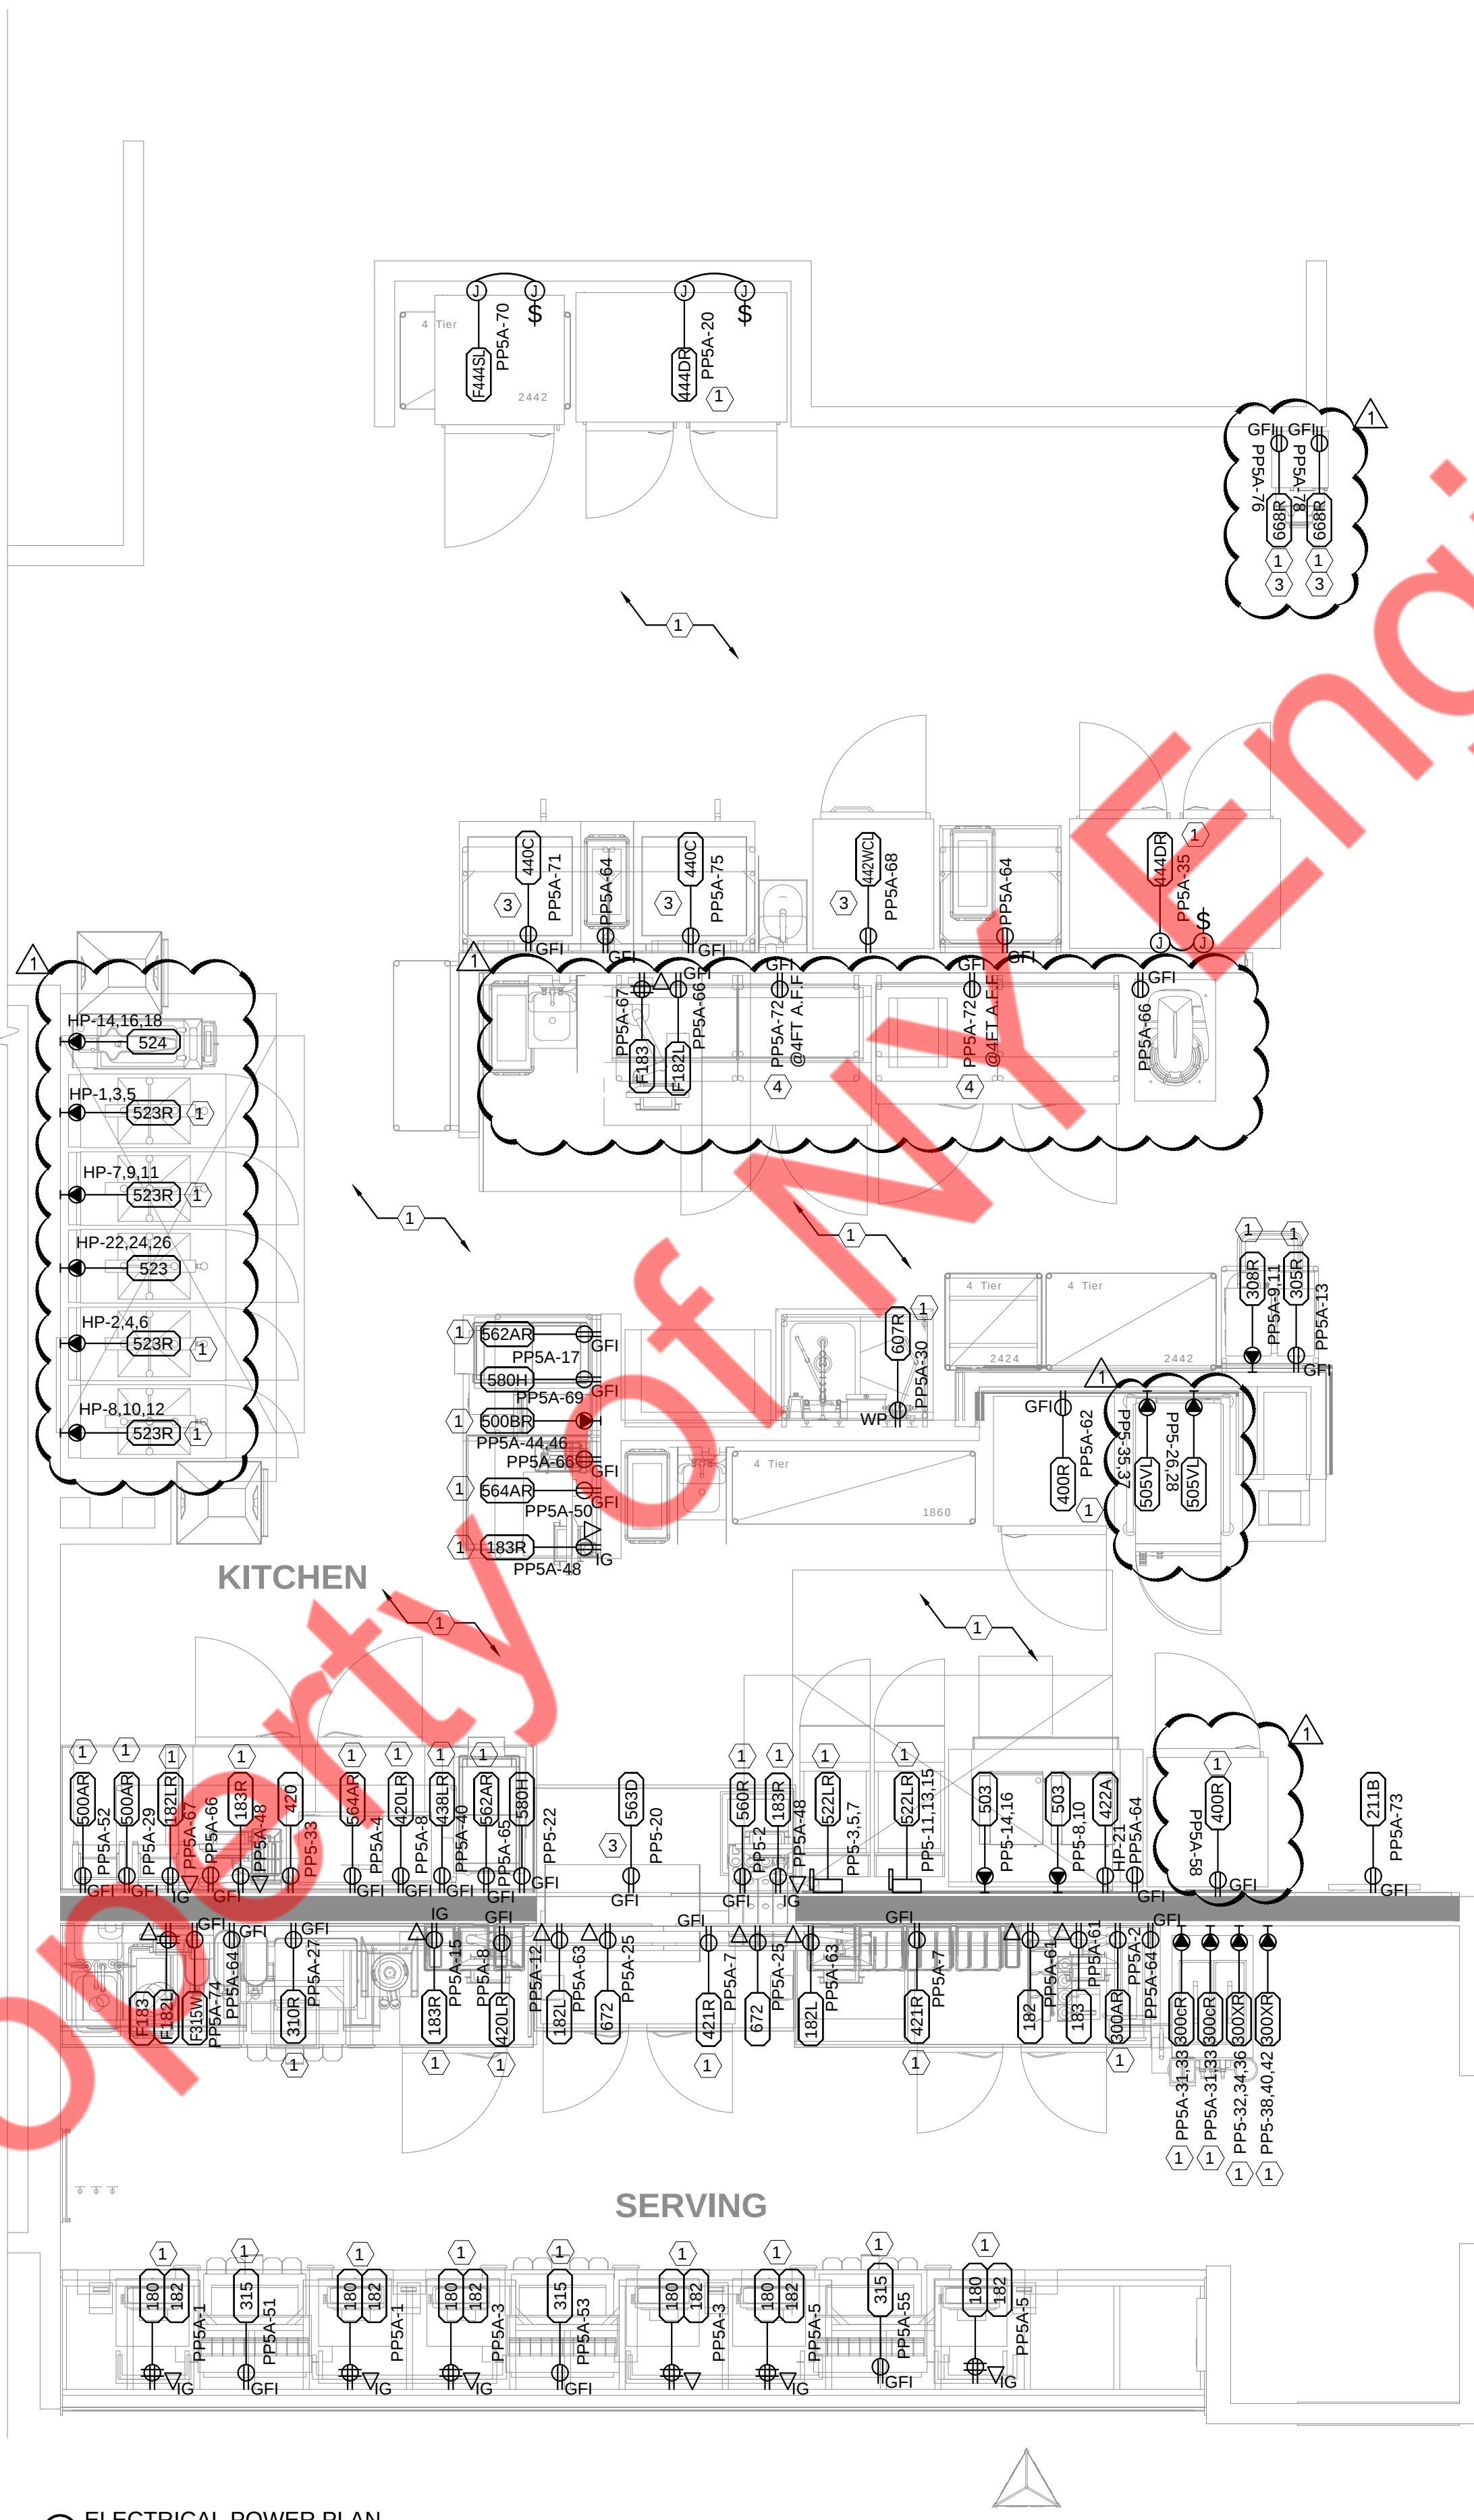

① ELECTRICAL POWER PLAN
3/8" = 1'-0"

[illegible]

--

[illegible]

SCALE: AS NOTED

ELECTRICAL POWER PLAN

E-201

1


ELECTRICAL ROOF PLAN KEY NOTES: (#)

1

NOT USED.

2


EXISTING MECHANICAL EQUIPMENTS & ITS ELECTRICAL CONNECTION SHALL REMAIN. E.C. SHALL VERIFY AVAILABILITY/OPERABILITY OF THE EXISTING DISCONNECT SWITCH FOR EXISTING MECHANICAL EQUIPMENTS IN THE FIELD . PROVIDE NEW IN CASE OF UNAVAILABILITY / UNOPERABILITY . E.C. SHALL ALSO VERIFY EXACT ELECTRICAL REQUIREMENT FOR NEW DISCONNECT SWITCH OF EXISTING MECHANICAL EQUIPMENTS AS PER THE MANUFACTURER'S CUT-SHEET. INFORM ENGINEER ON RECORD FOR ANY DISCREPANCY PRIOR TO BID. REPLACE IF FOUND IN OPERABLE. BASE BID ACCORDINGLY.

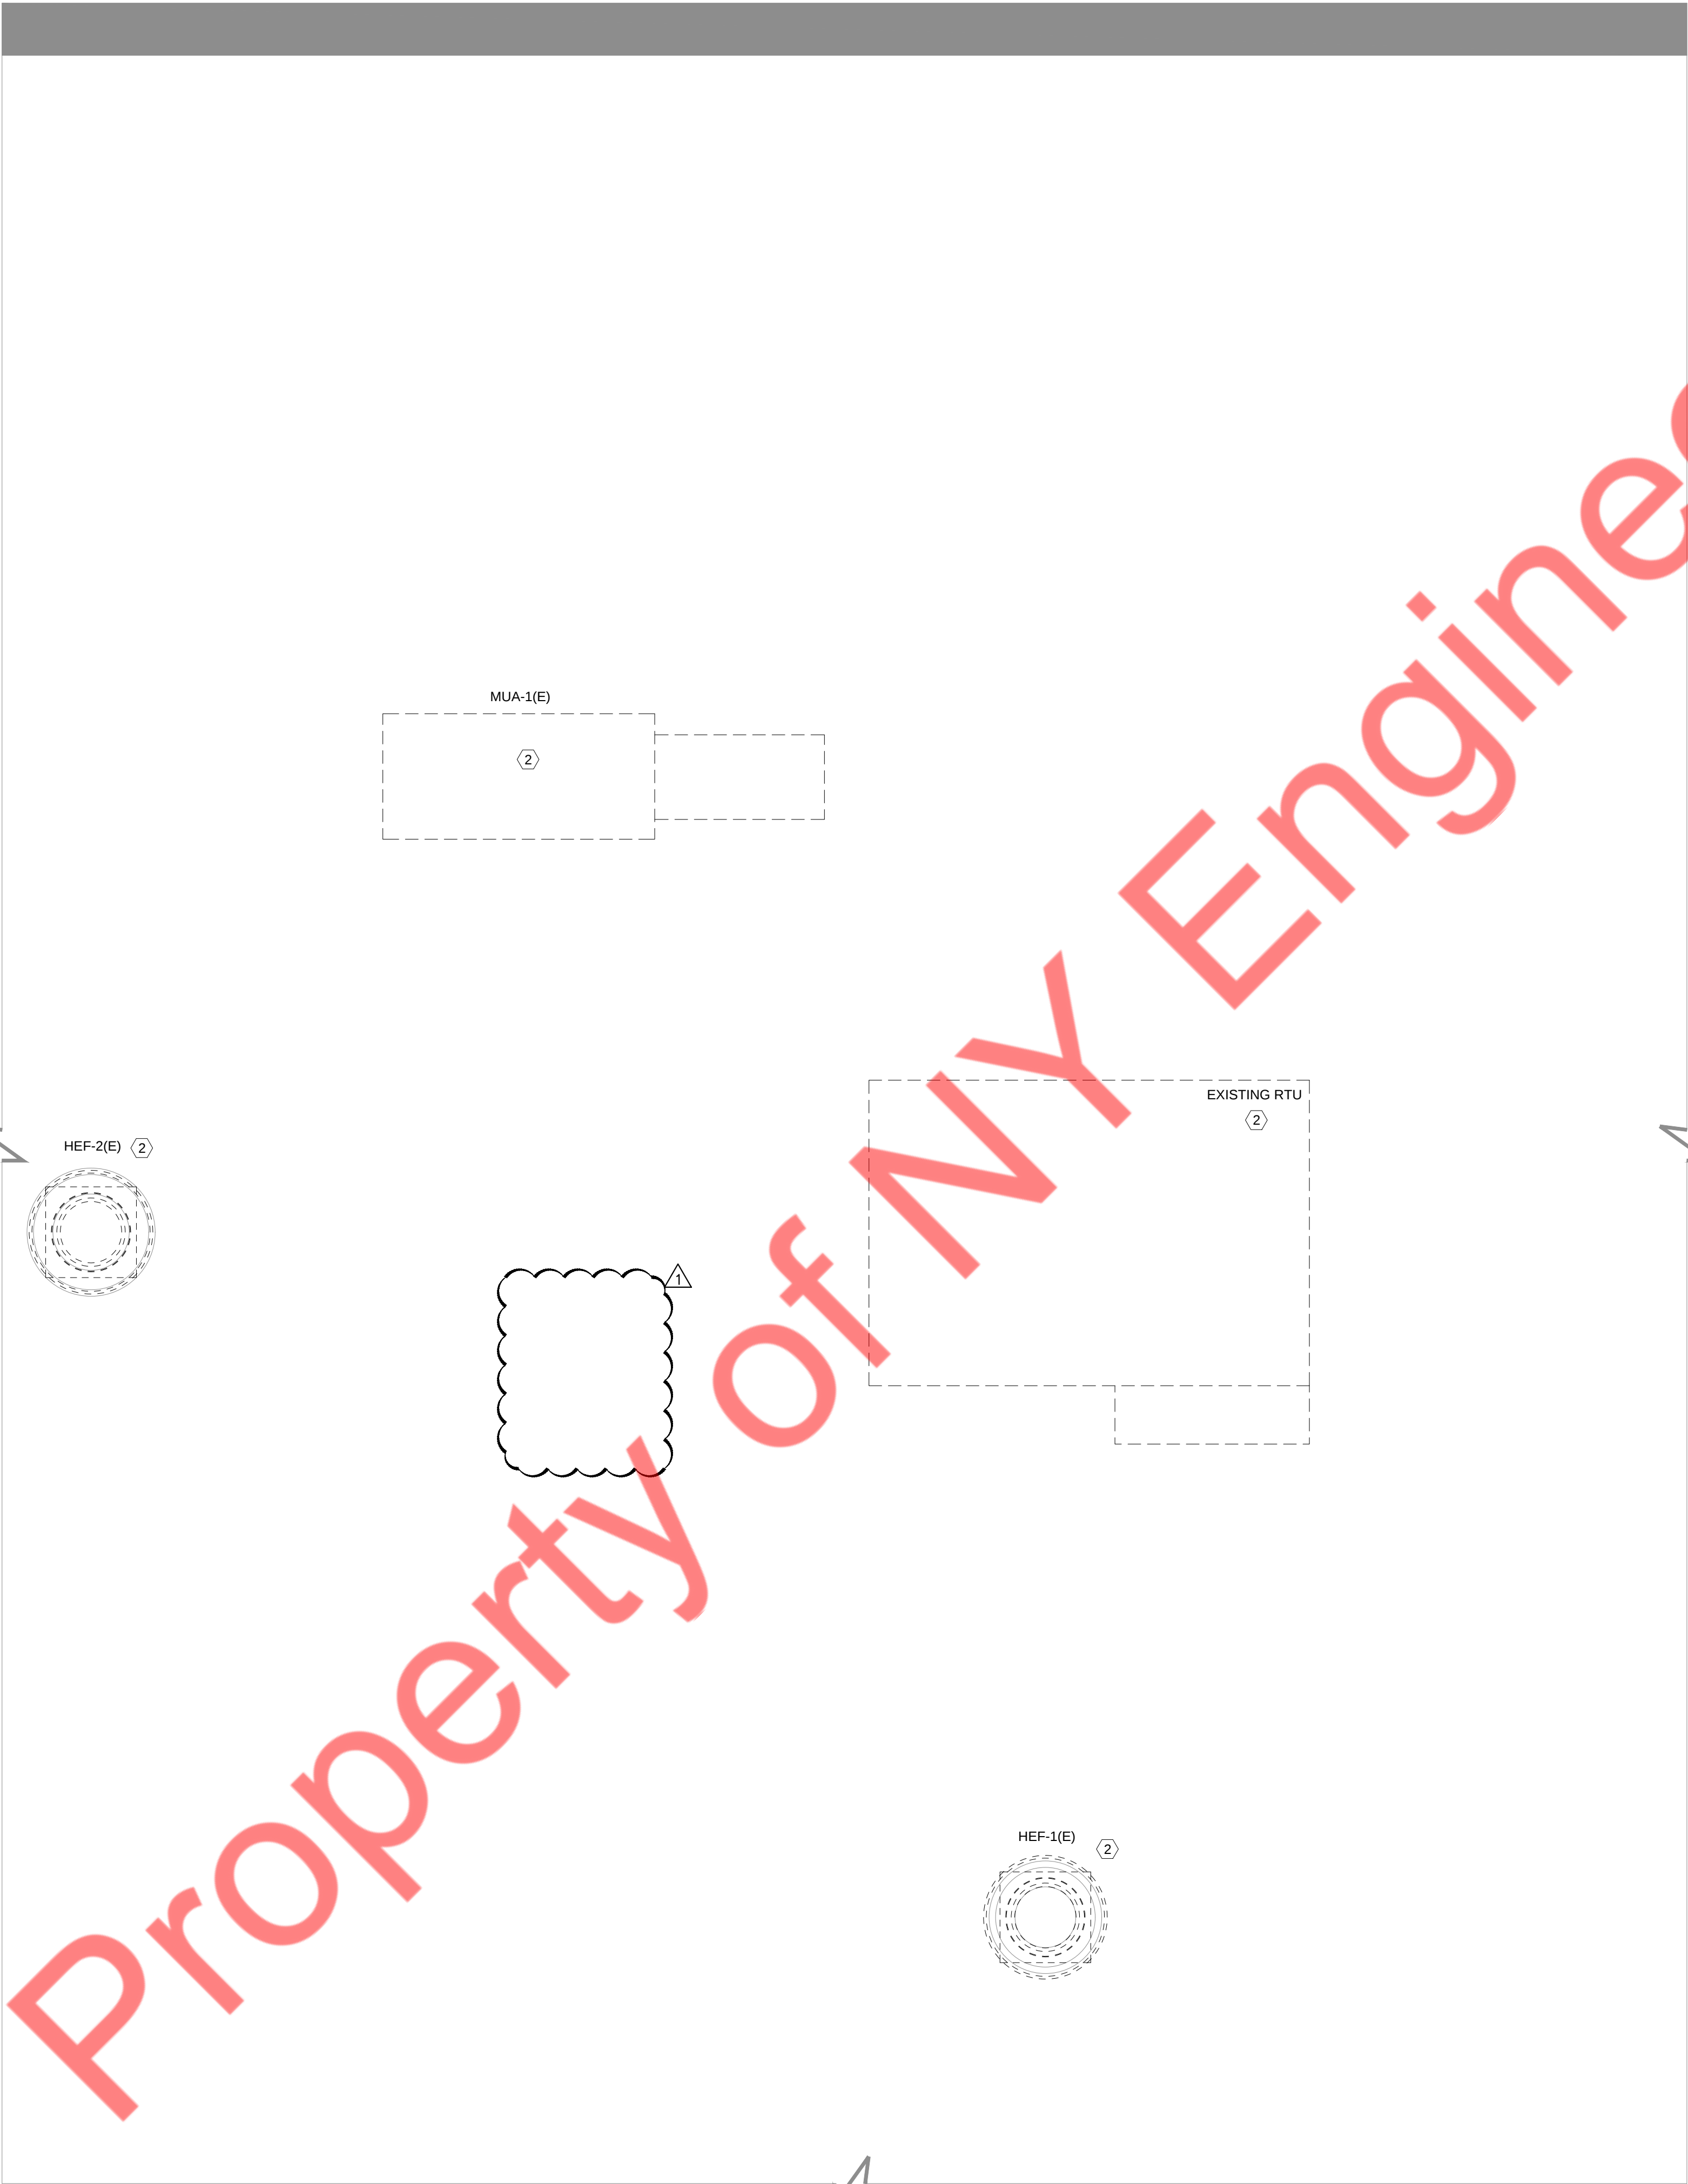


1 ELECTRICAL ROOF PLAN

3/8" = 1'-0"

ISSUE	DESCRIPTION	DATE
00	INITIAL ISSUE	06/23/2025
01	CLIENT REVISION	01/15/2026

 

DOB APPROVAL STAMP:

 

DATE:	06/02/2025
PROJECT NO.:	Z166-24
DRAWN BY:	NYE
CHECKED BY:	NYE
SCALE:	AS NOTED


DRAWING TITLE:

ELECTRICAL ROOF PLAN


DRAWING NO.:

E-202

1. ALL CONDUCTORS IN VERTICAL RACEWAYS SHALL BE SUPPORTED IN ACCORDANCE WITH ARTICLE 300.19 OF NEC. CABLE SUPPORTS SHALL BE LOCATED AT THE INTERVALS REQUIRED BY THE NEC.
2. CABLE SUPPORT SYSTEM SHALL BE AS MANUFACTURED BY O-2 GEDNEY WITH pOzi-GRIP "S-STYLE" WEDGING PLUG OR APPROVED EQUAL.
3. FOR THREADLESS CONDUIT (RIGID, IMC OR EMT), ATTACH CONDUIT BODY TO MALE THREADS OF A SET SCREW OR COMPRESSION CONNECT, AS PERMITTED BY SPECIFICATION.
4. PROVIDE PULL BOX AT EACH LOCATION OF CABLE SUPPORT. PULL BOX SHALL BE SIZED AS PER CODE TO ACCOMMODATE ALL CONDUITS.

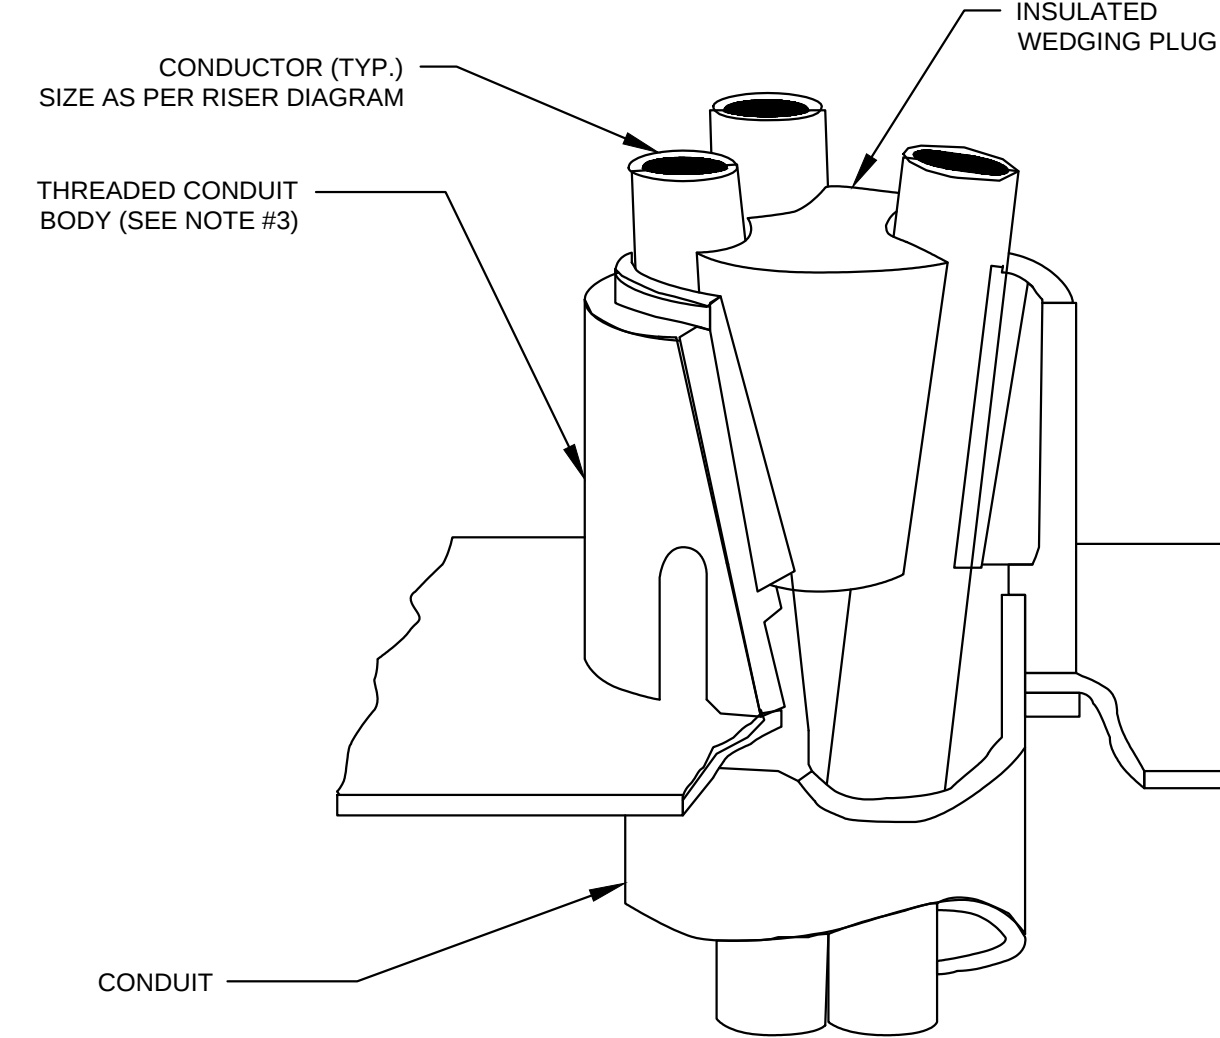


① VERTICAL CABLE SUPPORT DETAIL
SCALE : N.T.S.

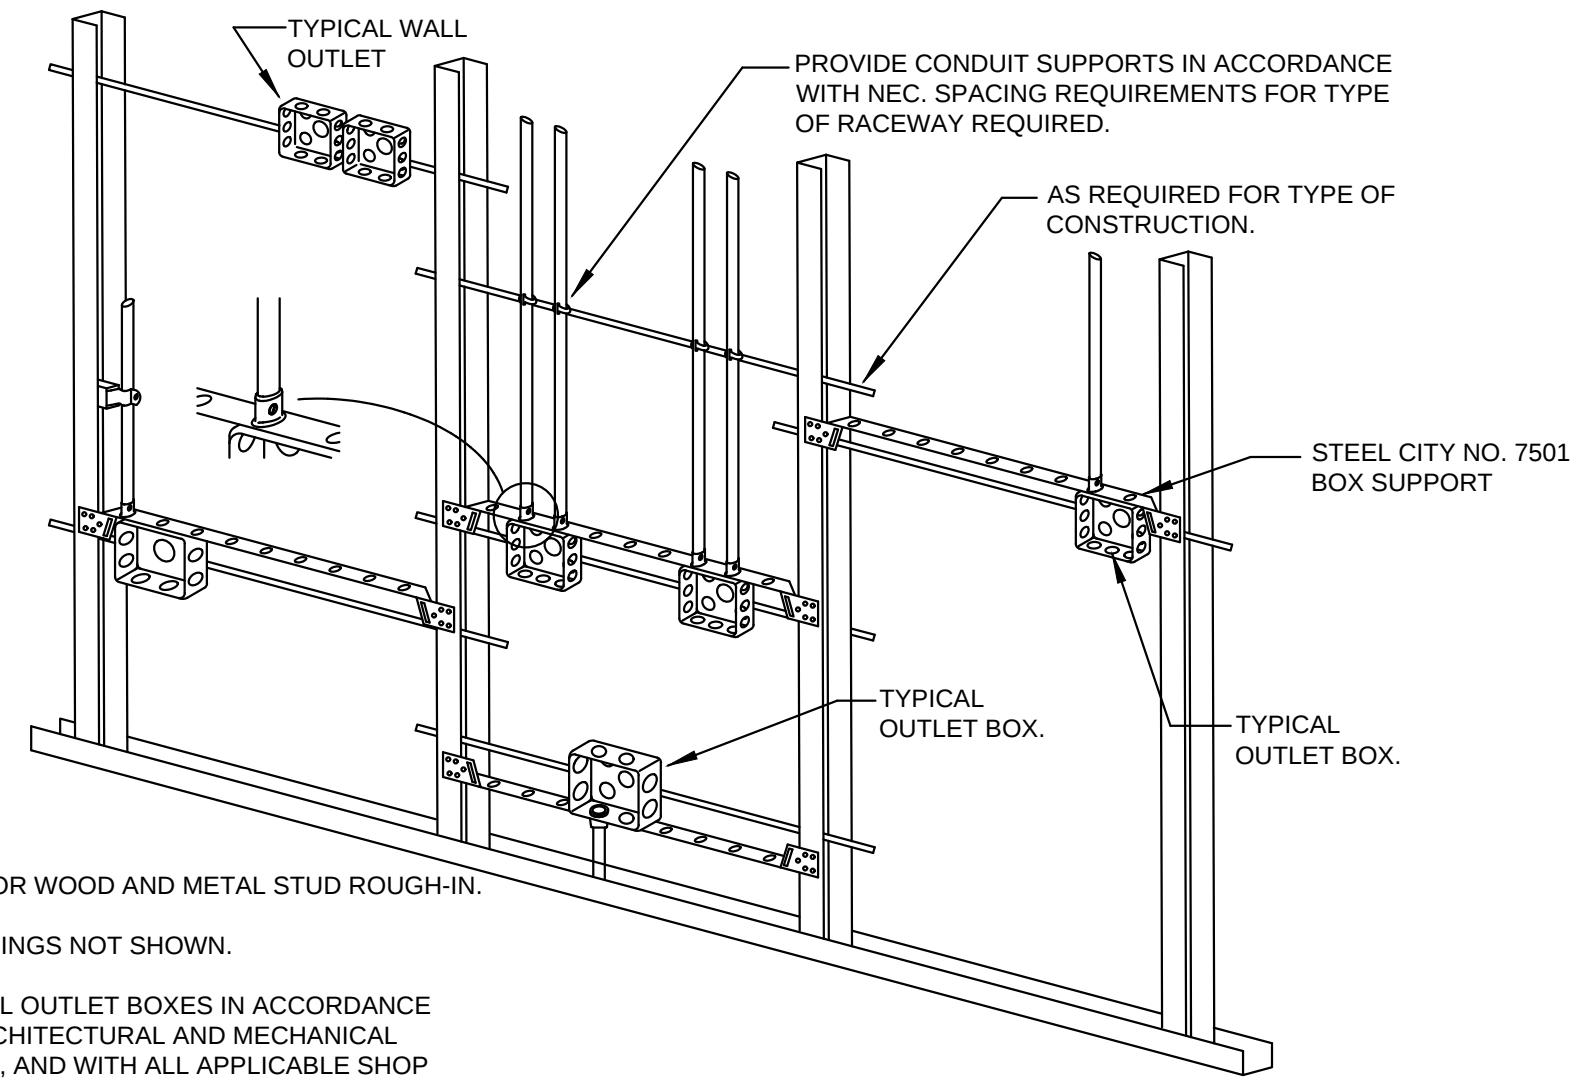

1. TYPICAL FOR WOOD AND METAL STUD ROUGH-IN
2. PLASTER RINGS NOT SHOWN.
3. LOCATE ALL OUTLET BOXES IN ACCORDANCE WITH ARCHITECTURAL AND MECHANICAL DRAWINGS, AND WITH ALL APPLICABLE SHOP DRAWINGS.
4. IN ACCORDANCE WITH UBC 4304 OUTLETS ON OPPOSITE SIDES OF WALLS OR PARTITIONS IN THE SAME STUD SPACE MUST BE SEPARATED BY A MIN. OF 24" HORIZONTAL DISTANCE.


② DETAIL TYPICAL ROUGH-IN REQUIREMENTS
SCALE : N.T.S.

NOTE:
THIS INFORMATION MAY NOT CONTAIN ALL DETAILS REQUIRED FOR CONSTRUCTION. APPROPRIATE MODIFICATION MAY BE REQUIRED TO ENSURE SUITABILITY OF THESE DRAWINGS FOR THE SPECIFIC APPLICATION. IT IS THE USER'S RESPONSIBILITY TO ENSURE INSTALLATION OF THE EQUIPMENT/SYSTEM IS IN ACCORDANCE WITH BUILDING/PROJECT SPECIFICATIONS, APPLICABLE CODES AND STANDARDS.

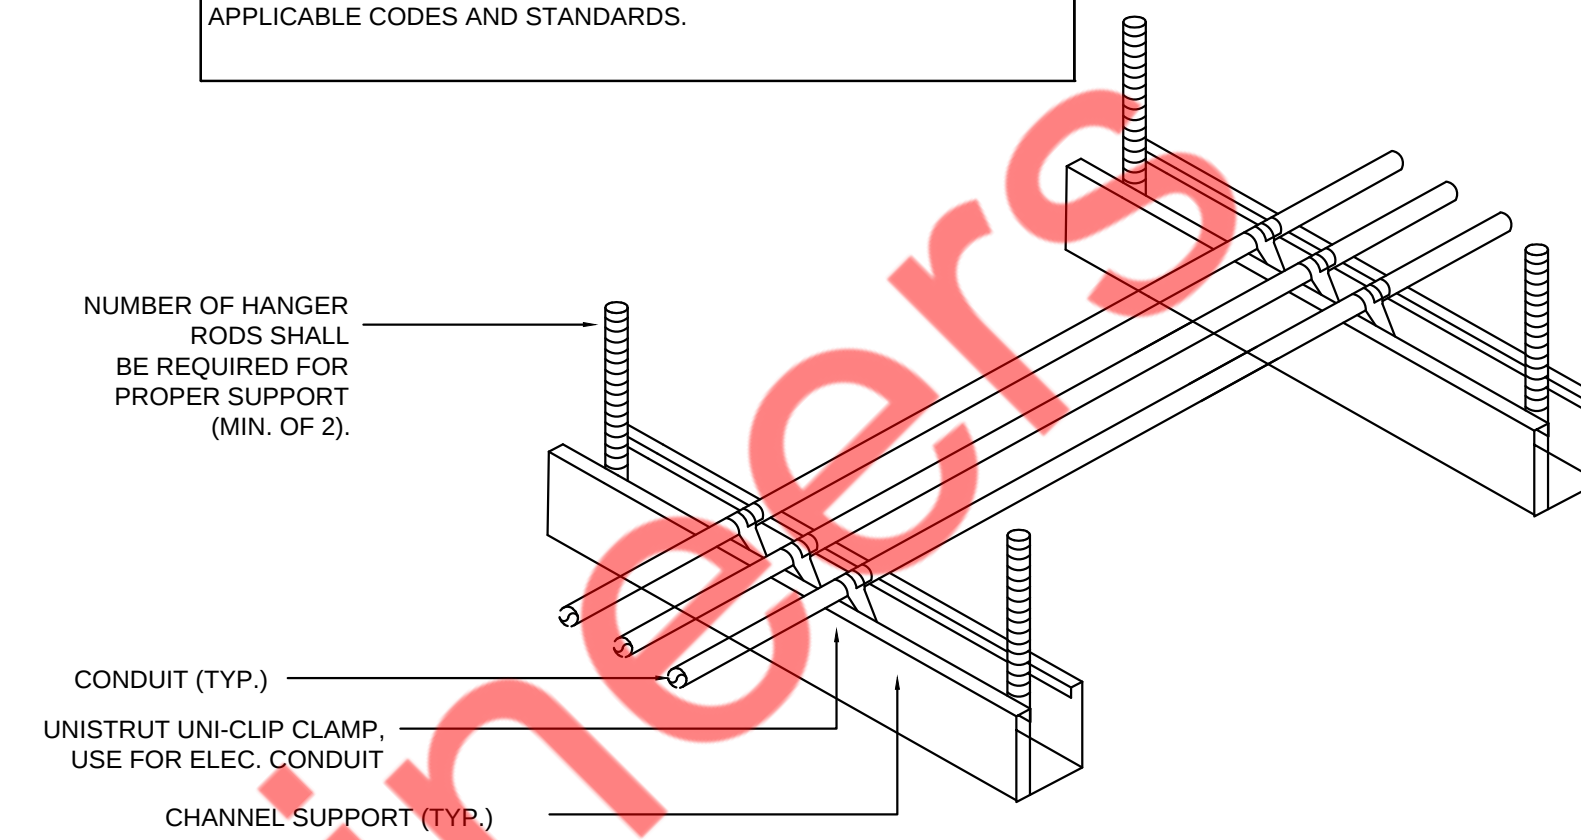

1. ALL CONDUIT MAY BE COMBINED ON SAME SUPPORT CHANNEL WHERE PRACTICAL.
2. SUPPORT CHANNEL LENGTH SHALL NOT BE DETERMINED UNTIL ALL PIPING, CONDUIT, ETC. TO BE SUPPORTED IS COORDINATED.
3. SUPPORT CHANNEL SPACING SHALL BE NO MORE THAN 10'-0".
4. UNISTRUT AND CONDUIT INSTALLATION MAY BE REVERSED.

3 CONDUIT SUPPORT DETAIL
SCALE : N.T.S.

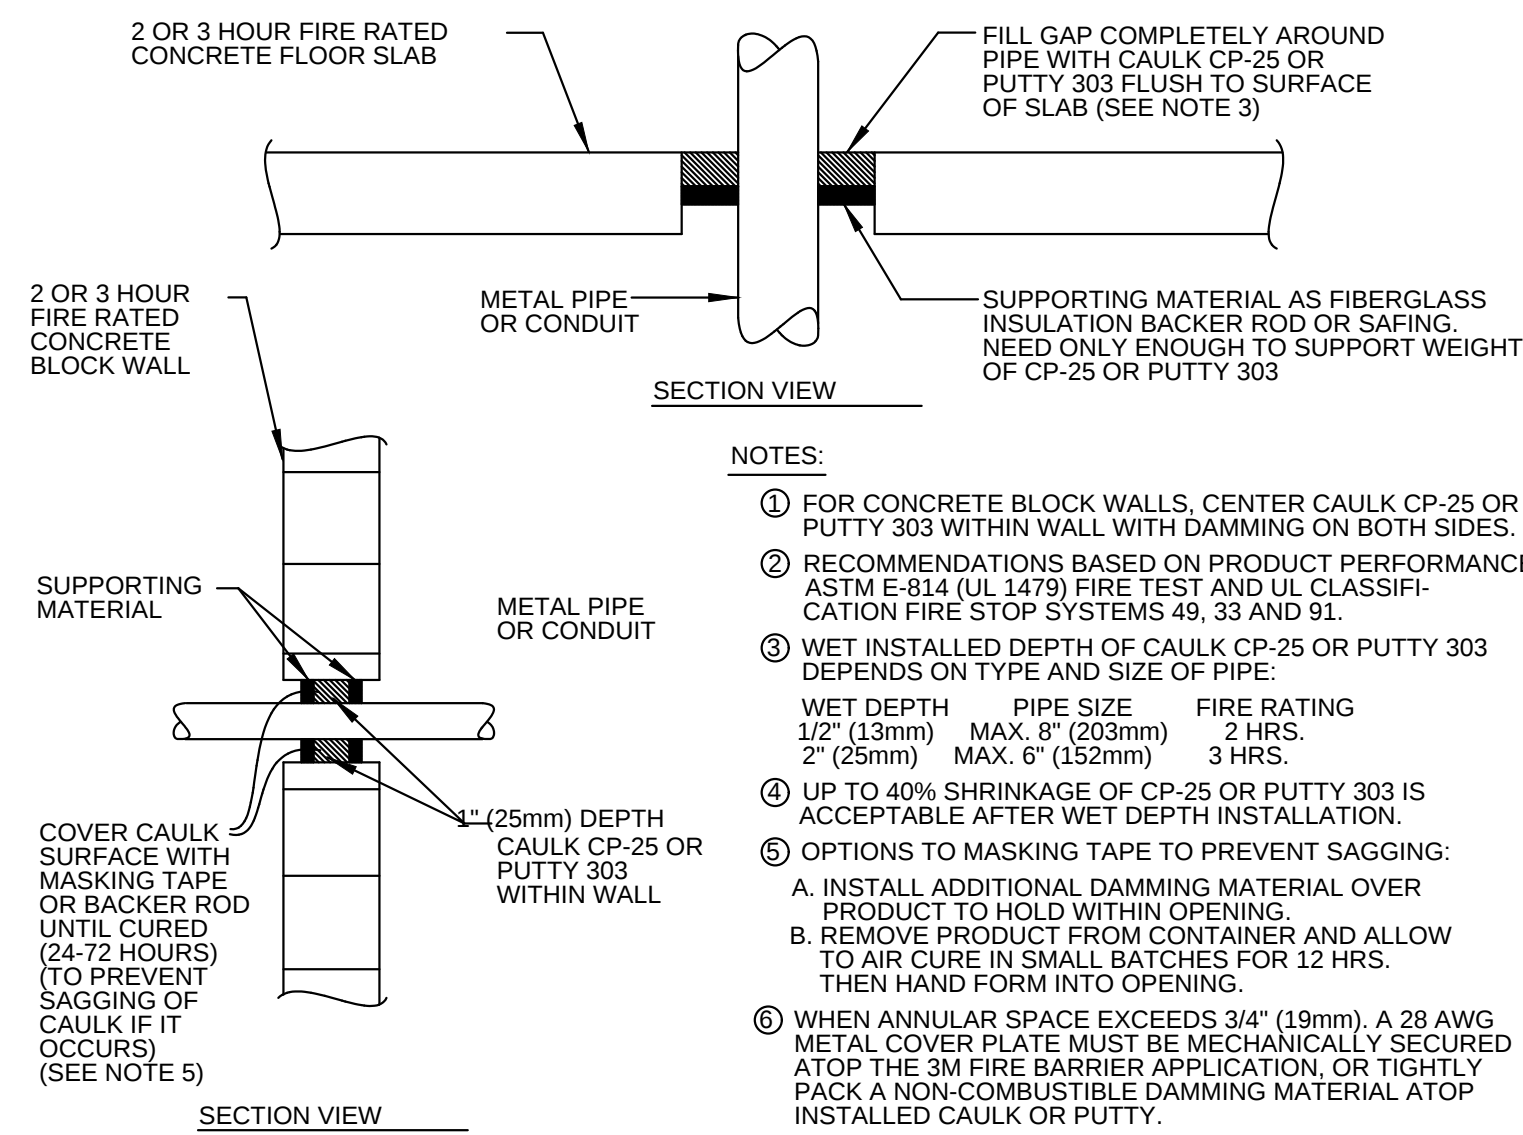

- ① **FOR CONCRETE BLOCK WALLS. CENTER CAULK CP-25 OR PUTTY 303 WITHIN WALL WITH DAMMING ON BOTH SIDES.**
- ② **RECOMMENDATIONS BASED ON PRODUCT PERFORMANCE PER ASTM E-91 (UL 330) AND UL 181. SEE ALSO CLASSIFICATION FIRE STOP SYSTEMS 49, 33 AND 91.**
- ③ **WET INSTALLED DEPTH OF CAULK CP-25 OR PUTTY 303 DEPENDS ON TYPE AND SIZE OF PIPE:**

WET DEPTH	PIPE SIZE	FIRE RATING
2" (51mm)	MAX. 6" (203mm)	1 HR.
2" (51mm)	MAX. 6" (152mm)	3 HRS.
- ④ **UP TO 40% SHRINKAGE OF CP-25 OR PUTTY 303 IS ACCEPTABLE AFTER WET DEPTH INSTALLATION.**
- ⑤ **OPTIONS TO MASKING TAPE TO PREVENT SAGGING:**
 - A. **INSTALL ADDITIONAL DAMMING MATERIAL OVER PRODUCT TO HOLD WITHIN DEPTH.**
 - B. **REMOVE PRODUCT FROM CONTAINER AND ALLOW TO AIR CURE IN SMALL BATCHES FOR 12 HRS. THEN HANG FORM TO HOLD IN PLACE.**
- ⑥ **WHEN ANNULAR SPACE EXCEEDS 3/4" (19mm). A 28 AWG METAL COVER PLATE MUST BE MECHANICALLY SECURED AROUND THE 3M FIRE BARRIER APPLICATION, OR TIGHTLY PACK A NYLON COMBUSTIBLE DAMMING MATERIAL AROUND INSTALLED CAULK OR PUTTY.**

④ FIRE SUPPORT DETAIL
SCALE : N.T.S.

[illegible]

--

SCALE: AS NOTED

ELECTRICAL DETAILS

E-301

PANEL: PP5 (EXISTING)										MOUNTING: SURFACE					
208Y/120		VOLTS,	3	PHASE,	4	WIRE		PANEL LOCATION: BOH OF CHICK- FIL-A AREA							
MAIN CB: NA		MLO: 600 A		BUS: EXISTING		MIN.		FED FROM: EXISTING RDP1							
NOTE: L : LIGHTING, H : HVAC LOAD, M : MOTOR LOAD, R : RECEPTACLES, O : OTHER/MISC. (TYPICAL), * - NEW BREAKER, **- GFI BREAKER															
CKT NO.	TRIP AMPS	DESCRIPTION OF LOAD	LOAD TYPE	LOAD (KVA)	MINIMUM BRANCH CIRCUIT	PER PHASE (KVA)			MINIMUM BRANCH CIRCUIT	LOAD (KVA)	LOAD TYPE	DESCRIPTION OF LOAD	TRIP AMPS	CKT NO.	
						A	B	C							
3P-250		PANEL - HP (EX.)	O	18.03	EXISTING	18.03									
			O	18.03		18.03									
			O	18.03			18.03								
1		SHUNT TRIP				1.90			EXISTING	1.90	E	FRY HOLDING #560R (EX.)	20	2	
3	3P-80	OPEN FRYER #522 (EX.)	E	7.33	EXISTING		7.33					SHUNT TRIP		4	
5			E	7.33				7.33		SPACE			6		
7			E	7.33			8.78						8		
9	3P-80	SHUNT TRIP			EXISTING		1.45		2#12, #12G, 3/4"C	1.45	E	EGG STATION #503	2P-20**	10	
11			E	7.33				7.33				SHUNT TRIP		12	
13		OPEN FRYER #522 (EX.)	E	7.33			8.78			2#12, #12G, 3/4"C	1.45	E	EGG STATION #503	2P-20**	14
15	20	SPARE	E	7.33			8.78			1.45	E			16	
17			SHUNT TRIP					0.00		SHUNT TRIP			18		
19				E		4.50	5.60			3#12, #12G, 3/4"C	1.10	E	DOUBLE TIER SANDWICH SLIDE #563D	20*	20
21	3P-60	CONVECTION OVEN #505G (EX.)	E	4.50	EXISTING		6.42		2#12, #12G, 3/4"C	1.92	E	VISUAL HOT HOLDING CABINET #580H	20*	22	
23				E		4.50			5.00	EXISTING	0.50	O	ANSEL SHUNT (EX.)	20	24
25	2P-20	SHUNT TRIP				3.95			2#8, #10G, 3/4"C	3.95	E			26	
27							3.95			3.95	E	VECTOR OVEN #505VL	2P-50**	28	
29				O		0.50			0.50			SPACE			30
31	2P-20	GREASE SEPERATOR (EX.)	O	0.50	EXISTING	2.78				2.28	E			32	
33	20**	SINGLE UNDERCOUNTER REFRIGERATOR #420	E	0.54	2#12, #12G, 3/4"C		2.82		EXISTING	2.28	E	ICE CREAM MACHINE #300XR (EX.)	3P-20	34	
35	2P-50**	VECTOR OVEN #505VL	E	3.95	2#8, #10G, 3/4"C			6.23		2.28	E			36	
37				E		3.95		5.75			1.80	E			38
39			SPACE						1.80		EXISTING	1.80	E	ICE CREAM MACHINE #300XR (EX.)	3P-30
41		SPACE						1.80		1.80	E			42	
TOTAL CONNECTED LOAD (KVA)						55.58	50.59	46.23							


PANEL: HP (EXISTING)										MOUNTING: SURFACE					
208Y/120		VOLTS,	3	PHASE,	4	WIRE		PANEL LOCATION: BOH							
MAIN CB: NA		MLO: 400 A		BUS: EXISTING		MIN.		FED FROM: EXISTING PPS							
NOTE: L : LIGHTING, H : HVAC LOAD, M : MOTOR LOAD, R : RECEPTACLES, O : OTHER/MISC. (TYPICAL), * - NEW BREAKER, ** - GFI BREAKER															
CKT NO.	TRIP AMPS	DESCRIPTION OF LOAD	LOAD TYPE	LOAD (KVA)	MINIMUM BRANCH CIRCUIT	PER PHASE (KVA)			MINIMUM BRANCH CIRCUIT	LOAD (KVA)	LOAD TYPE	DESCRIPTION OF LOAD	TRIP AMPS	CKT NO.	
						A	B	C							
1			E	4.50	EXISTING	9.00			EXISTING	4.50	E			2	
3	3P-50	PRESSURE FRYER #523R (EX.)	E	4.50			9.00			4.50	E	PRESSURE FRYER #523R (EX.)	3P-50	4	
5			E	4.50				9.00		4.50	E			6	
7			E	4.50	EXISTING	9.00			EXISTING	4.50	E			8	
9	3P-50	PRESSURE FRYER #523R (EX.)	E	4.50			9.00			4.50	E	PRESSURE FRYER #523R (EX.)	3P-50	10	
11			E	4.50				9.00		4.50	E			12	
13					3#8, #10G, 3/4" C	3.00			3#8, #10G, 3/4" C	3.00	E	DUAL SIDE CLAM-SHELL GRILL #524	3P-50 **	14	
15		3P-50	SPARE					3.00			3.00	E			16
17										3.00	3.00	E			18
19		SHUNT TRIP			3#8, #10G, 3/4" C	0.00			3#8, #10G, 3/4" C	4.50	E	SHUNT TRIP		20	
21	20**	REFRIGERATED EQUIPMENT STAND #422A	E	0.77			5.27			4.50	E	PRESSURE FRYER #523	3P-50 **	22	
23		SHUNT TRIP						4.50		4.50	E			24	
25		SPACE				4.50				4.50	E			26	
27		SPACE					0.00					SHUNT TRIP		28	
29		SPACE						0.00				SPACE		30	
TOTAL CONNECTED LOAD (KVA)						25.50	26.27	25.50							

PANEL: PP5A(EXISTING)											MOUNTING: SURFACE					
208Y/120		VOLTS,		3	PHASE,		4	WIRE			PANEL LOCATION: BOH OF CHICK- FIL-A AREA					
MAIN CB:		NA		MLO: 225 A		BUS:		EXISTING		MIN.		FED FROM: EXISTING RDP1				
NOTE: L : LIGHTING, H : HVAC LOAD, M : MOTOR LOAD, R : RECEPTACLES, O : OTHER/MISC. (TYPICAL), * - NEW BREAKER, **- GFI BREAKER																
CKT NO.	TRIP AMPS	DESCRIPTION OF LOAD	LOAD TYPE	LOAD (KVA)	MINIMUM BRANCH CIRCUIT	PER PHASE (KVA)			MINIMUM BRANCH CIRCUIT	LOAD (KVA)	LOAD TYPE	DESCRIPTION OF LOAD	TRIP AMPS	CKT NO.		
						A	B	C								
1	20	POS/PRINTER #180 & 182 (EX.)	R	0.72	EXISTING	0.96			EXISTING	0.24	E	MILKSHAKE DISP #300AR (EX.)	20	2		
3	20	POS/PRINTER #180 & 182 (EX.)	R	0.72	EXISTING		1.38		EXISTING	0.66	E	PRODUCT HOLDING #564AR (EX.)	20	4		
5	20	POS/PRINTER #180 & 182 (EX.)	R	0.72	EXISTING			0.96	EXISTING	0.24	E	RETAIL REFRIGERATOR #422 (EX.)	20	6		
7	20	DOUBLE UNDERCOUNTER REFRIGERATOR #421R (EX.)	E	1.73	EXISTING	2.59			EXISTING	0.86	E	UC REFRIGERATOR #420LR (EX.)	20	8		
9	2P-30	COFFEE BREWER #308R (EX.)	E	2.00	EXISTING		3.00		EXISTING	1.00	E	WARMING DRAWER #550 (EX.)	20	10		
11			E	2.00				2.86	EXISTING	0.86	E	UC REFRIGERATOR #420LR (EX.)	20	12		
13	20	TEA BREWER #305R (EX.)	E	1.65	EXISTING	2.45			EXISTING	0.80	E	SODA DISPENSER (EX.)	20	14		
15	20	MENU #183R (EX.)	R	0.90	EXISTING		2.00		EXISTING	1.10	E	FREEZER #400R (EX.)	20	16		
17	20	HOT HOLDING TOWER #562AR (EX.)	E	1.80	EXISTING			2.70	EXISTING	0.90	E	JUICER #607R (EX.)	20	18		
19	20	SANDWICH MERCH #563SR (EX.)	E	0.80	EXISTING	2.64			EXISTING	1.84	E	THAWING CABINET #444DR (EX.)	20	20		
21	20	BREADING TABLE #440R (EX.)	E	1.10	EXISTING		1.10		EXISTING	0.90	E	SPARE	20	22		
23	20	#584 (EX.)	R	0.90	EXISTING				EXISTING	0.80	E	DEMOM-DISP #411R (EX.)	20	24		
25	20	DIGITAL MENU BOARD #672	R	0.36	2#12, #12G, 3/4"C	0.36			EXISTING	0.92	E	SPARE	20	26		
27	20	LEMONADE DISP #310R (EX.)	E	1.02	EXISTING		1.94		EXISTING	0.50	E	UNDER COUNTER RECEPT (EX.)	20	28		
29	20	TOASTER #500AR (EX.)	E	1.80	EXISTING			2.30	EXISTING	0.50	E	JUICER STATION #607R (EX.)	20	30		
31	2P-30	MILKSHAKE SPNR #300C (EX.)	E	1.80	EXISTING	2.30			EXISTING	0.50	E	CO2 MONITOR #BH-126 (EX.)	20	32		
33			E	1.80			2.30		EXISTING	0.50	E	CARBONATOR #BH-128 (EX.)	20	34		
35	20	THAWING CABINET #444DR (EX.)	E	1.84	EXISTING			2.34	EXISTING	0.50	E	CARBONATOR #BH-128 (EX.)	20	36		
37	20	BAG-N-BOX (EX.)	E	0.30	EXISTING	0.80			EXISTING	0.50	E	CARBONATOR #BH-128 (EX.)	20	38		
39	20	BAG-N-BOX (EX.)	E	0.30	EXISTING		1.12		2#12, #12G, 3/4"C	0.82	E	33" COLD RAIL #438LR	20	40		
41	20	BAG-N-BOX (EX.)	E	0.30	EXISTING			0.30				SPARE	20	42		
TOTAL CONNECTED LOAD (KVA)						12.10	12.84	13.16								

ELECTRICAL PANEL SCHEDULE GENERAL NOTES:

- ALL ARE EXISTING BREAKERS UNLESS OTHERWISE NOTED.
- ALL CIRCUITING SHOWN IS FOR REFERENCE PURPOSE ONLY. E.C. SHALL VERIFY CIRCUITING OF THE EXISTING DEVICES IN FIELD AND INFORM ENGINEER FOR ANY DISCREPANCIES.
- ELECTRICAL CONTRACTOR TO VERIFY THE EXACT PANEL SIZES AND INCOMING FEEDER SIZE.
- ELECTRICAL CONTRACTOR SHALL VERIFY EXACT CIRCUIT NUMBER & BREAKER SIZE OF EXISTING DEVICES IN FIELD.
- E.C. SHALL PROVIDE NEW CIRCUIT BREAKERS IN PLACE OF EXISTING CIRCUIT BREAKERS WHEREVER NECESSARY TO BE IN LINE WITH THE PANEL SCHEDULE.
- E.C. SHALL VERIFY THE EXISTING EQUIPMENT LOAD & RATINGS IN FIELD AND ACCORDINGLY CONSIDER THE ELECTRICAL LOAD IN PANEL BOARD SCHEDULE.
- E.C. SHALL COORDINATE WITH OWNER FOR THE EXISTING TO REMAIN EQUIPMENTS WHOSE ELECTRICAL CONNECTIONS NEED TO BE MAINTAINED.
- E.C. SHALL VERIFY THE EXISTING BREAKER RATING AND SIZES IN FIELD AND ACCORDINGLY UPDATE THE PANEL SCHEDULE TO MATCH THE EQUIPMENT REQUIREMENTS.
- ALL SINGLE-PHASE RECEPTACLES RATED 50A AND 150V TO GROUND OR LESS, AND THREE PHASE RECEPTACLES RATED 100A AND 150V TO GROUND OR LESS INSTALLED IN THE BATHROOMS, KITCHEN,ROOFTOPS & OUTDOORS SHALL HAVE "GFCI" PROTECTION FOR PERSONNEL PER NEC 2020, 210.8(B).
- FOR KITCHEN EQUIPMENT SCHEDULE REFER TO ARCHITECTURAL SHEET K-801 & K-802. E.C. SHALL VERIFY AND PROVIDE THE EXACT ELECTRICAL REQUIREMENT INCLUDING RECEPTACLE, PLUG, CORD, CIRCUIT BREAKER AND CABLES FOR ALL THE KITCHEN EQUIPMENTS IN COORDINATION WITH EQUIPMENT SUPPLIER/MANUFACTURER IN FIELD. BASE BID ACCORDINGLY.

1 ELECTRICAL PANEL SCHEDULE
SCALE: N.T.S.

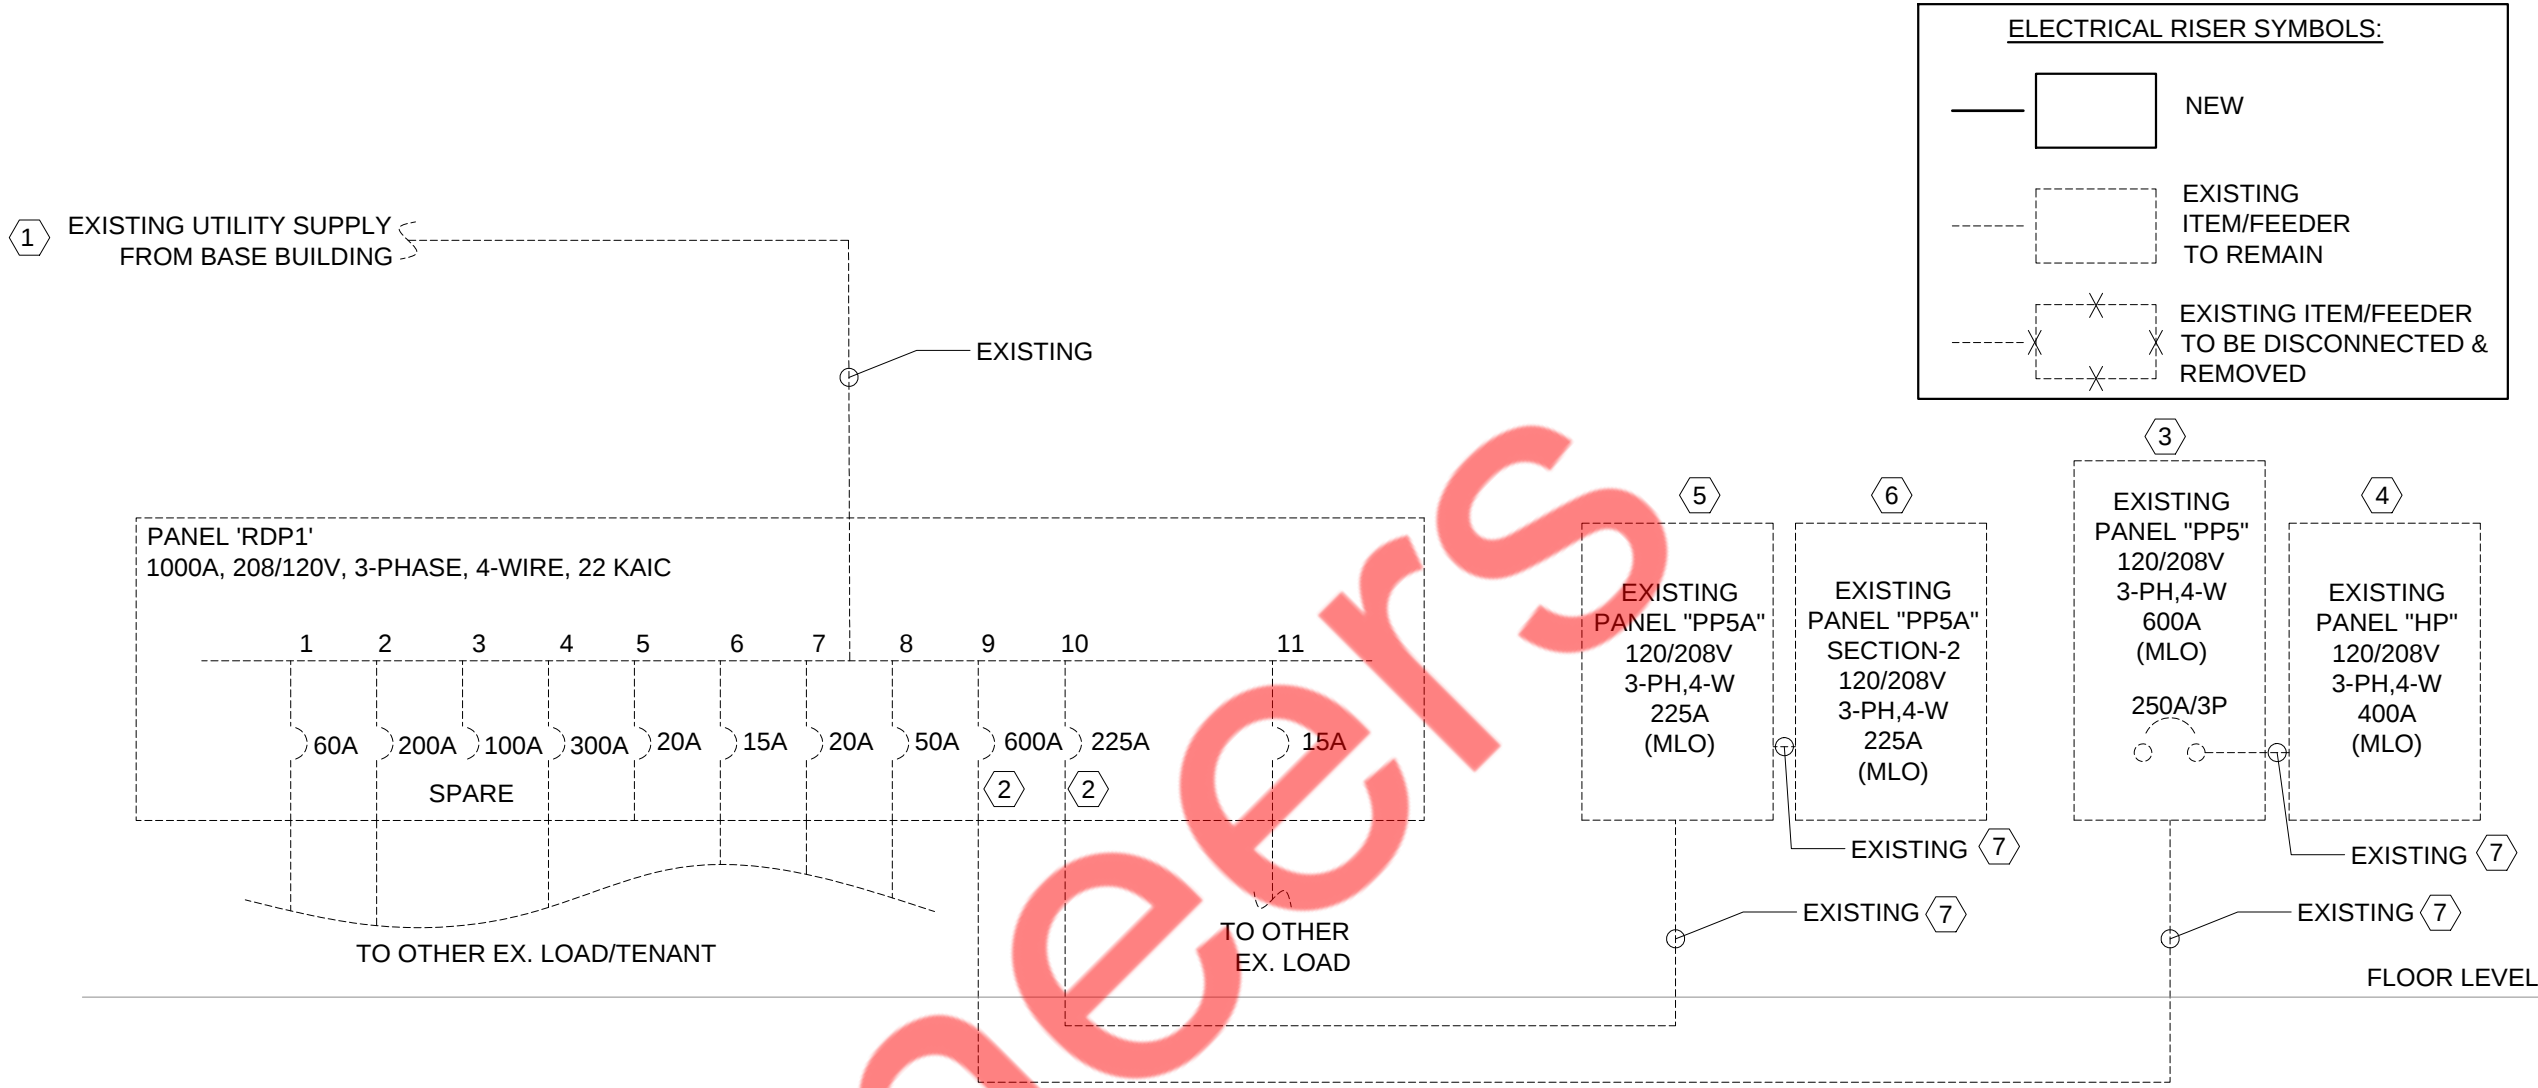

ELECTRICAL RISER DIAGRAM GENERAL NOTES:

- E.C. SHALL VERIFY THE INCOMING SERVICE AMPERAGE, VOLTAGE, NUMBER OF PHASES, WIRE SIZE AND DISTRIBUTION IN FIELD.
- E.C. TO COORDINATE FAULT CURRENT (ISC) RATING WITH UTILITY COMPANY AND AHJ PRIOR TO COMMENCING ANY WORK.
- E.C. SHALL VERIFY THE EXACT POWER DISTRIBUTION & INCOMING CONNECTION TO ALL PANELS IN FIELD. INFORM ENGINEER FOR ANY DISCREPANCY FOUND.

ELECTRICAL RISER DIAGRAM KEY NOTES: (H)

- EXISTING 120/208V, 3-PHASE, 4-WIRE, ELECTRICAL SERVICE SHALL REMAIN. E.C SHALL VERIFY EXACT ELECTRICAL DISTRIBUTION/INCOMING LOCATION/RATING/VOLTAGE/PHASE/WIRE OF EXISTING ELECTRICAL SERVICE IN FIELD WITH ARCHITECT/OWNER. INFORM ENGINEER ON RECORD FOR ANY DISCREPANCY BEFORE COMMENCING ANY WORK. BASE BID ACCORDINGLY.
- EXISTING 600A AND 225A 120/208V, 3-PHASE, 4-WIRE DISCONNECT SWITCHES IN THE RDP-1 FOR THE PROJECT SPACE SHALL REMAIN. E.C TO FIELD VERIFY THE EXACT LOCATION, SIZE & OPERABLE CONDITION OF DISCONNECT SWITCH, REPLACE IF INOPERABLE. BASE BID ACCORDINGLY.
- EXISTING 600A (MLO), 120/208V, 3-PHASE, 4-WIRE ELECTRICAL PANEL "PP5" SHALL REMAIN. E.C. SHALL VERIFY EXACT RATING, LOCATION AND THE OPERABLE CONDITION OF EXISTING ELECTRICAL PANEL "PP5" IN FIELD. INFORM ENGINEER FOR ANY DISCREPANCY FOUND. BASE BID ACCORDINGLY.
- EXISTING 400A (MLO), 120/208V, 3-PHASE, 4-WIRE ELECTRICAL PANEL "HP" SHALL REMAIN. E.C. SHALL VERIFY EXACT RATING, LOCATION AND THE OPERABLE CONDITION OF EXISTING ELECTRICAL PANEL "HP" IN FIELD. INFORM ENGINEER FOR ANY DISCREPANCY FOUND. BASE BID ACCORDINGLY.
- EXISTING 225A (MLO), 120/208V, 3-PHASE, 4-WIRE ELECTRICAL PANEL "PP5A" SHALL REMAIN. E.C. SHALL VERIFY EXACT RATING, LOCATION AND THE OPERABLE CONDITION OF EXISTING ELECTRICAL PANEL "PP5A" IN FIELD. INFORM ENGINEER FOR ANY DISCREPANCY FOUND. BASE BID ACCORDINGLY.
- EXISTING 225A (MLO), 120/208V, 3-PHASE, 4-WIRE ELECTRICAL PANEL "PP5A" SECTION 2 SHALL REMAIN. E.C. SHALL VERIFY EXACT RATING, LOCATION AND THE OPERABLE CONDITION OF EXISTING ELECTRICAL PANEL "PP5A" SECTION 2 IN FIELD. INFORM ENGINEER FOR ANY DISCREPANCY FOUND. BASE BID ACCORDINGLY.
- EXISTING ELECTRICAL FEEDER SHALL REMAIN. E.C. SHALL VERIFY THE RATING, CONDUIT SIZE AND OPERABLE CONDITION OF EXISTING ELECTRICAL FEEDER IN FIELD. REPLACE IF FOUND INOPERABLE. BASE BID ACCORDINGLY.

2 ELECTRICAL RISER DIAGRAM
SCALE: N.T.S.

PANEL: PP5A SECTION 2(EXISTING)										MOUNTING: SURFACE				
208Y/120		VOLTS,	3	PHASE,	4	WIRE		PANEL LOCATION: BOH OF CHICK- FIL-A AREA						
MAIN CB: NA		MLO: 225 A		BUS: EXISTING		MIN,		FED FROM: EXISTING PP5A						
NOTE: L : LIGHTING, H : HVAC LOAD, M : MOTOR LOAD, R : RECEPTACLES, O : OTHER/ MISC. (TYPICAL), * - NEW BREAKER, **- GFI BREAKER														
CKT NO.	TRIP AMPS	DESCRIPTION OF LOAD	LOAD TYPE	LOAD (KVA)	MINIMUM BRANCH CIRCUIT	PER PHASE (KVA)			MINIMUM BRANCH CIRCUIT	LOAD (KVA)	LOAD TYPE	DESCRIPTION OF LOAD	TRIP AMPS	CKT NO.
						A	B	C						
43	20	CFA BOH LIGHTING (EX.)	L	0.50	EXISTING	3.25			EXISTING	2.75	E	RADIANT TOASTER #500BR (EX.)	2P-30	44
45	25	CFA SERVICE LIGHTING (EX.)	L	0.50	EXISTING		3.25		EXISTING	2.75	E	ORDER MONITOR #183R (EX.)	20	46
47	20	CFA SIGNAGE (EX.)	L	1.00	EXISTING			1.54	EXISTING	0.54	R	HOLDING CAB #564AR (EX.)	20	50
49	20	FRY HOLDING STATION (EX.)	E	0.80	EXISTING	1.60			EXISTING	0.80	E	TOASTER #500AR (EX.)	20	52
51	20	ICE BIN / BEV-DISP #315 (EX.)	E	0.50	EXISTING		2.30		EXISTING	1.80	E	HOLDING CAB #580	20	54
53	20	ICE BIN / BEV-DISP #315 (EX.)	E	0.50	EXISTING			1.50	EXISTING	1.00	E	GENERAL RECEPTACLES (EX.)	20	56
55	20	ICE BIN / BEV-DISP #315 (EX.)	E	0.50	EXISTING	1.04			EXISTING	0.54	R	FREEZER #400R (EX.)	20	58
57	2P-20	UNDER COUNTER RECEPT. (EX.)	R	1.00	EXISTING		2.10		EXISTING	1.10	E	EF-1 (EX.)	20	60
59			R	1.00			1.50	EXISTING	0.50	M	FREEZER #400R (EX.)	20	62	
61	20	RECEIPT PRINTER & ORDER MONITOR #182 & 183	R	0.36	2#12, #12G, 3/4"C	1.46			EXISTING	1.10	E	GENERAL RECEPTACLES (EX.)	20	64
63	20	LABEL PRINTER #182L	R	0.36	2#12, #12G, 3/4"C		1.26		EXISTING	0.90	R	GENERAL RECEPTACLES (EX.)	20	66
65	20	HOT HOLDING TOWER #562AR (EX.)	E	1.80	2#12, #12G, 3/4"C			2.52	EXISTING	0.72	R	SINGLE UPRIGHT REFRIGERATOR #442WCL	20**	68
67	20*	FUTURE LABEL PRINTER & FUTURE ORDER MONITOR #F182L & F183	R	0.72	2#12, #12G, 3/4"C	1.53			2#12, #12G, 3/4"C	0.81	E	FUTURE SINGLE UPRIGHT CABINET #F445L	20*	70
69	20*	VISUAL HOT HOLDING CABINET #580H	E	1.92	2#12, #12G, 3/4"C		3.76		2#12, #12G, 3/4"C	1.84	E	GENERAL RECEPTACLES (NEW)	20*	72
71	10 20*	ICE BATH BREADING TABLE #440C	E	0.12	2#12, #12G, 3/4"C		0.48		2#12, #12G, 3/4"C	0.36	R	FLUTE BOWLING SHAPER #F118M	20*	74
73	20*	FLY LIGHT #211B	E	0.01	2#12, #12G, 3/4"C	1.16			2#12, #12G, 3/4"C	1.16	E	OFFICE SAFE #6668R	20*	76
75	20*	ICE BATH BREADING TABLE #440C	E	0.12	2#12, #12G, 3/4"C		0.30		2#12, #12G, 3/4"C	0.18	R	CHANCE SAFE #6669R	20*	78
77		SPACE					0.18					SPACE		80
79		SPACE				0.00						SPACE		82
81		SPACE					0.00					SPACE		84
83		SPACE						0.00				SPACE		
TOTAL CONNECTED LOAD (KVA)						10.04	12.97	7.72						

PLUMBING SYMBOLS LIST

----	COLD WATER PIPING
----	EXISTING COLD WATER PIPING
----	HOT WATER PIPING
----	EXISTING HOT WATER PIPING
----	FILTERED WATER
----	EXISTING FILTERED WATER
----	SANITARY PIPING
----	EXISTING SANITARY PIPING
----	VENT PIPING
----	BACKFLOW PREVENTER
----	P-TRAP
----	PIPE UP
----	PIPE DROP
----	PLUGGED OUTLET/CLEANOUT
----	FLOOR SINK
----	FLOOR DRAIN
----	SHUT-OFF VALVE
----	POINT OF NEW CONNECTION

PLUMBING ABBREVIATIONS

CO	CLEANOUT
CW	COLD WATER
HW	HOT WATER
HWR	HOT WATER RETURN
FW	FILTERED WATER
SAN	SANITARY
V	VENT
W	WASTE
LAV	LAVATORY
WC	WATER CLOSET
TYP.	TYPICAL
DN	DOWN
WCO	WALL CLEANOUT
EXIST./EX.	EXISTING
FD	FLOOR DRAIN
GC	GENERAL CONTRACTOR

PLUMBING DRAWING LIST

P-001	PLUMBING SYMBOLS, ABBREVIATIONS, NOTES & SPECIFICATIONS
P-002	PLUMBING SPECIFICATIONS
P-100	PLUMBING WATER PLAN
P-101	PLUMBING SANITARY PLAN
P-300	PLUMBING DETAILS
P-400	PLUMBING RISERS & SCHEDULES

BUILDING DEPARTMENT PLUMBING NOTES

- ALL PLUMBING SYSTEMS (SANITARY, WASTE, VENT, WATER) AND ASSOCIATED EQUIPMENT SHALL BE INSTALLED, OPERATED AND MAINTAINED IN ACCORDANCE WITH THE REQUIREMENTS OF 2021 NEW JERSEY PLUMBING CODE (NSPC 2021).
- INSTALLATION OF UNDERGROUND PIPING SHALL BE IN ACCORDANCE WITH THE REQUIREMENTS OF SECTION 2.6.6.
- PROTECTION OF PIPING AND PLUMBING SYSTEM COMPONENTS AS PER SECTION 2.9
- TRENCHING, EXCAVATION AND BACKFILL AS PER SECTION PC 2.6.
- MATERIALS USED IN PLUMBING SYSTEMS SHALL BE IN ACCORDANCE WITH THE REQUIREMENTS CHAPTER 3.
- EQUIPMENT CONNECTIONS AND JOINING OF PIPING SHALL BE IN ACCORDANCE WITH THE REQUIREMENTS OF CHAPTER 4
- DEEP SEAL TRAPS FOR FLOOR DRAINS AND CLEAN-OUTS SHALL BE INSTALLED IN ACCORDANCE WITH THE REQUIREMENTS OF CHAPTER 5.
- DRAINAGE PIPE CLEANOUTS AS PER SECTION 5.4.
- VERTICAL AND HORIZONTAL PIPING SHALL BE SUPPORTED IN ACCORDANCE WITH THE REQUIREMENTS OF SECTION 8.2 AND 8.3.
- WATER SUPPLY SYSTEMS SHALL BE INSTALLED AND MAINTAINED IN ACCORDANCE WITH THE REQUIREMENTS OF CHAPTER 10.
- THE SANITARY DRAINAGE SYSTEM SHALL BE SIZED AND INSTALLED IN ACCORDANCE WITH THE REQUIREMENTS OF CHAPTER 11.
- VENT PIPING FOR THE SANITARY DRAINAGE SYSTEM SHALL BE INSTALLED IN ACCORDANCE WITH THE REQUIREMENTS OF CHAPTER 12.
- INSPECTION AND TESTING OF PLUMBING SYSTEMS SHALL BE IN ACCORDANCE WITH CHAPTER 15.

PLUMBING SPECIFICATIONS

- BASIC PLUMBING REQUIREMENTS, MATERIALS AND METHODS
- 1.01 SCOPE
- A. PROVIDE ALL MATERIAL, TOOLS, SUPERVISION AND LABOR INCLUDING ALL MISCELLANEOUS AND INCIDENTAL ITEMS REQUIRED FOR COMPLETE AND OPERABLE PLUMBING INSTALLATIONS AS SHOWN OR DESCRIBED ON THE DRAWINGS AND IN THESE SPECIFICATIONS.
- B. THE CONTRACTOR SHALL BE RESPONSIBLE FOR THE PROTECTION OF ALL NEW CONDITIONS AND MATERIALS WITHIN THE CONSTRUCTION AREA. ANY DAMAGE CAUSED BY THE CONTRACTOR SHALL BE REPAIRED TO THE OWNER'S SATISFACTION.
- C. OBTAIN ALL PERMITS, PAY ALL PERMIT FEES AND SCHEDULE ALL REQUIRED INSPECTIONS. COPIES OF ALL PERMITS AND INSPECTION CERTIFICATES SHALL BE FORWARDED TO THE OWNER FOR RECORD.
- D. THE GENERAL CONDITIONS OF THE CONTRACT AND ALL DIVISION 1 REQUIREMENTS APPLY TO THE WORK OF THIS SECTION.
- E. THE CONTRACTOR SHALL VISIT THE SITE PRIOR TO SUBMITTING BID TO DETERMINE CONDITIONS AND THE EXTENT OF THE WORK. BY COMMENCING WORK, THE CONTRACTOR ACKNOWLEDGES HIS CONFIRMATION OF ALL CONDITIONS AS ACCEPTABLE WITH REFERENCE TO HIS CONTRACT, SCOPE OF WORK AND BID PRICE SUCH THAT NO ADDITIONAL COMPENSATION SHALL BE FORTHCOMING FOR UNFORESEEN EXISTING CONDITIONS.
- F. IN ALL AREAS SUBJECT TO FREEZING CONDITIONS, THE CONTRACTOR SHALL PROVIDE FREEZE PROTECTION FOR ALL DOMESTIC WATER PIPING INSTALLED UNDER HIS CONTRACT.
- G. ALL ELECTRICAL REQUIREMENTS SHALL BE COORDINATED WITH THE CONTRACTOR FOR ELECTRICAL WORK. THIS CONTRACTOR IS RESPONSIBLE FOR ALL LOW VOLTAGE WIRING FOR EQUIPMENT INSTALLED UNDER HIS CONTRACT. THE CONTRACTOR FOR ELECTRICAL WORK IS RESPONSIBLE FOR LINE VOLTAGE POWER WIRING ONLY.
- H. COLOR AND FINISH SELECTIONS FOR ALL MATERIALS, INCLUDING PAINTING OF PIPING, SHALL BE AS DIRECTED AND/OR APPROVED BY THE ARCHITECT.
- I. MINOR DETAILS NOT SHOWN OR SPECIFIED, BUT NECESSARY FOR THE PROPER AND ACCEPTABLE CONSTRUCTION, INSTALLATION OR OPERATION OF ANY PART OF THE WORK AS DETERMINED BY THE ENGINEER SHALL BE INCLUDED AS IF SPECIFIED OR INDICATED ON THE DRAWINGS.
- J. THIS CONTRACTOR SHALL BE RESPONSIBLE FOR COORDINATING ALL REQUIREMENTS FOR THE INSTALLATION, CONNECTION, EXTENSION OR MODIFICATION TO ALL UTILITY SERVICES WITH RESPECTIVE PROVIDERS INCLUDING PAYMENT OF ALL ASSOCIATED FEES.
- K. THE CONTRACTOR IS RESPONSIBLE FOR ALL PAINTING ASSOCIATED WITH CUTTING AND PATCHING. ALL PAINTING IN AREAS WITH COMPLETE FINISH RENOVATIONS SHALL BE PROVIDED BY THE GENERAL CONTRACTOR.

1.02 SUBMITTALS

A. SUBMITTAL REQUIREMENTS SHALL BE COORDINATED WITH THE ARCHITECT AND AUTHORITIES HAVING JURISDICTION, UNLESS OTHERWISE DIRECTED, CONTRACTOR SHALL PROVIDE SUBMITTALS AS LISTED BELOW.

- PIPE AND FITTINGS
- VALVES
- HANGERS AND SUPPORTS
- PLUMBING PIPING LAYOUT
- TESTS
- PLUMBING FIXTURES
- FLOOR DRAINS
- MIXING VALVES
- ALL SCHEDULED PLUMBING EQUIPMENT.

B. SUBMITTALS FROM SUPPLIERS OR MANUFACTURERS WHICH DO NOT BEAR THE STAMP OF THE SUBMITTING CONTRACTOR INDICATING THAT THE CONTRACTOR HAS REVIEWED THE SUBMITTAL FOR CONFORMANCE WITH THE PROJECT REQUIREMENTS WILL BE RETURNED REJECTED.

C. THE ENGINEER'S REVIEW OF SUBMITTALS IS A COURTESY WHICH DOES NOT RELIEVE THE CONTRACTOR FROM CONFORMING WITH THE CONSTRUCTION DOCUMENTS, REGARDLESS OF THE ACTION INDICATED BY THE SHOP DRAWINGS STAMP.

D. REVIEW OF SHOP DRAWINGS BY THE ENGINEER SHALL BE LIMITED TO THE INITIAL REVIEW, AND A SECOND REVIEW OF ANY REQUIRED RESUBMITTED DATA. IF THE ENGINEER IS REQUIRED TO REVIEW SHOP DRAWINGS FOR A THIRD (OR MORE) SUBMISSION OF THE SAME ITEM, THE CONTRACTOR SHALL BE LIABLE FOR COMPENSATING THE ENGINEER FOR THESE SUBSEQUENT REVIEWS AS PER THE ENGINEER'S CURRENT HOURLY RATE SCHEDULE.

E. SUBMIT PROOF OF APPROVAL AND/OR CONFIRMATION OF SATISFACTORY TEST RESULTS TO THE OWNER AND THE ARCHITECT.

F. SUBMIT TO THE OWNER'S MAINTENANCE PERSONNEL OPERATION AND MAINTENANCE DATA FOR ALL SYSTEM COMPONENTS, SERVICING REQUIREMENTS, INSPECTION DATA, REPLACEMENT PART NUMBERS AND AVAILABILITY AND CONTACT INFORMATION FOR SERVICE/SUPPLY COMPANY.

G. FOR ALL BELOW GRADE PIPING WHERE ACTUAL INSTALLATION DEVIATES FROM CONSTRUCTION DRAWINGS, THE CONTRACTOR SHALL PROVIDE AS-BUILT DRAWINGS INDICATING BELOW GRADE PIPE LOCATIONS DIMENSIONED TO NEAREST COLUMN LINES.

H. RECORD AS-BUILT DRAWINGS SHALL BE SUPPLIED TO THE OWNER/TENANT AFTER COMPLETION OF THE WORK SHOWING ANY ALTERATIONS, ADDITIONS AND/OR DELETIONS TO THE SYSTEM(S) INSTALLED.

1.03 SUBSTITUTIONS

A. ALL EQUIPMENT SHALL BE PRODUCTS OF THE SPECIFIED MANUFACTURER OR MANUFACTURERS. ALL BIDS SHALL BE BASED ON THE SPECIFIED MANUFACTURER OR MANUFACTURERS EQUIPMENT. FOR SUBSTITUTIONS OF OTHER MANUFACTURER'S EQUIPMENT TO BE CONSIDERED, THE SUBSTITUTION MUST BE INDICATED PRIOR TO BIDDING WITH THE REASON FOR THE PROPOSED SUBSTITUTION IDENTIFIED, AND THE PROPOSED CREDIT TO THE OWNER INDICATED. THE ENGINEER SHALL DETERMINE THE ACCEPTABILITY OF ANY PROPOSED SUBSTITUTIONS.

B. THE CONTRACTOR ASSUMES ALL RESPONSIBILITY FOR COORDINATING THE WORK OF OTHER TRADES WHICH MAY BE AFFECTED BY SUBSTITUTIONS, INCLUDING ALL RELATED COSTS.

1.04 DEFINITIONS

A. FURNISH: TO PURCHASE, PROCURE, ACQUIRE AND DELIVER, COMPLETE WITH RELATED ACCESSORIES.

B. INSTALL: TO ERECT, MOUNT AND CONNECT, COMPLETE WITH RELATED ACCESSORIES.

C. PROVIDE: TO FURNISH AND INSTALL.

D. PLUMBING CONTRACTOR, THE CONTRACTOR, THIS CONTRACTOR: THE CONTRACTOR FOR PLUMBING WORK WHICH IS SPECIFIED HEREIN AND SHOWN ON THESE DRAWINGS.

E. REFER TO THE NATIONAL STANDARD PLUMBING CODE 2021 FOR ADDITIONAL DEFINITIONS.

1.05 DRAWINGS

A. THE DRAWINGS ARE DIAGRAMMATIC AND ARE INTENDED TO ILLUSTRATE THE GENERAL ARRANGEMENT AND ROUTING OF PIPING AND GENERAL LOCATIONS OF EQUIPMENT. PRECISE LOCATIONS OF EQUIPMENT, RISERS AND STACKS, AND ROUTING AND ELEVATION OF ALL PIPING SYSTEMS SHALL BE COORDINATED IN THE FIELD WITH THE ARCHITECT, ARCHITECTURAL DRAWINGS, THE WORK OF OTHER TRADES, EXISTING AND NEW BUILDING CONDITIONS AND/OR THE PREFERENCES OF THE OWNERTENANT AS CONSTRUCTION PROCEEDS. ALL PIPING SHALL BE INSTALLED CONCEALED IN FINISHED SPACES, UNLESS NOTED OTHERWISE.

B. PROVIDE ALL NECESSARY INCIDENTAL MATERIALS AND ACCESSORIES REQUIRED TO MAKE THE WORK COMPLETE IN ALL RESPECTS, EVEN IF NOT PARTICULARLY SHOWN OR SPECIFIED.

C. REFER TO PLUMBING EQUIPMENT/FIXTURE SCHEDULE ON THE DRAWINGS FOR ALL FIXTURE AND EQUIPMENT SPECIFICATIONS.

D. REFER TO FIXTURE CONNECTION SIZE SCHEDULE FOR ALL FIXTURE ROUGHING SIZE REQUIREMENTS.

E. VERIFY ALL INDICATED CONDITIONS BEFORE STARTING WORK AND REPORT ANY DISCREPANCIES. THE DRAWINGS REFLECT CONDITIONS WHICH CAN BE REASONABLY INTERPRETED FROM THE EXISTING VISIBLE CONDITIONS OR FROM DRAWINGS AND INFORMATION FURNISHED BY THE OWNER.

F. LOCATE ALL FIXTURES AND EQUIPMENT AS PER THE FINAL ARCHITECTURAL DRAWINGS.

1.06 PRODUCTS

A. SANITARY AND VENT PIPING:

- ABOVE GRADE PIPING SHALL BE HUBLESS CAST IRON PIPE WITH STAINLESS STEEL COUPLINGS AND ELASTOMERIC GASKETS WITH A MINIMUM NO. OF BANDS PER COUPLING AS PER CISPI 310-12.
- SLOPE OF DRAINAGE SYSTEM SHALL BE 1/8" PER FOOT OF RUN FOR PIPE OVER 3" (I.D.) AND 1/4" PER FOOT OF RUN FOR PIPE 3" AND SMALLER (I.D.). VENT PIPING SHALL BE PITCHED TO DRAIN.
- ALL CAST IRON SOIL PIPE AND FITTINGS SHALL BE MARKED WITH THE COLLECTIVE TRADEMARK OF THE CAST IRON SOIL PIPE INSTITUTE (CISPI) AND BE LISTED BY NSF INTERNATIONAL.

B. DOMESTIC WATER PIPING:

- ABOVE GRADE WATER PIPING SHALL BE TYPE 'L' HARD-DRAWN COPPER TUBE.
- FITTINGS IN DOMESTIC WATER PIPING SHALL BE WROUGHT COPPER OR CAST BRASS.
- JOINTS SHALL BE MADE WITH LEAD-FREE SOLDER.
- THE ENTIRE DOMESTIC WATER DISTRIBUTION SYSTEM SHALL BE INSULATED INCLUDING ALL VALVES, FITTINGS, ETC.
- COMPLY WITH NSF 61 FOR MATERIALS FOR WATER-SERVICE PIPING AND SPECIALTIES FOR DOMESTIC WATER.
- ALL DOMESTIC WATER PIPING ABOVE GRADE SHALL BE INSULATED WITH FIRE RETARDANT, FACTORY-APPLIED JACKET. PROVIDE COLD WATER PIPING WITH FACTORY-APPLIED VAPOR BARRIER. INSULATION REQUIREMENT SHOULD COMPLY WITH ASHRAE 90.1 2019 SECTION ENERGY CONSERVATION CODE 7.4.3 BELOW TABLE.

MINIMUM PIPE INSULATION THICKNESS							
FLUID OPERATING TEMPERATURE RANGE AND USAGE (°F)	INSULATION CONDUCTIVITY BTU IN./ FT2 °F	NOMINAL PIPE OR TUBE SIZE (INCHES)					
		CONDUCTIVITY	MEAN RATING	1 to < 1 1/2	1 1/2 to < 2	2 to < 4	4 to < 8
141-200	0.25-0.29	125	1.5	1.5	2	2	2
105-140	0.21-0.28	100	1.0	1.0	1.5	1.5	1.5
40-60	0.21-0.27	75	0.5	0.5	1.0	1.0	1.0

7. AS PER ASHRAE 90.1 2019 SECTION 7.4.4.1, TEMPERATURE CONTROLS SHALL BE PROVIDED THAT ALLOW FOR STORAGE TEMPERATURE ADJUSTMENT FROM 120° OR LOWER TO A MAXIMUM TEMPERATURE COMPATIBLE WITH THE INTENDED USE.

8. AS PER ASHRAE 90.1 2019 SECTION 7.4.4.2, SYSTEM DESIGNED TO MAINTAIN USAGE TEMPERATURE IN HOT WATER PIPES, SUCH AS RECIRCULATING HOT WATER SYSTEMS OR HEAT TRAPS, SHALL BE EQUIPED WITH AUTOMATIC TIME SWITCHES OR OTHER CONTROLS THAT CAN BE USED TO SWITCH THE USAGE TEMPERATURE MAINTAINANCE SYSTEM DURING EXTENDED PERIOD WHEN HOT WATER IS NOT REQUIRED.

9. AS PER ASHRAE 90.1 2019 SECTION 7.4.4.3, TEMPERATURE CONTROLLING MEANS SHALL BE PROVIDED TO LIMIT THE MAXIMUM TEMPERATURE OF WATER DELIVERED FROM LAVATORY FAUCETS IN PUBLIC FACILITY RESTROOMS TO 110°F.

10. SEAL ALL JOINTS BETWEEN SEGMENTS OF INSULATION.

11. PROVIDE SHIELDS BETWEEN HANGERS AND INSULATION.

C. HANGERS AND SUPPORTS:

- HANGERS SHALL BE STANDARD STEEL, MALLEABLE OR WROUGHT IRON, AS MANUFACTURED BY GRINNELL OR APPROVED EQUAL. SUITABLE FOR THE TYPE OF CONSTRUCTION. PIPING SHALL NOT BE HUNG FROM OTHER PIPE.
- SECTIONS OF INDIVIDUAL PIPE RUNS SHALL BE SUPPORTED BY CLEVIS HANGERS.
- ALL EQUIPMENT SHALL BE PROVIDED WITH APPROVED SUPPORTS.
- PROVIDE SEISMIC RESTRAINTS IN ACCORDANCE WITH ALL APPLICABLE FEDERAL, STATE AND LOCAL CODES AND STANDARDS AND THE REQUIREMENTS OF AUTHORITIES HAVING JURISDICTION.
- UNLESS OTHERWISE INDICATED OR REQUIRED BY AUTHORITIES HAVING JURISDICTION, THE FOLLOWING SHALL BE PROVIDED WITH SEISMIC RESTRAINTS AS REQUIRED BY THE BOCA NATIONAL BUILDING CODE, SECTION 1610.6.4: ALL EQUIPMENT AND MACHINERY, ALL NEW PIPING 2-1/2" AND LARGER (1-1/4" AND LARGER INBOILER/MECHANICAL ROOMS) WITH HANGERS GREATER THAN 12" IN LENGTH FROM THE TOP OF PIPE TO THE STRUCTURE.
- SUPPORTS SHALL BE PROVIDED IN STRICT ACCORDANCE WITH THE RECOMMENDATIONS OF THE PIPING MANUFACTURER.

D. VALVES:

- PROVIDE GATE VALVES, BUTTERFLY OR BALL VALVES FOR SHUT-OFF DUTY ON MAIN AND BRANCH SUPPLY LINES. FOR ALL PIPE RUNS 2" AND SMALLER, PROVIDE BALL FOR ALL PIPE RUNS LARGER THAN 2" AND SMALLER THAN 4", PROVIDE GATE VALVES. PIPING 4" AND LARGER, PROVIDE BUTTERFLY VALVES FOR SHUT-OFF DUTY.
- ALL FIXTURES WITH THE EXCEPTION O FLUSHOMETER-EQUIPPED WATER CLOSETS AND URINALS SHALL HAVE STOP VALVES TO CONTROL SUPPLY TO THE FIXTURE. WHERE SUPPLIES ARE EXPOSED PROVIDE CHROME-PLATED STOPS WITH CHROME-PLATED ESCUTCHEONS ON PIPING PENETRATIONS.
- ALL PLUMBING FIXTURES AND EQUIPMENT TO HAVE SHUT-OFF VALVES ON SUPPLY LINES.
- ALL BRANCH LINES TO HAVE SHUT-OFF VALVES.
- ALL VALVES SHALL BE ACCESSIBLE. PROVIDE ACCESS DOORS WHERE REQUIRED FOR VALVE ACCESS.
- PROVIDE GLOBE VALVES FOR THROTTLING/BALANCING OF THE HOT WATER CIRCULATING SYSTEM.

E. SLEEVES AND ESCUTCHEONS:

- SLEEVES THROUGH STRUCTURAL CONCRETE MEMBERS AND SLEEVES FOR WALLS BELOW GRADE AND FLOORS ON GRADE SHALL BE STANDARD WEIGHT GALVANIZED SCHEDULE 40 STEEL PIPE. SLEEVES THROUGH OTHER THAN STRUCTURAL COMPONENTS OF THE BUILDING SHALL BE 20 GAGE GALVANIZED SHEET METAL WITH LOCK SEAM JOINTS. USG THERMAFIBER SAFING INSULATION SHALL BE INSTALLED BETWEEN PIPE AND SLEEVE.
- PIPE ESCUTCHEON PLATES SHALL BE INSTALLED WHERE EXPOSED PIPING PASSES THROUGH WALLS, CEILINGS, AND FLOORS AND SHALL BE MINIMUM 20 GAGE STEEL. PROVIDE CHROME PLATED ESCUTCHEON PLATES IN FINISHED AREAS.

F. DRAINAGE ACCESSORIES

1. GENERAL:
a. INSTALL THE WORK OF THIS SECTION IN ACCORDANCE WITH THE MANUFACTURER'S PRINTED INSTALLATION INSTRUCTIONS, UNLESS OTHERWISE SPECIFIED.

b. SECURE EXTERNAL COMPONENTS IN PLACE WITH VANDAL RESISTANT FASTENERS OR DEVICES WHICH CANNOT BE REMOVED WITHOUT SPECIAL TOOLS.

G. INSTALL PIPING TO CONSERVE BUILDING SPACE. DO NOT INTERFERE WITH USE OF BUILDING SPACE AND THE WORK OF OTHER TRADES. ALL PIPING RUN IN CEILING SHALL BE INSTALLED TIGHT TO THE STRUCTURE ABOVE.

H. INSTALL PIPING TO ALLOW FOR EXPANSION AND CONTRACTION WITHOUT STRESSING PIPE, JOINTS OR CONNECTED EQUIPMENT. PROVIDE PIPE ANCHORS, GUIDES AND EXPANSION JOINTS OR LOOPS IN ALL HOT WATER AND HOT WATER CIRCULATING MAIN SUPPLY PIPING AND SEGMENTS OF SUCH PIPE THAT EXCEED 30'-0" IN LENGTH.

I. IN ALL AREAS WITH FINISHED SURFACES, SYSTEM PIPING AND COMPONENTS SHALL BE CONCEALED ABOVE OR WITHIN FINISHED SURFACES.

J. REDUCTIONS IN PIPE SIZES SHALL BE MADE WITH ONE-PIECE REDUCING FITTINGS. BUSHINGS ARE NOT ACCEPTABLE. USE FLANGED FITTINGS AT THE BASE OF RISERS.

K. VENT PENETRATIONS THROUGH THE ROOF SHALL BE FLASHED.

L. IF WATER PRESSURE EXCEEDS 80 PSI, A WATER PRESSURE REDUCING VALVE SHALL BE INSTALLED IN WATER PIPING AT CONNECTION TO MAIN.

M. PROVIDE DIELECTRIC FITTINGS BETWEEN DISSIMILAR METALS.

N. PIPE BACKFLOW PREVENTER DRAINS TO FLOOR DRAIN OR OTHER APPROVED INDIRECT WASTE SOURCE.

O. PROVIDE ACCESS DOORS/PANELS FOR SERVICE AND ACCESS TO ALL VALVES AND OTHER SYSTEM COMPONENTS ENCLOSED IN WALLS AND CEILINGS. ACCESS DOORS SHALL BE FURNISHED BY THIS CONTRACTOR, INSTALLED BY THE GENERAL CONTRACTOR.

P. ALL FIXTURES REQUIRING VACUUM BREAKERS SHALL BE EQUIPPED WITH INTEGRAL VACUUM BREAKERS.

Q. ANY PENETRATIONS THROUGH FIRE RATED PARTITIONS, FLOORS, OR CEILINGS SHALL BE STEEL SLEEVED AND SEALED WITH 3M BRAND UL RATED FIRE BARRIER CAULK OR APPROVED EQUAL.

R. WHEN THE WATER PIPING SYSTEM IS COMPLETE, THOROUGHLY FLUSH ALL DIRT, SEDIMENT, SOLDER, ETC., OUT OF THE SYSTEM. REMOVING ALL STRAINERS, VALVE STEM SEATS, ETC., REQUIRED TO ACCOMPLISH THE FLUSHING.

S. AT ALL INDIRECT WASTE DRAINS, MAINTAIN AIR GAP AS REQUIRED BY CODE.

T. INSTALL SLEEVES FOR ALL PIPES WHICH PASS THROUGH WALLS, FLOORS, AND CEILINGS. WHERE PIPES ARE TO BE INSULATED, THE SLEEVE SHALL BE LARGE ENOUGH TO ACCOMMODATE INSULATION. SLEEVES SHALL BE FLUSH WITH FINISHED SURFACES AT BOTH ENDS. ON FINISHED SURFACES IN EXPOSED AREAS PROVIDE ESCUTCHEONS COMPATIBLE WITH FINISH.

U. PROVIDE WATER HAMMER ARRESTERS ON SUPPLY PIPING TO ALL FLUSHOMETER VALVES AND QUICK-CLOSING VALVES.

V. MAINTAIN ALL REQUIRED AND RECOMMENDED CLEARANCES FOR ALL PLUMBING SYSTEM COMPONENTS AND EQUIPMENT.

ISSUE	DESCRIPTION	DATE
00	INITIAL ISSUE	06/23/2025
01	CLIENT REVISION	01/15/2026

DOB APPROVAL STAMP:

DATE: 06/02/2025
PROJECT NO.: Z166-24
DRAWN BY: NYE
CHECKED BY: NYE
SCALE: AS NOTED

DRAWING TITLE:
PLUMBING SYMBOLS,
ABBREVIATIONS, NOTES &
SPECIFICATIONS

DRAWING NO.:

P-001

2. INSTALLATION
- 2.01 GENERAL
- A. ALL WORK WHICH REQUIRES DISRUPTION OF THE ROOFING SHALL BE DONE BY A CONTRACTOR CERTIFIED BY THE ROOFING MANUFACTURER AS REQUIRED TO MAINTAIN ANY EXISTING ROOF WARRANTIES.

B. EXTERIOR INSTALLATIONS TO BE WEATHER PROOF IN ALL RESPECTS.

C. EXTERIOR MATERIALS AND EQUIPMENT SHALL BE PAINTED TO PREVENT CORROSION, COLOR PER ARCHITECT.

D. COORDINATE THE PLUMBING WORK WITH ALL OTHER AFFECTED WORK AND THE CONSTRUCTION SCHEDULE.

E. REAM PIPE AND TUBE ENDS. REMOVE BURRS. BEVEL PLAIN AND FERROUS END PIPE.

F. REMOVE SCALE AND FOREIGN MATERIAL, FROM INSIDE AND OUTSIDE, BEFORE ASSEMBLY.

G. PREPARE PIPING CONNECTIONS TO EQUIPMENT WITH FLANGES AND UNIONS.

H. COORDINATION WITH THE WORK OF OTHER TRADES IS REQUIRED. PROVIDE OFFSETS IN PIPING SYSTEMS OR MINOR DEVIATIONS TO THE INDICATED PIPE ROUTING IN ORDER TO COORDINATE THE PLUMBING WORK WITH THE WORK OF ALL OTHER TRADES AND THE GENERAL BUILDING CONDITIONS.

I. NO DOMESTIC WATER PIPING SHALL BE INSTALLED IN UNHEATED SPACES.

J. PRIOR TO DISCONNECTING AND CONNECTING NEW WORK TO EXISTING SYSTEMS, THE PLUMBING CONTRACTOR SHALL NOTIFY THE PROPERTY MANAGER AND OFFER A PROPOSED SCHEDULE OF WORK. ESB WILL AUTHORIZE CONNECTIONS AND COORDINATE NECESSARY SHUT DOWNS AND DRAIN DOWNS AS REQUIRED. SHUT DOWNS AND DRAIN DOWNS MAY BE PERFORMED BY THE PLUMBING CONTRACTOR ONLY AFTER RECEIVING ESB AUTHORIZATION, AND SHOULD BE PERFORMED UNDER SUPERVISION OF ESB PERSONNEL. THREE (3) DAYS ADVANCE NOTICE TO THE PROPERTY MANAGER IS REQUIRED.

K. THE PLUMBING CONTRACTOR IS ADVISED THAT DUE TO THE NATURE OF THE OPERATIONS AND TENANT REQUIREMENTS, CONNECTIONS TO EXISTING SYSTEMS MAY HAVE TO BE MADE AFTER REGULAR WORKING HOURS. THE PROPERTY MANAGER WILL ADVISE THE PLUMBING CONTRACTOR OF THE TIME CONSTRAINTS UPON RECEIPT AND APPROVAL OF THE PLUMBING CONTRACTOR'S REQUEST FOR SHUT DOWN AND CONNECTION TO EXISTING SYSTEMS.

L. WHEN CONNECTING TO EXISTING STACKS AND RISERS, PROVISION IS TO BE MADE FOR FUTURE CONNECTIONS BY PROVIDING CAPPED AND VALVED OUTLETS ON DOMESTIC WATER RISERS AND PLUGGED OUTLETS ON THE SANITARY AND VENT STACKS.

2.02 ABOVE GRADE

a. INSTALL PLUMBING PIPING IN ACCORDANCE WITH RECOGNIZED INDUSTRY PRACTICES TO ENSURE THAT PIPING COMPLIES WITH REQUIREMENTS AND SERVES INTENDED PURPOSES.

b. ROUTE PIPING IN AN ORDERLY MANNER, PLUMB AND PARALLEL TO BUILDING STRUCTURE, MAINTAIN GRADIENT, SLOPE PIPING AND ARRANGE SYSTEMS TO DRAIN. IN DOMESTIC WATER SYSTEMS, PROVIDE DRAIN VALVES AT MAIN SHUT-OFF VALVES AND ALL LOW POINTS IN PIPING.

c. USE EXISTING CONNECTIONS AT MAINS WHERE AVAILABLE FOR NEW BRANCH PIPING. LOCATE ALL RISERS AND PIPING BEFORE CONSTRUCTION COMMENCES AND TAKE CARE NOT TO DAMAGE SAME. ANY DAMAGE OCCURRING TO THE EXISTING PIPING WILL BE THE SOLE RESPONSIBILITY OF THE CONTRACTOR.

M. DRAINAGE ACCESSORIES

1. GENERAL:

a. INSTALL THE WORK OF THIS SECTION IN ACCORDANCE WITH THE MANUFACTURER'S PRINTED INSTALLATION INSTRUCTIONS, UNLESS OTHERWISE SPECIFIED.

b. SECURE EXTERNAL COMPONENTS IN PLACE WITH VANDAL RESISTANT FASTENERS OR DEVICES WHICH CANNOT BE REMOVED WITHOUT SPECIAL TOOLS.

N. DEVICES:

a. CLEANOUT & CLEANOUT PLUG
 - THREADED PIPE FITTING OR CAST IRON FERRULE WITH GAS TIGHT CLEANOUT PLUG
 - PLUG SHOULD BE CAST BRASS OR BRONZE, WITH THREADED END, AND RAISED OR COUNTERSUNK HEAD.
 - LUBRICATE THREADS OF CLEANOUT PLUG WITH ANTI-SEIZE LUBRICANT BEFORE FINAL INSTALLATION.

b. CLEANOUT WALL PLATE
 - IT SHOULD BE ROUND, STAINLESS STEEL OR POLISHED CHROME PLATED BRONZE COVER PLATE WITH STAINLESS STEEL VANDAL RESISTANT FASTENER TO SECURE TO CLEANOUT PLUG.

c. CLEANOUT DECK PLATE
 - IT SHOULD BE STANDARD DUTY FLOOR CLEANOUT FITTING WITH COATED CAST IRON BODY; ROUND, POLISHED NICKEL BRONZE SCORiated TOP SECURED TO CLEANOUT PLUG WITH STAINLESS STEEL VANDAL RESISTANT FASTENER; THREADED HEIGHT ADJUSTMENT, CAST IRON HEAD, GAS TIGHT CLEANOUT PLUG, AND CONNECTION TO MATCH PIPING OPTION SELECTED.
 - GRILLE FREE AREA SHOULD BE AT LEAST EQUAL TO CROSS-SECTION AREA OF PIPE TO WHICH CONNECTION MADE AND MADE OF POLISHED NICKEL BRONZE, WITH REMOVABLE GRATE, EITHER PERFORATED OR BAR TYPE. GRATE ATTACHED TO GRILLE BODY WITH VANDAL RESISTANT FASTENER.

O. INSTALL PIPING TO CONSERVE BUILDING SPACE. DO NOT INTERFERE WITH USE OF BUILDING SPACE AND THE WORK OF OTHER TRADES. ALL PIPING RUN IN CEILING SHALL BE INSTALLED TIGHT TO THE STRUCTURE ABOVE.

P. INSTALL PIPING TO ALLOW FOR EXPANSION AND CONTRACTION WITHOUT STRESSING PIPE, JOINTS OR CONNECTED EQUIPMENT. PROVIDE PIPE ANCHORS, GUIDES AND EXPANSION JOINTS OR LOOPS IN ALL HOT WATER AND HOT WATER CIRCULATING MAIN SUPPLY PIPING AND SEGMENTS OF SUCH PIPE THAT EXCEED 30'-0" IN LENGTH.
- Q. IN ALL AREAS WITH FINISHED SURFACES, SYSTEM PIPING AND COMPONENTS SHALL BE CONCEALED ABOVE OR WITHIN FINISHED SURFACES.

R. REDUCTIONS IN PIPE SIZES SHALL BE MADE WITH ONE-PIECE REDUCING FITTINGS. BUSHINGS ARE NOT ACCEPTABLE. USE FLANGED FITTINGS AT THE BASE OF RISERS.

S. VENT PENETRATIONS THROUGH THE ROOF SHALL BE FLASHED.

T. IF WATER PRESSURE EXCEEDS 80 PSI, A WATER PRESSURE REDUCING VALVE SHALL BE INSTALLED IN WATER PIPING AT CONNECTION TO MAIN.

U. PROVIDE DIELECTRIC FITTINGS BETWEEN DISSIMILAR METALS.

V. PIPE BACKFLOW PREVENTER DRAINS TO FLOOR DRAIN OR OTHER APPROVED INDIRECT WASTE SOURCE.

W. PROVIDE ACCESS DOORS/PANELS FOR SERVICE AND ACCESS TO ALL VALVES AND OTHER SYSTEM COMPONENTS ENCLOSED IN WALLS AND CEILINGS. ACCESS DOORS SHALL BE FURNISHED BY THIS CONTRACTOR, INSTALLED BY THE GENERAL CONTRACTOR.

X. ALL FIXTURES REQUIRING VACUUM BREAKERS SHALL BE EQUIPPED WITH INTEGRAL VACUUM BREAKERS.

Y. PIPE BACKFLOW PREVENTER DRAINS TO FLOOR DRAIN OR OTHER APPROVED INDIRECT WASTE SOURCE.

Z. PROVIDE ACCESS DOORS/PANELS FOR SERVICE AND ACCESS TO ALL VALVES AND OTHER SYSTEM COMPONENTS ENCLOSED IN WALLS AND CEILINGS. ACCESS DOORS SHALL BE FURNISHED BY THIS CONTRACTOR, INSTALLED BY THE GENERAL CONTRACTOR.

AA. ALL FIXTURES REQUIRING VACUUM BREAKERS SHALL BE EQUIPPED WITH INTEGRAL VACUUM BREAKERS.

AB. ANY PENETRATIONS THROUGH FIRE RATED PARTITIONS, FLOORS, OR CEILINGS SHALL BE STEEL SLEEVED AND SEALED WITH 3M BRAND UL RATED FIRE BARRIER CAULK OR APPROVED EQUAL.

AC. WHEN THE WATER PIPING SYSTEM IS COMPLETE, THOROUGHLY FLUSH ALL DIRT, SEDIMENT, SOLDER, ETC., OUT OF THE SYSTEM, REMOVING ALL STRAINERS, VALVE STEM SEATS, ETC., REQUIRED TO ACCOMPLISH THE FLUSHING.

AD. AT ALL INDIRECT WASTE DRAINS, MAINTAIN AIR GAP AS REQUIRED BY CODE.

AE. INSTALL SLEEVES FOR ALL PIPES WHICH PASS THROUGH WALLS, FLOORS, AND CEILINGS. WHERE PIPES ARE TO BE INSULATED, THE SLEEVE SHALL BE LARGE ENOUGH TO ACCOMMODATE INSULATION. SLEEVES SHALL BE FLUSH WITH FINISHED SURFACES AT BOTH ENDS. ON FINISHED SURFACES IN EXPOSED AREAS PROVIDE ESCUTCHEONS COMPATIBLE WITH FINISH.

AF. PROVIDE WATER HAMMER ARRESTERS ON SUPPLY PIPING TO ALL FLUSHOMETER VALVES AND QUICK-CLOSING VALVES.

AG. UNLESS OTHERWISE INDICATED, TRAPS SEALS AT ALL FLOOR DRAINS SHALL BE MAINTAINED BY AN APPROVED TRAP PRIMING DEVICE.

AH. MAINTAIN ALL REQUIRED AND RECOMMENDED CLEARANCES FOR ALL PLUMBING SYSTEM COMPONENTS AND EQUIPMENT.

AI. MAINTAIN MINIMUM 10'-0" CLEARANCE BETWEEN ALL PLUMBING V.T.R.S AND ALL OUTDOOR AIR INTAKES. OFFSET VENT STACKS AND STACK VENTS IF AND AS REQUIRED BELOW ROOF TO MAINTAIN SUCH CLEARANCE WHETHER OR NOT SUCH OFFSET IS INDICATED ON THE DRAWINGS. PROVIDE ALL REQUIRED SEISMIC SUPPORTS.

3. TESTING

A. AT THE COMPLETION OF THE PLUMBING WORK, COMPLETELY TEST THE ENTIRE INSTALLATION OF ALL SYSTEMS FOR PROPER OPERATION AND COMPLIANCE WITH APPLICABLE CODES AND LOCAL REQUIREMENTS. CORRECT ALL DEFICIENCIES FOUND.

B. TESTING OF THE INSTALLED SYSTEMS SHALL BE MADE BY THE CONTRACTOR IN THE PRESENCE OF A REPRESENTATIVE OF THE OWNER.

C. THE CONTRACTOR SHALL NOT COVER UP OR PERMANENTLY CONCEAL PIPING, DEVICES OR ANY PORTION OF NEWLY CONSTRUCTED PLUMBING SYSTEM(S) UNTIL SUCH SYSTEM, OR PORTION OF THE SYSTEM, HAS BEEN TESTED IN THE PRESENCE OF A REPRESENTATIVE OF THE OWNER AND INSPECTED BY THE LOCAL INSPECTOR AND APPROVED IN WRITING, EXCEPT PIPING PASSING THROUGH FLOORS, WALLS, PARTITIONS, OR BEAMS, FOR DISTANCES EQUAL TO THE THICKNESS OF SUCH FLOOR, WALL, PARTITION OR BEAM.

D. THIS CONTRACTOR SHALL NOTIFY THE VARIOUS DEPARTMENTS, BUREAUS AND INDIVIDUALS AT LEAST TWO WEEKS IN ADVANCE OF THE TIME THAT THE TESTS ARE TO BE CONDUCTED.

E. ALL DEFECTIVE PARTS SHALL BE REPLACED OR CORRECTED BY THIS CONTRACTOR AND AN EXTRA TEST OR TESTS SHALL BE MADE UNTIL THE OPERATION IS SATISFACTORY. ALL ARRANGEMENTS AND EXPENSES NECESSARY TO CONDUCT ALL TESTS REQUIRED BY THESE SPECIFICATIONS AND THE VARIOUS AGENCIES HAVING JURISDICTION OVER THE WORK INSTALLED UNDER THIS CONTRACT SHALL BE MADE BY THIS CONTRACTOR. NO EXTRA COMPENSATION WILL BE ALLOWED FOR THESE TESTS, THE COST THEREOF BEING INCLUDED IN THE LUMP SUM BID FOR THIS CONTRACT.

F. WHERE ANY EVIDENCE OF STOPPAGE IS FOUND IN PIPING OR EQUIPMENT, THIS CONTRACTOR SHALL DISCONNECT, CLEAN, REPAIR AND RECONNECT ALL OBSTRUCTED PIPING OR EQUIPMENT AND SHALL ALSO PAY FOR ALL NECESSARY CUTTING AND REPAIRS TO ADJOINING WORK.

G. ALL PIPING AND EQUIPMENT SHALL BE THOROUGHLY CLEANED INSIDE AND OUT, OF DIRT, CUTTINGS, OILS AND OTHER FOREIGN SUBSTANCES AND SHALL BE LEFT CLEAN.

H. ALL REQUIRED TESTS SHALL BE WITNESSED BY LOCAL AUTHORITIES AND THE OWNER'S REPRESENTATIVE.

I. ALL EQUIPMENT WILL BE FACTORY TESTED.

J. CONTRACTOR SHALL IDENTIFY TO THE OWNER'S REPRESENTATIVE ANY LEAKS OR DAMAGE THAT OCCURS AS A RESULT OF SYSTEM TESTING. CONTRACTOR SHALL TAKE NECESSARY PRECAUTIONS TO LIMIT ANY POTENTIAL DAMAGE. CORRECTIVE ACTION REQUIRED AS A RESULT OF TESTING SHALL BE PERFORMED IMMEDIATELY AND AT THE CONTRACTOR'S EXPENSE.

K. REPORT IN WRITING TO AUTHORITIES HAVING JURISDICTION, THE ARCHITECT AND THE OWNER THE RESULTS OF ALL TESTING.
- L. TESTING REQUIREMENTS

a. TEST ALL DOMESTIC WATER PIPING AS PER NJPC 2021.

b. TESTS SHALL BE WITNESSED BY THE BUILDING ENGINEER.

c. THE PLUMBING CONTRACTOR WILL BE HELD RESPONSIBLE FOR ALL DAMAGE DUE TO TEST FAILURES AND LEAKAGE IN THE TEST AREA AND ADJACENT TENANT OR ESB SPACES.

M. THOROUGHLY FLUSH PIPING SYSTEM WITH FRESH WATER IMMEDIATELY PRIOR TO FINAL ACCEPTANCE.

N. INSPECTION & TESTING SHALL BE AS PER NJPC 2021.

4. WARRANTY

A. EQUIPMENT, MATERIALS AND WORKMANSHIP FURNISHED UNDER THIS CONTRACT SHALL BE GUARANTEED BY THE CONTRACTOR FOR A PERIOD OF ONE YEAR FROM THE DATE OF FINAL ACCEPTANCE OF THE WORK BY THE OWNER. THE CONTRACTOR SHALL KEEP THE WORK IN GOOD REPAIR FOR ONE YEAR AFTER THE DATE OF FINAL APPROVAL. THE CONTRACTOR SHALL, AT HIS OWN EXPENSE, PROMPTLY CORRECT AND REPAIR ANY AND ALL BREAKS, FAILURES OR WEAR DUE TO FAULTY MATERIALS, WORKMANSHIP OR EQUIPMENT. ALL SETTLEMENTS OF SURFACES THAT MAY OCCUR WITHIN THAT PERIOD SHALL ALSO BE PROMPTLY REPAIRED.
- | ISSUE | DESCRIPTION | DATE |
|-------|-----------------|------------|
| 00 | INITIAL ISSUE | 06/23/2025 |
| 01 | CLIENT REVISION | 01/15/2026 |
| | | |
| | | |
-
- DOB APPROVAL STAMP:
-
- | | |
|--------------|------------|
| DATE: | 06/02/2025 |
| PROJECT NO.: | Z166-24 |
| DRAWN BY: | NYE |
| CHECKED BY: | NYE |
| SCALE: | AS NOTED |
- DRAWING TITLE:

PLUMBING SPECIFICATIONS
- DRAWING NO.:


P-002

WATER PLAN GENERAL NOTES:

1. REFER RISER DIAGRAMS FOR ALL PIPE SIZES.
2. CW/HW/HWR PIPING TO BE PROVIDED WITH INSULATION AS PER ASHRAE 90.1 2019.
3. PROVIDE BRANCH PRV IF PRESSURE EXCEEDS 80 PSI.
4. CONTRACTOR SHALL CONFIRM EXISTING CONDITIONS PRIOR TO BID.
5. CONFIRM LOCATIONS OF ALL EXISTING UTILITIES AND ADJUST ROUTING OF TENANT SYSTEMS AS REQUIRED.

WATER PLAN KEY NOTES: (#)

1. 1/2" CW & HW WITH SHUT-OFF VALVE DROP, IN WALL, TO HAND SINK. PROVIDE BELOW DECK MIXING VALVE SET NOT TO EXCEED 110°F.
2. 1/2" FW WITH SHUT-OFF VALVE AND BFP DROP TO SERVE TEA BREWER AND SINGLE COFFEE MAKER.
3. EXTEND AND CONNECT NEW CW/HW LINE TO EXISTING CW/HW LINE IN CEILING. CONTRACTOR TO FIELD VERIFY THE EXACT SIZE AND LOCATION OF EXISTING CW/HW.
4. EXTEND AND CONNECT NEW FW LINE TO EXISTING FW LINE IN CEILING. CONTRACTOR TO FIELD VERIFY THE EXACT SIZE AND LOCATION OF EXISTING FW LINE.
5. EXISTING PLUMBING FIXTURES TO REMAIN AT SAME LOCATION WITH EXISTING PLUMBING CONNECTIONS. CONTRACTOR TO FIELD VERIFY THE CONDITION OF EXISTING PLUMBING FIXTURE & PIPING, REPLACE IF REQUIRED.

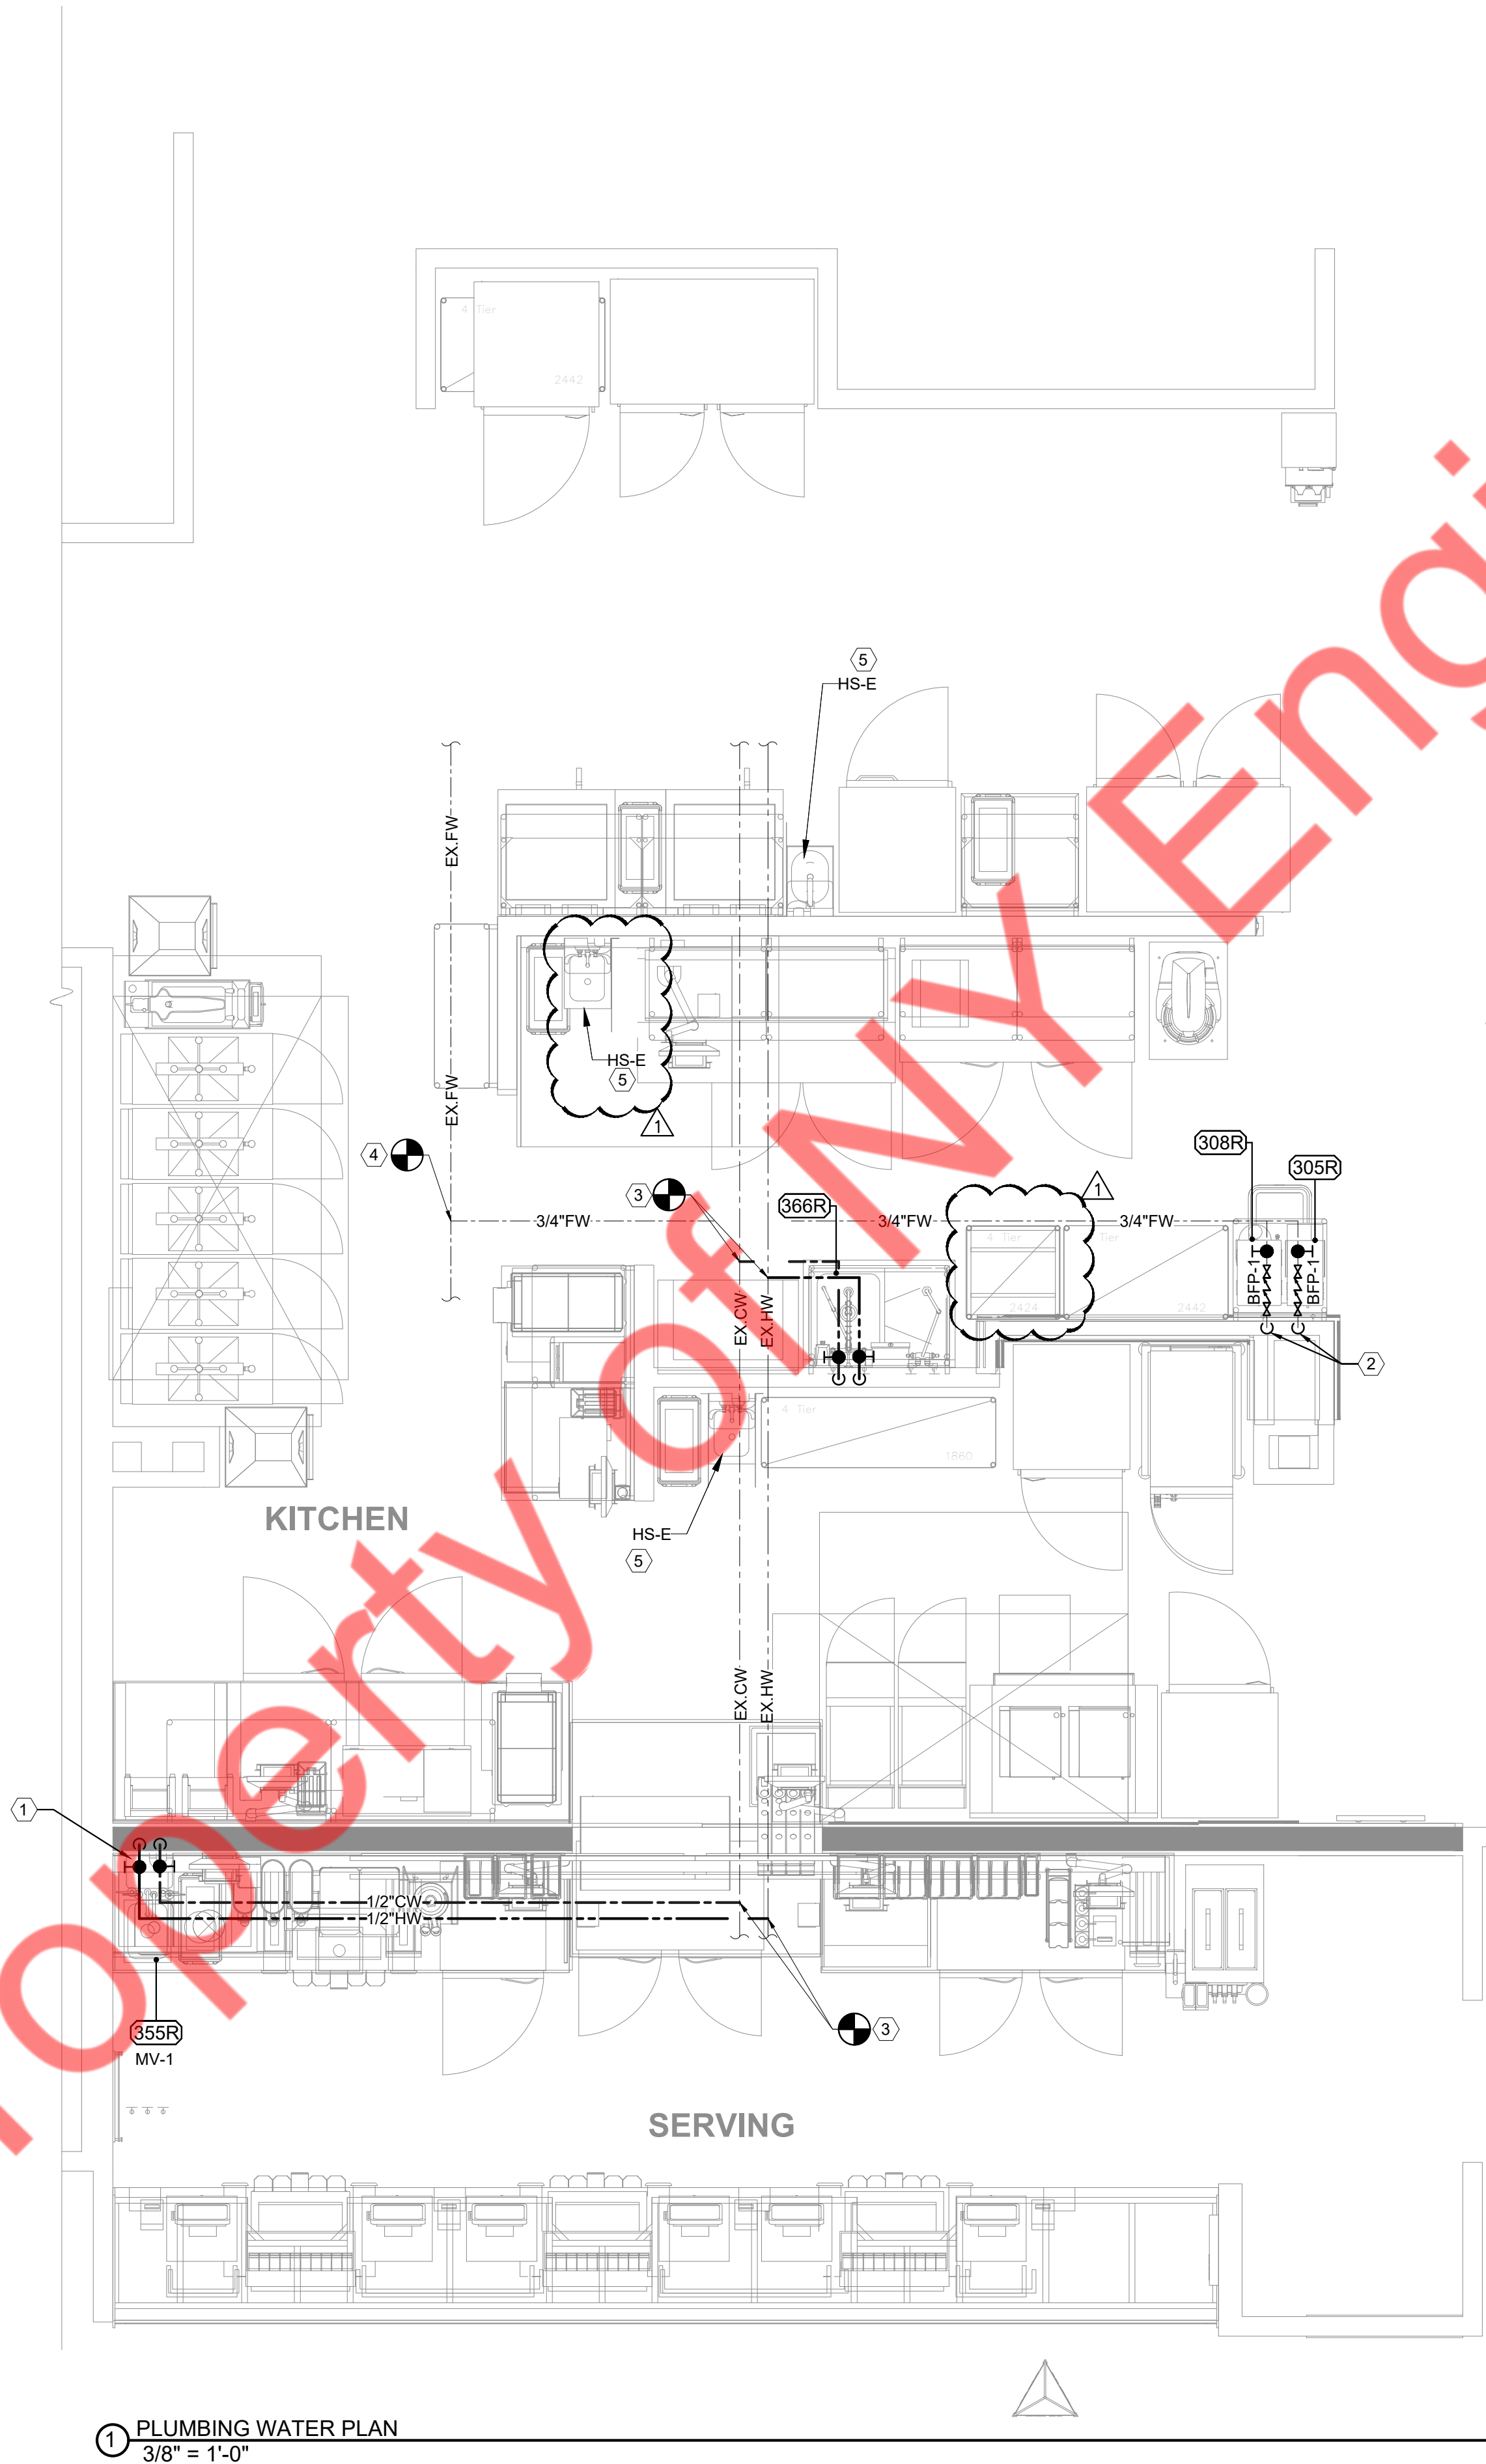

1 PLUMBING WATER PLAN
3/8" = 1'-0"

ISSUE	DESCRIPTION	DATE
00	INITIAL ISSUE	06/23/2025
01	CLIENT REVISION	01/15/2026

DOB APPROVAL STAMP:

DATE: 06/02/2025
PROJECT NO.: Z166-24
DRAWN BY: NYE
CHECKED BY: NYE
SCALE: AS NOTED

DRAWING TITLE:
PLUMBING WATER PLAN


DRAWING NO.:
P-100

SANITARY PLAN GENERAL NOTES:

1. THE PLUMBING CONTRACTOR SHALL VERIFY ALL LOCATIONS AND ELEVATIONS OF SERVICES AND UTILITIES BEFORE STARTING ANY WORK. REPORT ANY DISCREPANCIES TO THE ARCHITECT AND ENGINEER FOR RESOLUTION.
2. THE ENTIRE PLUMBING INSTALLATION AND OPERATION SHALL COMPLY WITH ALL FACILITY MANAGEMENT REQUIREMENTS.
3. PIPING LAYOUTS ARE DIAGRAMMATIC AND INTENDED TO SHOW GENERAL ARRANGEMENT, SIZE, AND CAPACITY. ALL OFFSETS ARE NOT NECESSARILY SHOWN. THE PLUMBING CONTRACTOR SHALL ARRANGE AND COORDINATE THE WORK, FURNISH NECESSARY OFFSETS, VALVES, VENTS, AND FITTINGS TO AVOID CONFLICTS WITH OTHER MECHANICAL AND ELECTRICAL SERVICES AND WITH STRUCTURAL AND ARCHITECTURAL ELEMENTS.
4. ALL INDIRECT WASTE PIPING SHALL TERMINATE AT WASTE RECEPTORS WITH APPROVED AIR GAP, PER LOCAL CODES.
5. PLUMBING CONTRACTOR SHALL INSTALL ALL NEW PLUMBING FIXTURES AND EQUIPMENT. MAKE ALL FINAL CONNECTIONS NEEDED TO SANITARY, VENT, GAS, COLD AND HOT WATER PIPING.
6. CONTRACTOR TO FIELD VERIFY FEASIBILITY OF SLAB PENETRATION AS PER STRUCTURAL REQUIREMENT.
7. REFER RISER DIAGRAM FOR ALL PIPE SIZES.

SANITARY PLAN KEY NOTES: (#)

1. CONNECT NEW SANITARY PIPING TO EXISTING SANITARY PIPING IN SPACE. CONTRACTOR TO FIELD VERIFY EXACT SIZE, LOCATION, INVERT AND ROUTING OF EXISTING SANITARY PIPING.
2. CONNECT NEW VENT PIPING TO EXISTING VENT PIPING IN SPACE. CONTRACTOR TO FIELD VERIFY EXACT SIZE AND LOCATION OF EXISTING VENT PIPING.
3. ROUTE INDIRECT DRAIN FROM ICE BATH BREADING TABLE TO NEW FLOOR SINK WITH APPROVED AIR GAP.
4. ROUTE INDIRECT WASTE FROM VEGGIE SINK TO EXISTING FLOOR SINK. CONTRACTOR TO FIELD VERIFY THE CONDITION OF EXISTING PIPING, REPLACE IF REQUIRED.
5. EXISTING PLUMBING FIXTURES TO REMAIN WITH EXISTING SANITARY AND VENT CONNECTION, ASSOCIATED ACCESSORIES AND FITTINGS. CONTRACTOR TO FIELD VERIFY THE CONDITION OF EXISTING PIPING AND FIXTURE, REPLACE IF REQUIRED.

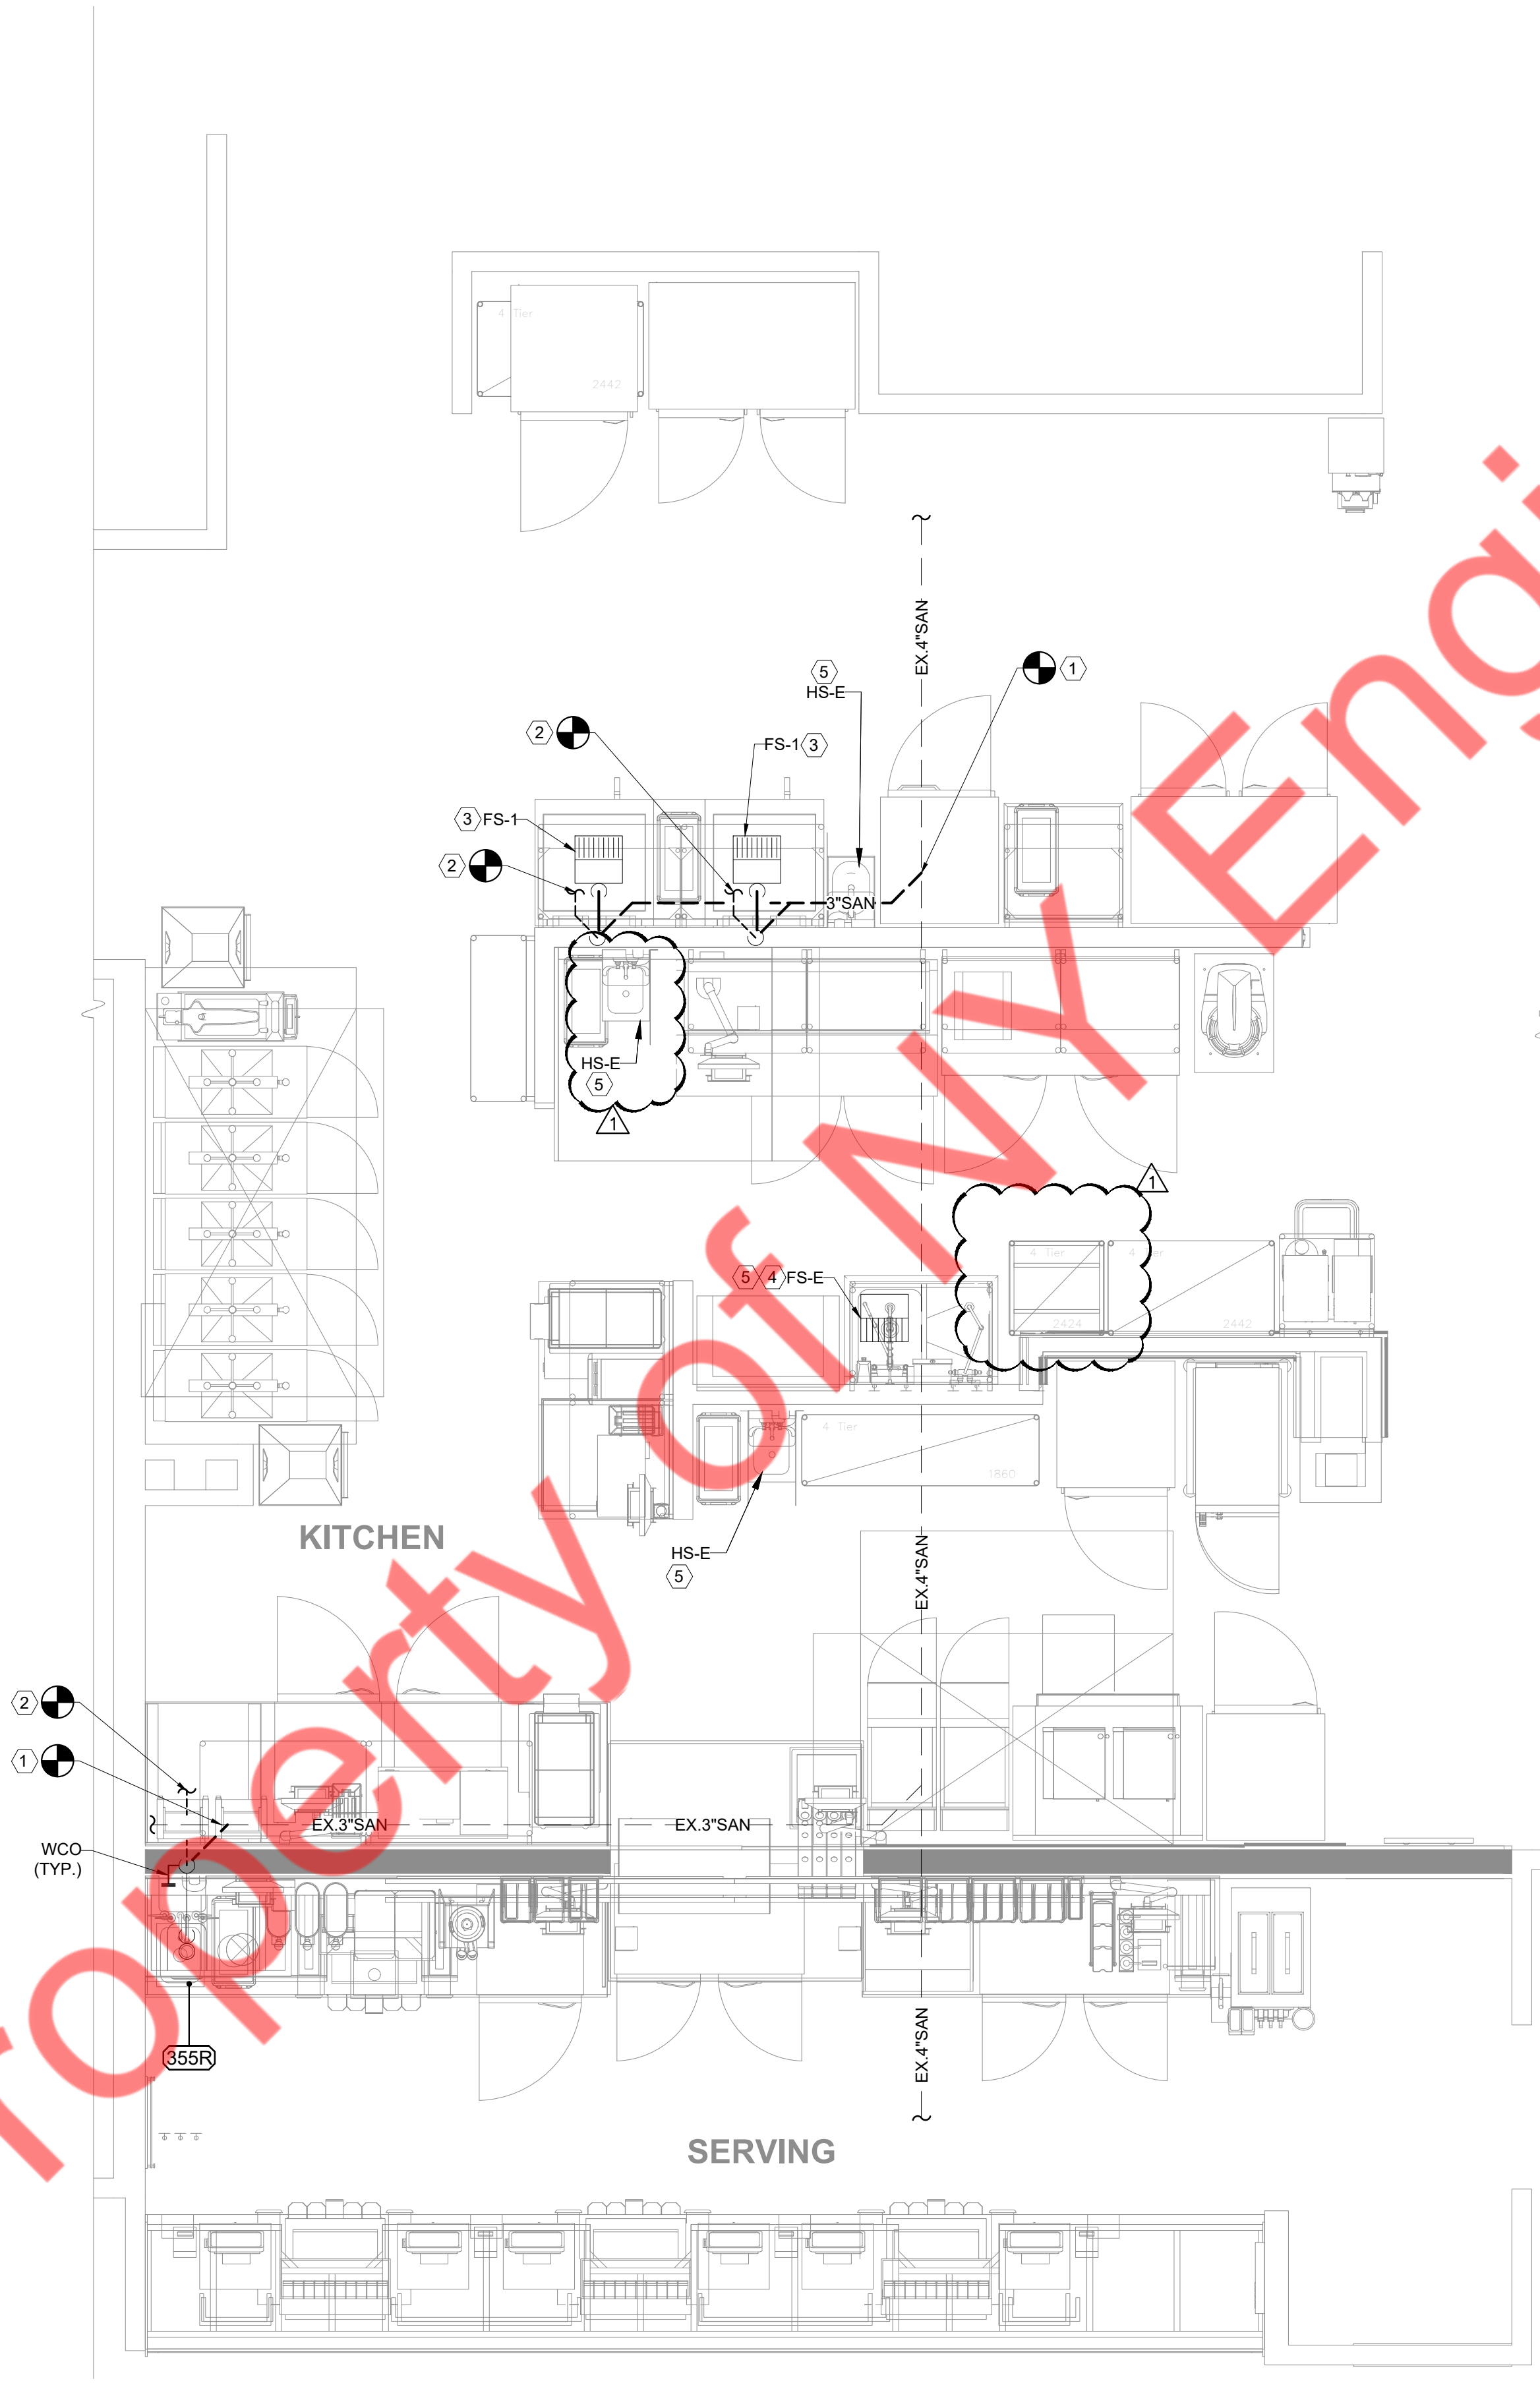

1 PLUMBING SANITARY PLAN
3/8" = 1'-0"

ISSUE	DESCRIPTION	DATE
00	INITIAL ISSUE	06/23/2025
01	CLIENT REVISION	01/15/2026

DOB APPROVAL STAMP:


DATE:	06/02/2025
PROJECT NO.:	Z166-24
DRAWN BY:	NYE
CHECKED BY:	NYE
SCALE:	AS NOTED

DRAWING TITLE:


PLUMBING SANITARY PLAN

DRAWING NO.:


P-101

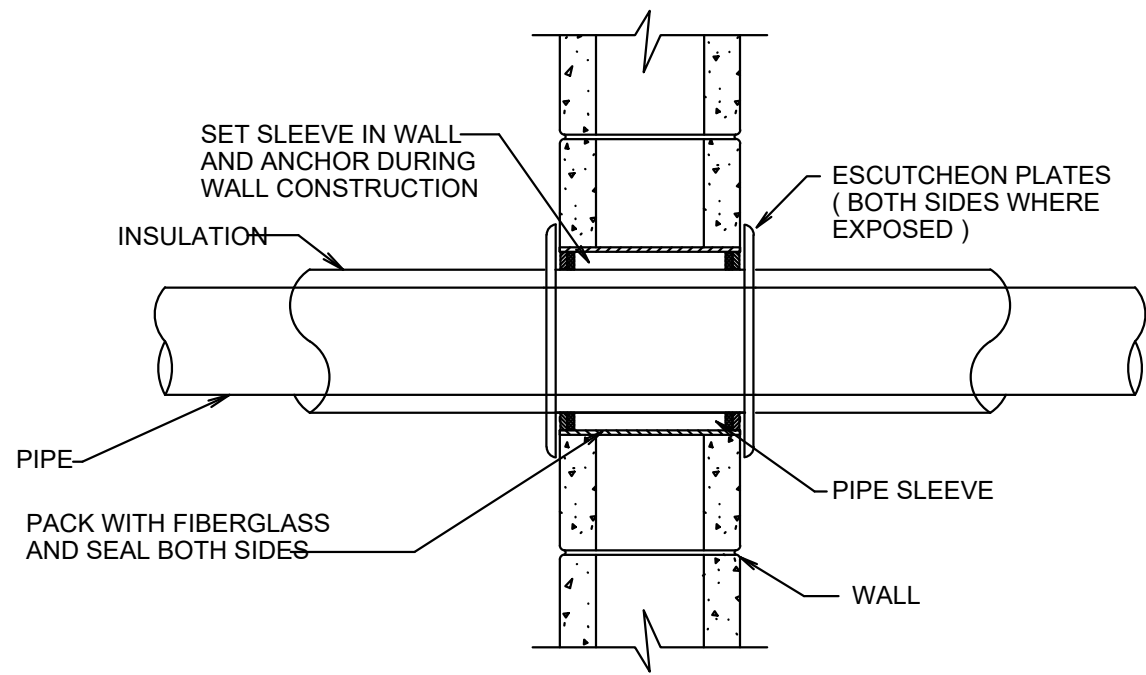


1 PIPE SLEEVE THRU WALL SECTION
N.T.S.

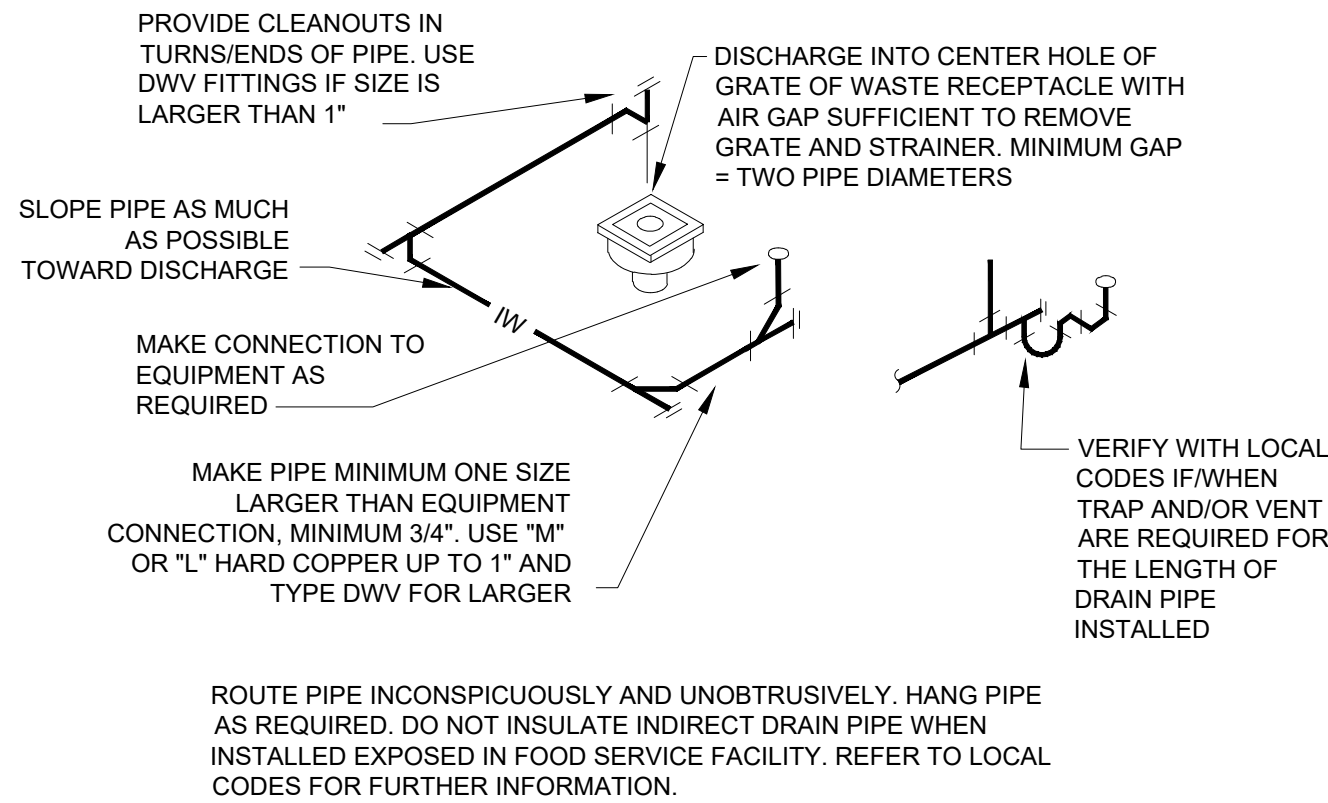


2 INDIRECT DRAIN
N.T.S.

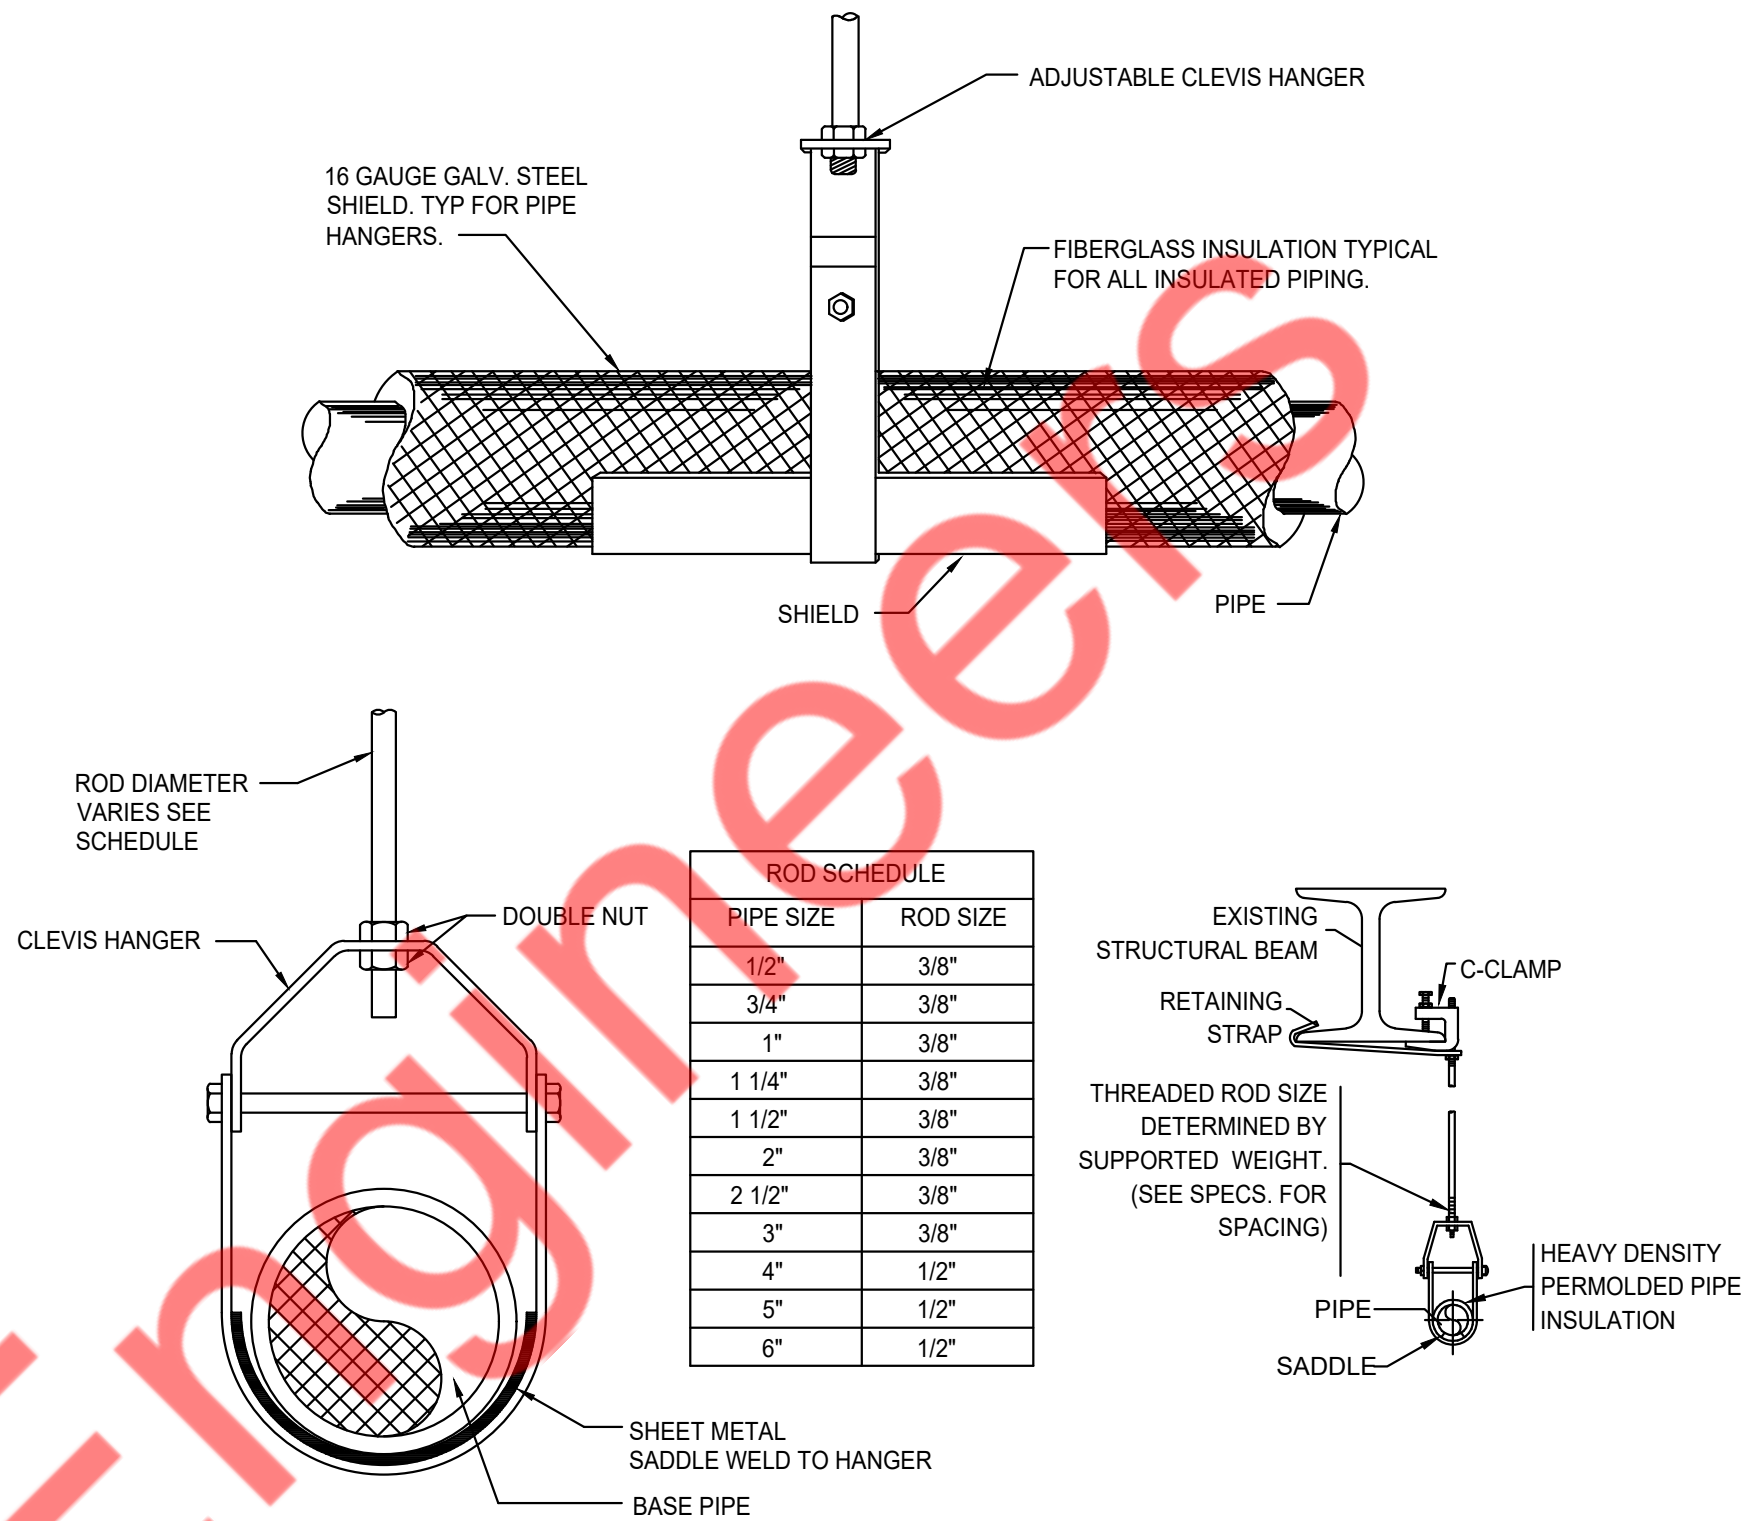


3 HANGER DETAIL
N.T.S.

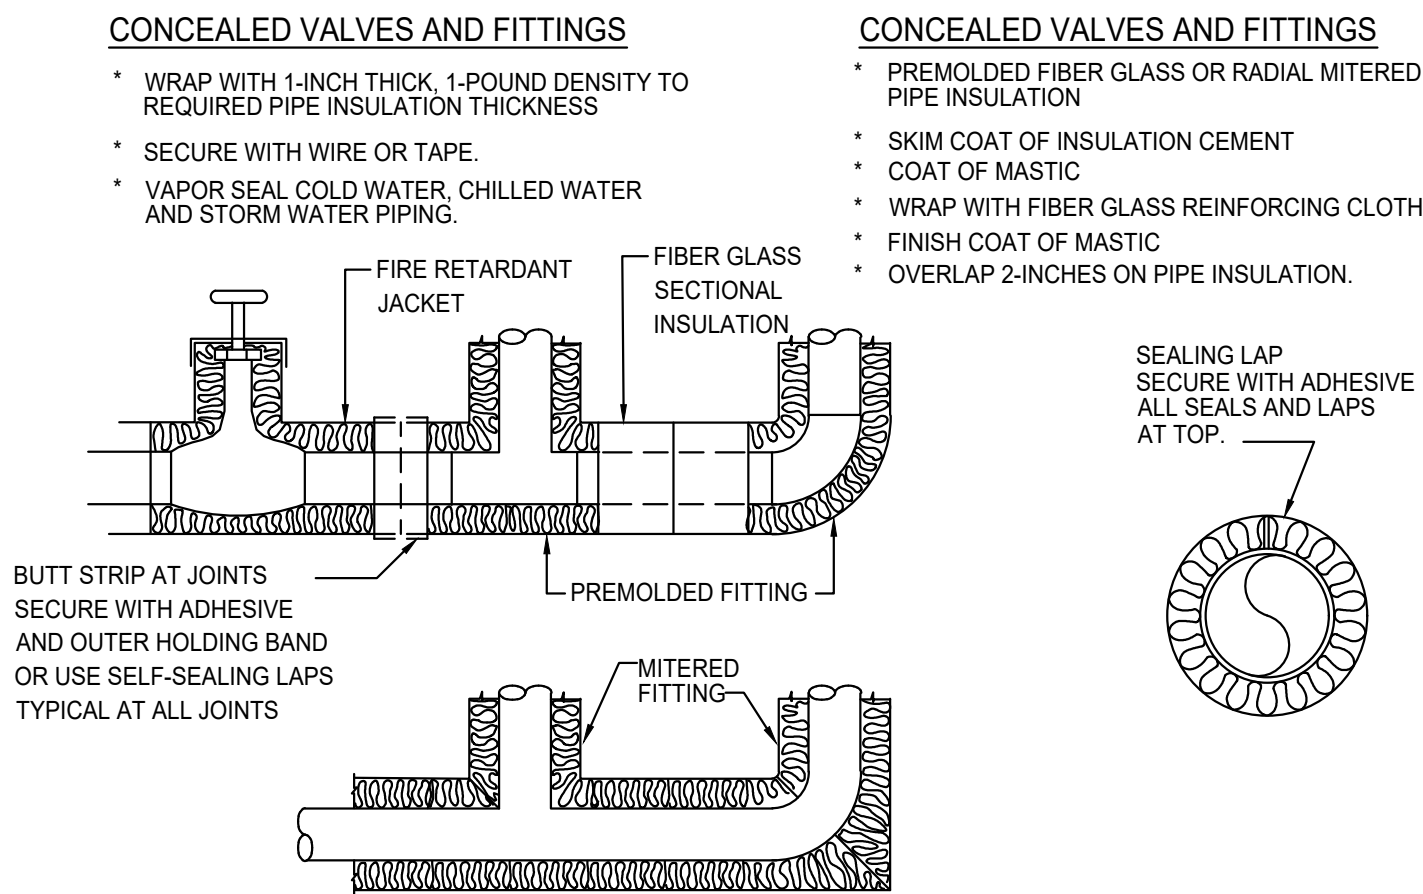

4 INSULATION OF PIPING, VALVES AND FITTINGS
N.T.S.

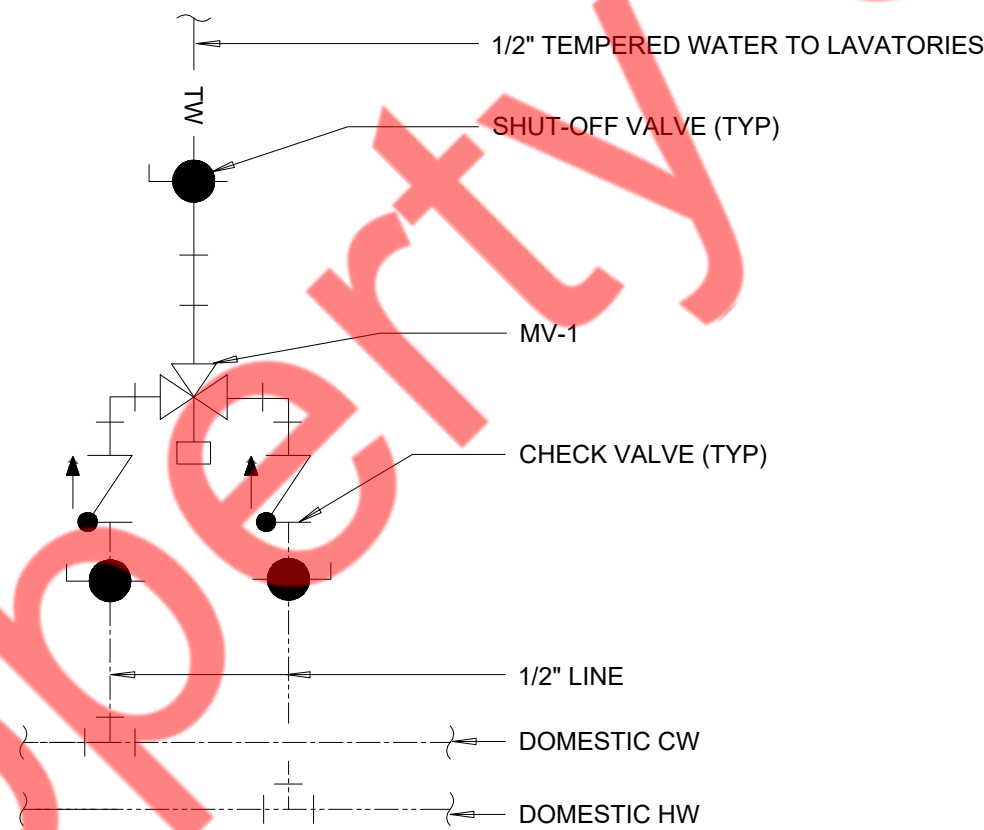

5 THERMOSTATIC MIXING VALVE DETAIL
N.T.S.

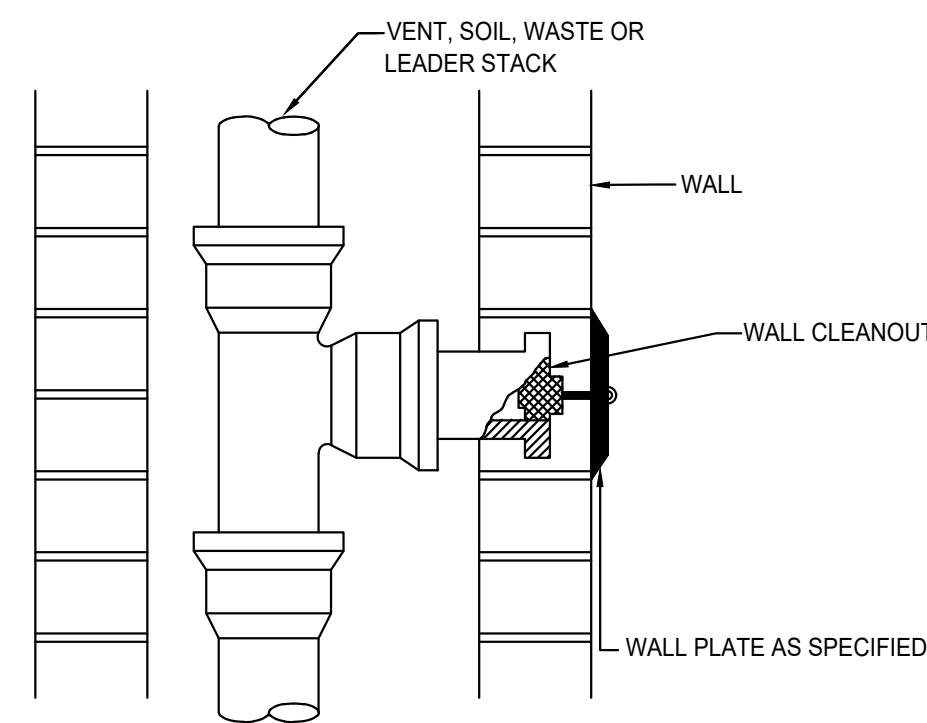

6 WALL CLEANOUT DETAIL
N.T.S.

ISSUE	DESCRIPTION	DATE
00	INITIAL ISSUE	06/23/2025
01	CLIENT REVISION	01/15/2026

DOB APPROVAL STAMP:



DATE:	06/02/2025
PROJECT NO.:	Z166-24
DRAWN BY:	NYE
CHECKED BY:	NYE
SCALE:	AS NOTED

DRAWING TITLE:

PLUMBING DETAILS

DRAWING NO.:

P-200

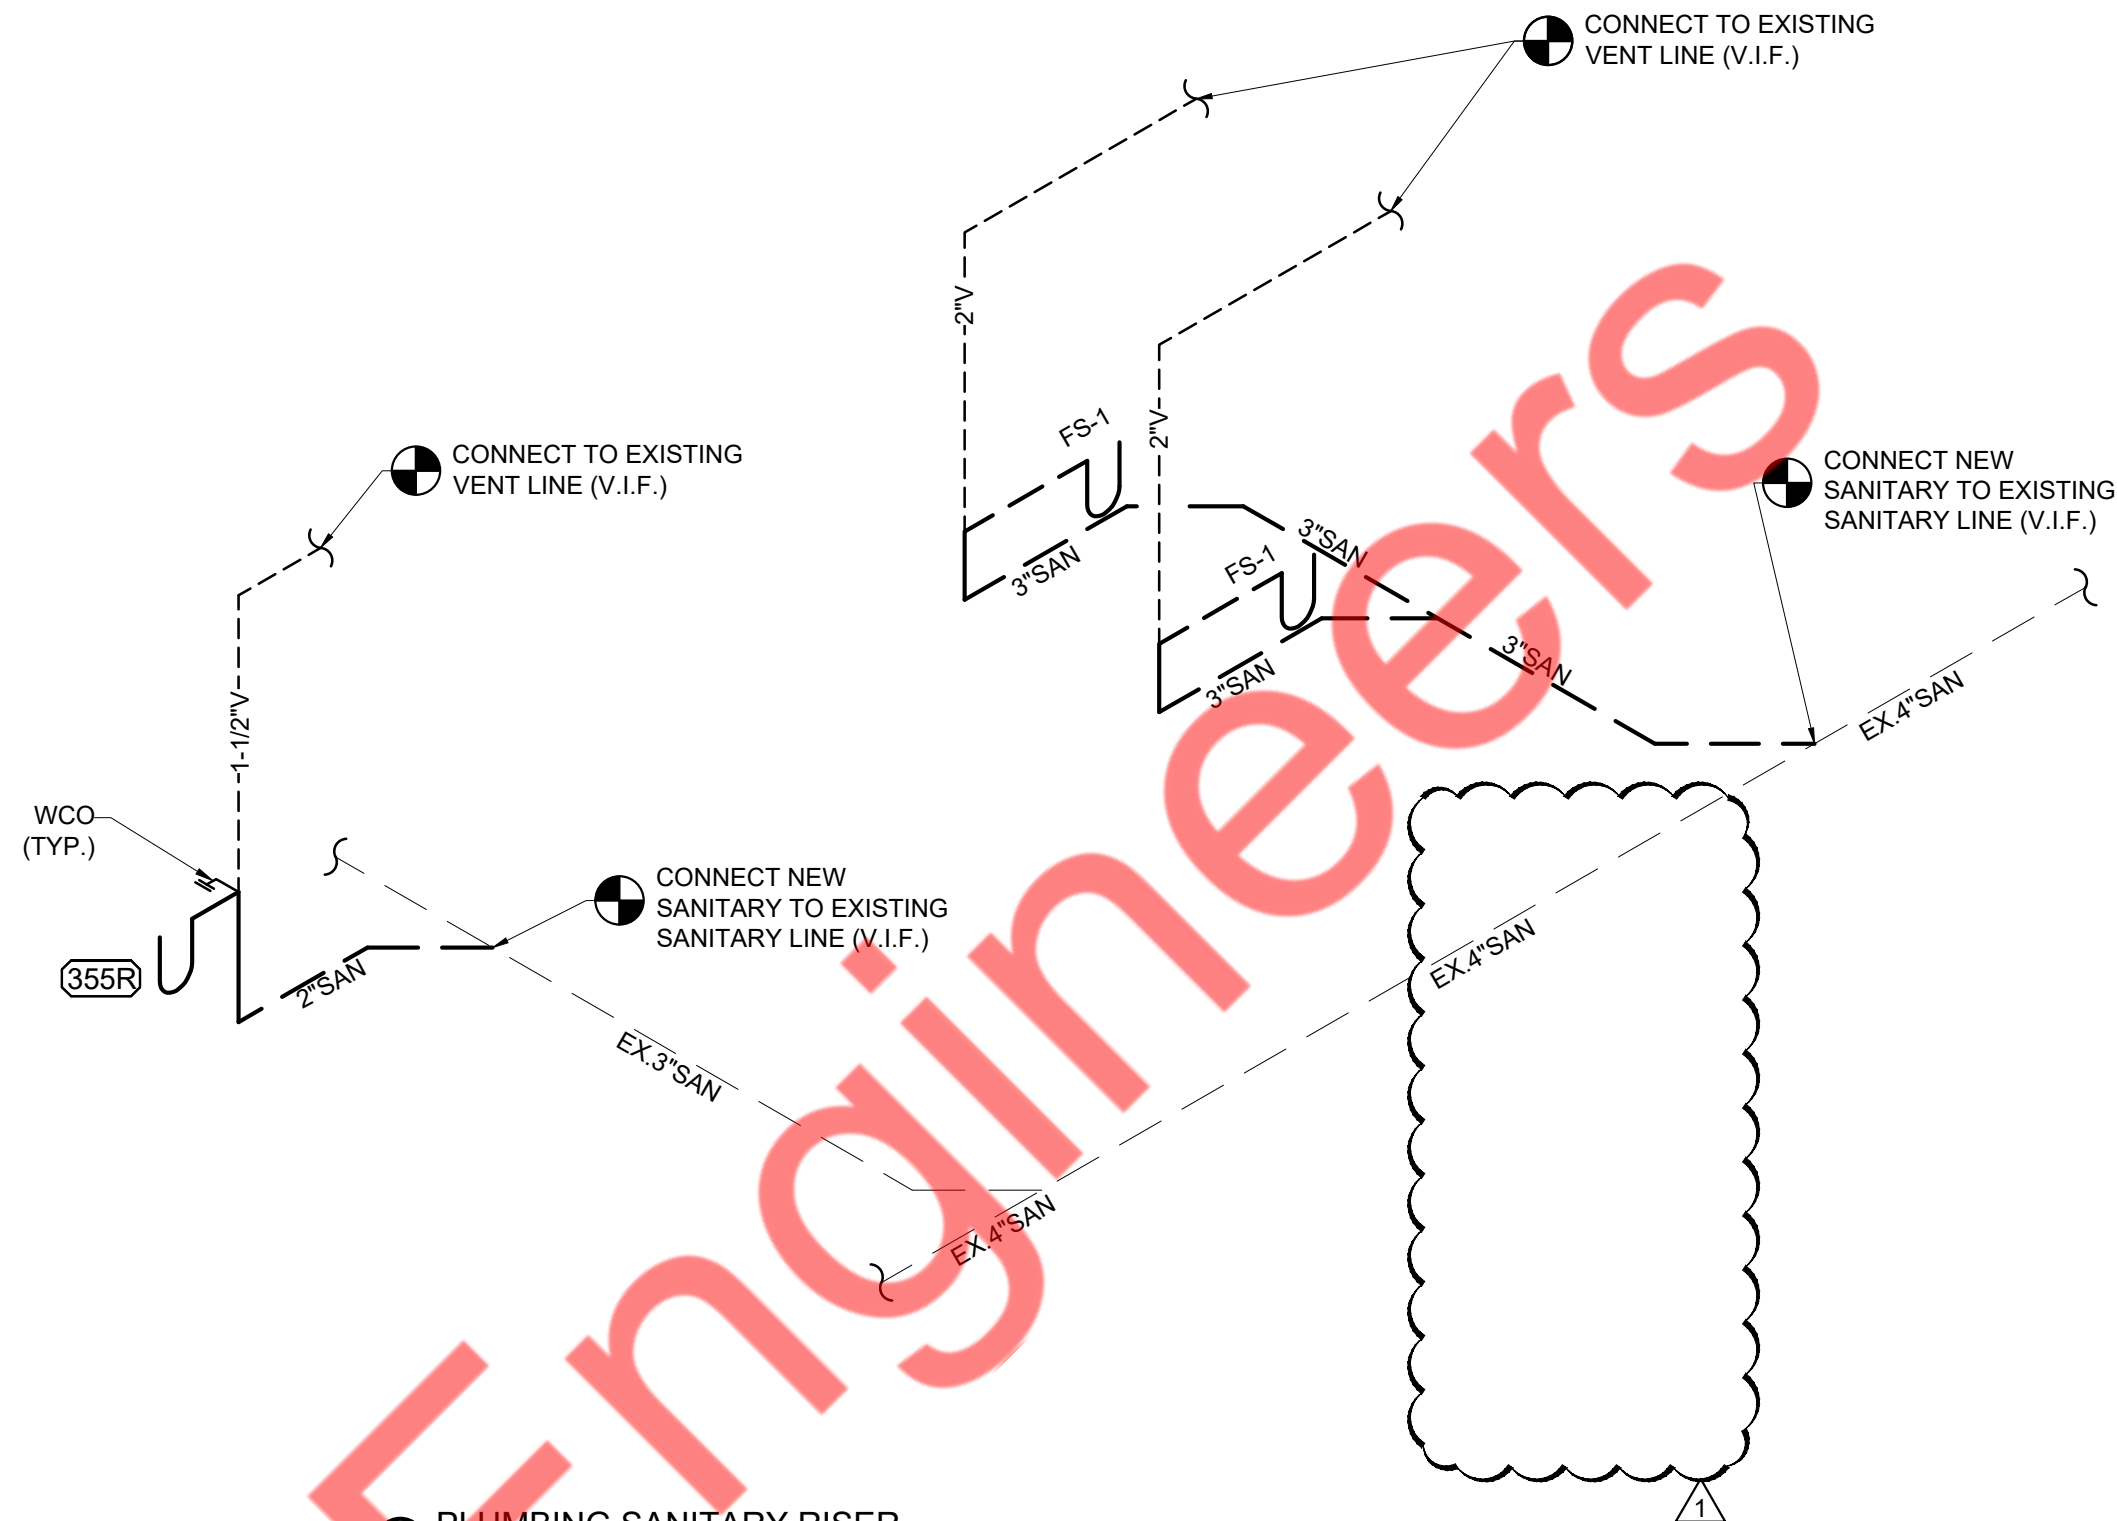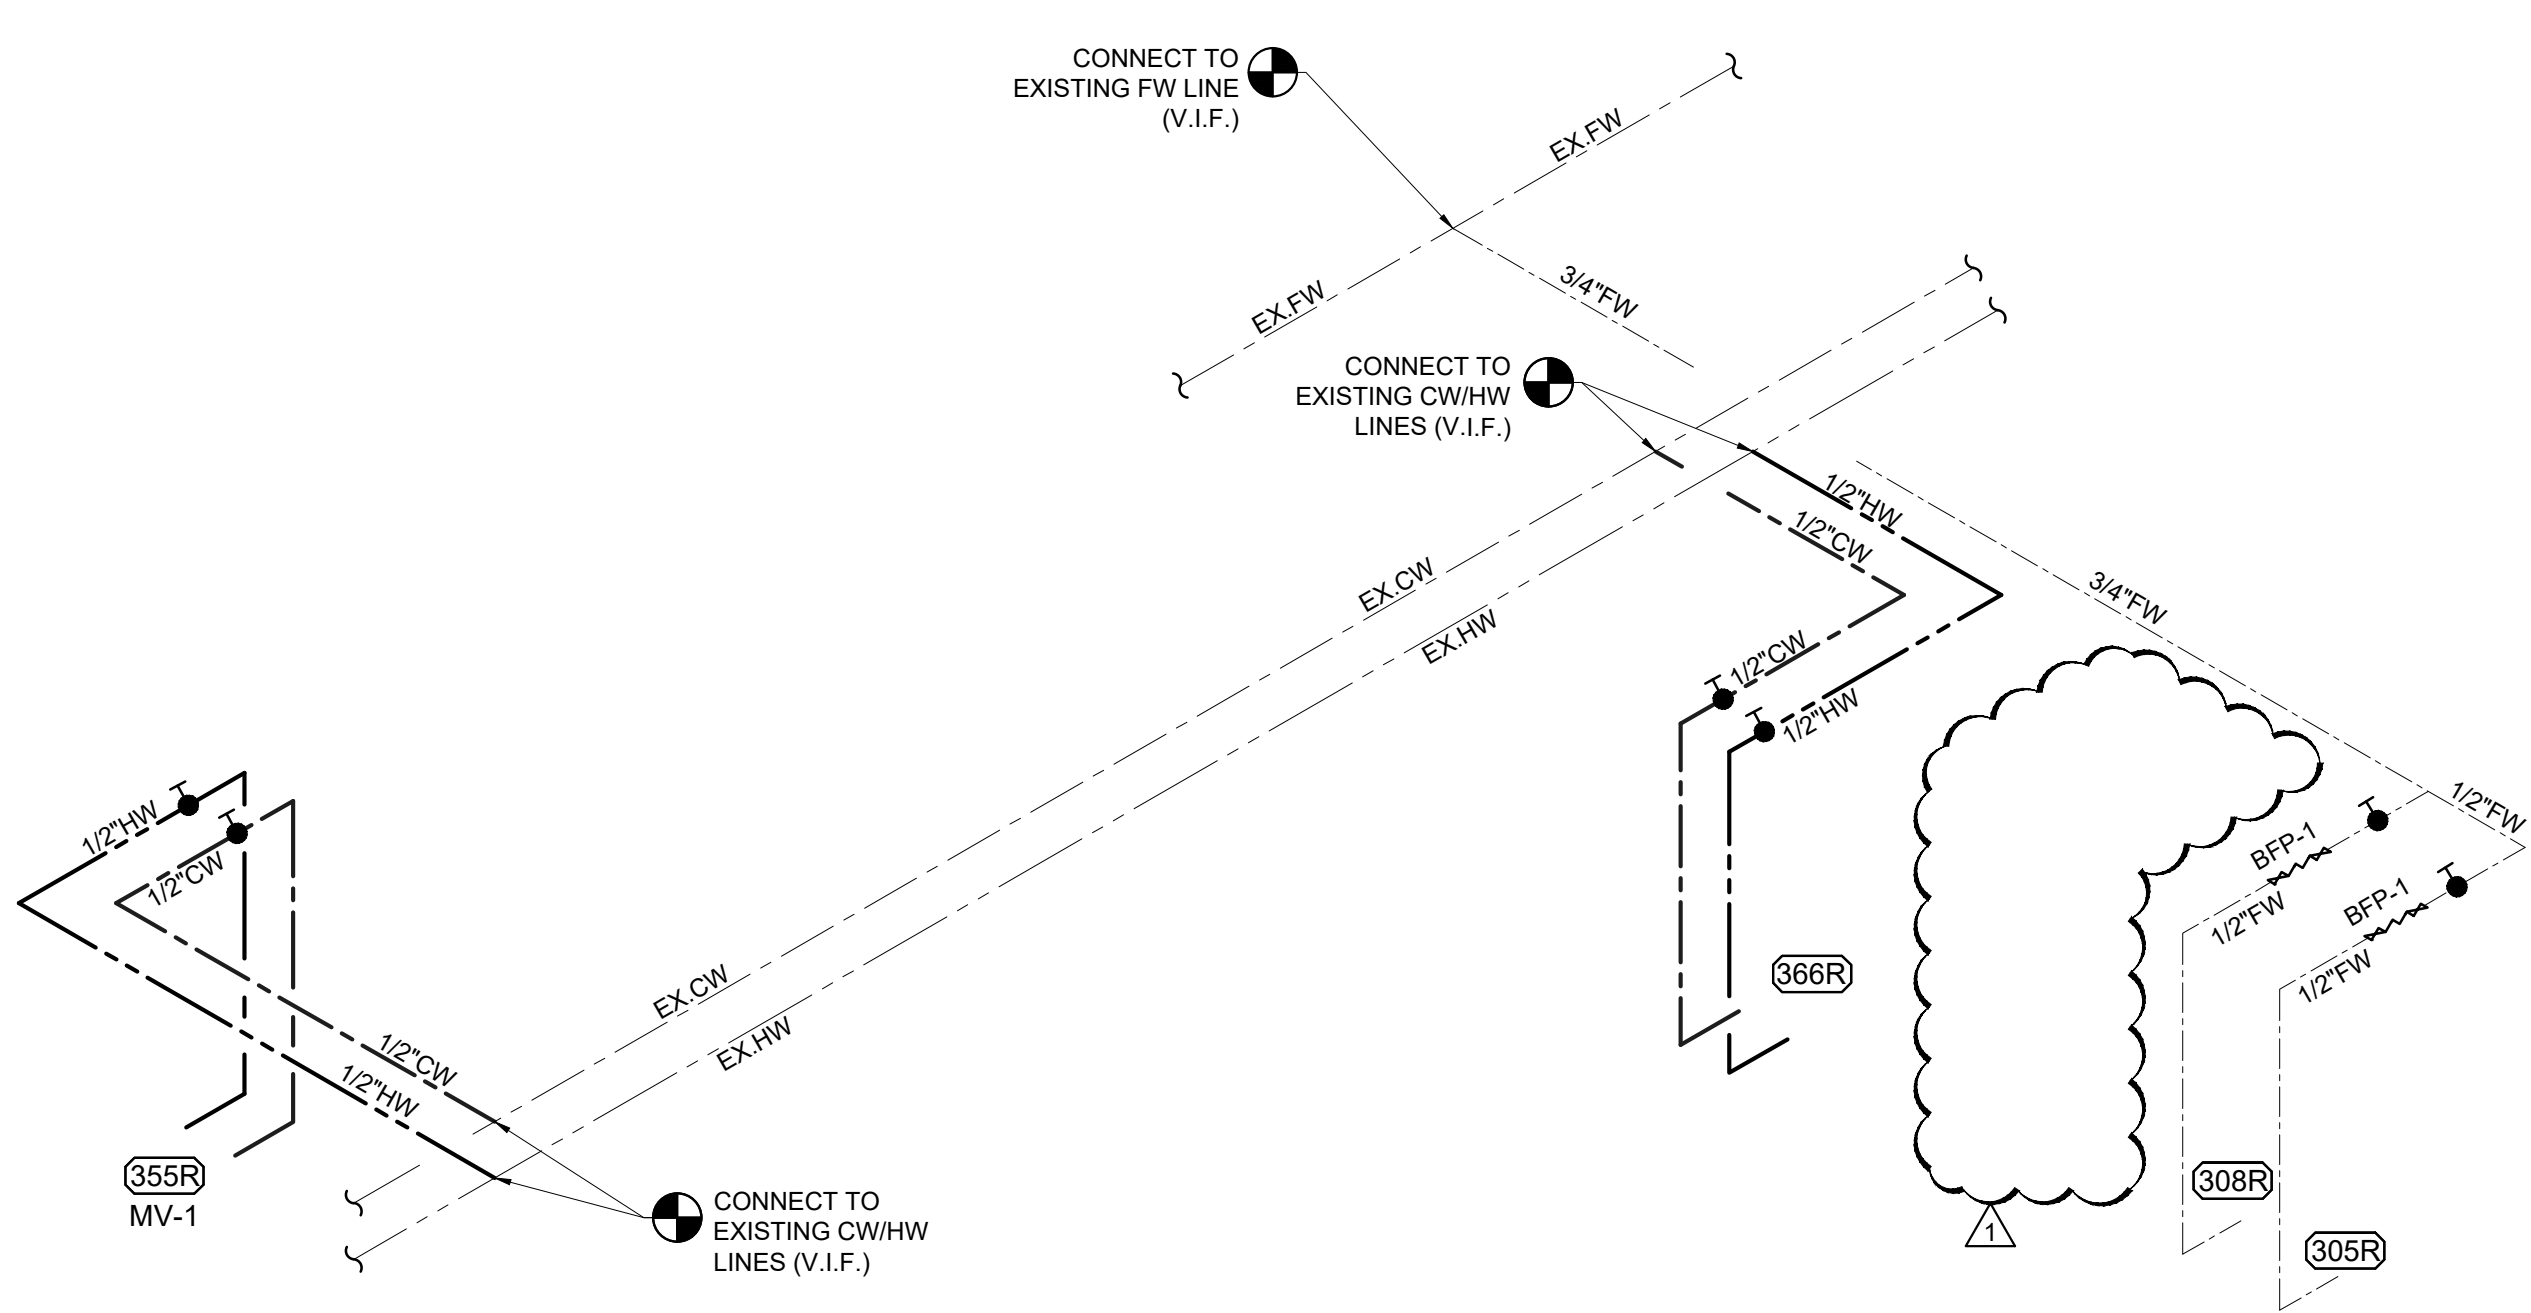

PLUMBING FIXTURE SCHEDULE										
TAG	PLUMBING FIXTURE	MANUFACTURER	MODEL	CONNECTION SIZE - INCHES						REMARKS
				TRAP	SOIL/WASTE	VENT	COLD WATER	HOT WATER	FW WATER	
305R	TEA BREWER RELOCATED	-	-	--	--	--	--	--	1/2"	-
308R	SINGLE COFFEE MAKER RELOCATED	-	-	--	--	--	--	--	1/2"	-
355R	HAND SINK RELOCATED	-	-	2"	2"	1-1/2"	1/2"	1/2"	-	-
366R	SINGLE BOWL VEGETABLE PREP SINK	-	-	2"	2"	-	1/2"	1/2"	-	RELOCATED
FS-1	FLOOR SINK	J.R. SMITH	3100C-C-U-12	3"	3"	2"	-	-	-	W/ FULL GRADE. COORDINATE SLAB CONSTRUCTION AND FLOOR FINISH BEFORE ORDERING.
FS-E	FLOOR SINK - EXISTING	-	-	E	E	E	-	-	-	EXISTING

NOTE: CONTRACTOR TO COORDINATE WITH ARCHITECTURAL DRAWINGS ALL PLUMBING FIXTURES SPECIFICATIONS AND MOUNTING HEIGHT INSTALLATION.

THERMOSTATIC MIXING VALVE										
ITEM	QTY.	LOCATION	SERVICE	PIPE SIZE	CAPACITY RANGE (GPM)		TEMP RANGE (°F)		MANUFACTURER & MODEL NO.	REMARKS
					MIN.	MAX.	MIN.	MAX.		
MV-1	02	REFER PLAN	HOT WATER	1/2	0.5	2	105	110	WATTS MODEL - LFUSG-B-M2	- LEAD FREE BRASS BODY CONSTRUCTION - ASSE 1070 LISTED

BACKFLOW PREVENTION DEVICE					
TAG	QTY.	TYPE OF EQUIPMENT ON SYSTEM	METHOF OF CROSS CONNECTION CONTROL	MANUFACTURE AND MODEL NUMBER	REMARKS
BFP-1	02	TEA BREWER & COFFEE MAKER	DUEL CHECK VALVE WITH ATMOSPHERIC PORT	WATTS SD2 ASSE 1032	STAINLESS STEEL BODY WITH QUARTER TURN VALVE BRONZE STRAINER

ISSUE	DESCRIPTION	DATE
00	INITIAL ISSUE	06/23/2025
01	CLIENT REVISION	01/15/2026

DOB APPROVAL STAMP:

DATE: 06/02/2025
PROJECT NO.: Z166-24
DRAWN BY: NYE
CHECKED BY: NYE
SCALE: AS NOTED

DRAWING TITLE:
PLUMBING RISERS & SCHEDULES

DRAWING NO.:
P-300