MECHANICAL SYMBOLS LIST

	CEILING DIFFUSER SUPPLY
	CEILING DIFFUSER RETURN/EXHAUST
T	THERMOSTAT
SD	DUCT MOUNTED SMOKE DETECTOR
24X12	RECTANGULAR DUCT (WIDTH X DEPTH)
Ø12	ROUND DUCT (DIAMETER)
	ROUND DUCT CROSS SECTION
	SUPPLY AIR RECTANGULAR DUCT GOING UP/DOWN
	RETURN AIR RECTANGULAR DUCT GOING UP/DOWN
BD	BACKDRAFT DAMPER
VD	VOLUME DAMPER W/ ACCESS DOOR
M	MOTORIZED DAMPER W/ ACCESS DOOR
	FIRE SMOKE DAMPER W/ ACCESS DOOR
	FIRE DAMPER W/ ACCESS DOOR

MECHANICAL ABBREVIATIONS

ACCU	AIR COOLRD CONDENSING UNIT
AFF	ABOVE FINISHED FLOOR
AC	AIR CONDITIONER (1)
AL	ACOUSTIC LINING
BD	GRAVITY DAMPER
CD	CONDENSATE DRAIN
CFM	CUBIC FEET OF AIR PER MINUTE
COP	COEFFICIENT OF PERFORMANCE
DN	DOWN
E	EXISTING
EDH	ELECTRIC DUCT HEATER
EER	ENERGY EFFICIENCY RATIO
EF	EXHAUST FAN
FC	FLEXIBLE CONNECTION
FD/AD	FIRE DAMPER W/ACCESS DOOR
FD	FIRE DAMPER W/FUSIBLE LINK
FSD	FIRE SMOKE DAMPER
GUH	GAS UNIT HEATER
IEER	INTEGRATED ENERGY EFFICIENCY RATIO
OA	OUTSIDE AIR
OAF	OUTSIDE AIR FAN
RA	RETURN AIR
RAD	RETURN AIR DUCT
SA	SUPPLY AIR
S.A.E.	SAME AS EXISTING
SAD	SUPPLY AIR DUCT
SEER	SEASONAL ENERGY EFFICIENCY RATIO
VD	VOLUME CONTROL DAMPER
V.I.F.	VERIFY IN FIELD

MECHANICAL DRAWING LIST

M-001	MECHANICAL SYMBOL LIST, ABBREVIATIONS & NOTES
M-002	MECHANICAL SPECIFICATIONS
M-101	MECHANICAL FLOOR PLAN
M-201	MECHANICAL DETAILS (1 OF 2)
M-202	MECHANICAL DETAILS (2 OF 2)
M-301	MECHANICAL SCHEDULE

BUILDING DEPARTMENT NOTES

ALL WORK SHALL COMPLY WITH APPLICABLE SECTIONS OF INTERNATIONAL BUILDING CODE 2021 WITH ALL AMENDMENTS AND RULES AND REGULATIONS OF THE DEPARTMENT OF BUILDINGS TO DATE.

1. THE CONTRACTOR SHALL ENGAGE THE SERVICES OF A PROFESSIONAL ENGINEER TO PROVIDE THE REQUIRED SPECIAL INSPECTION AND TESTS.
2. TESTS WILL BE CONDUCTED UNDER DIRECTION OF A LICENSED PROFESSIONAL ENGINEER, ARCHITECT OR OTHER PERSON HAVING NOT LESS THAN FIVE (5) YEARS EXPERIENCE SUPERVISING THE INSTALLATION OF SUCH MECHANICAL SYSTEMS. THE TESTS WILL SHOW COMPLIANCE WITH INTERNATIONAL BUILDING CODE 2021.
3. THE LICENSED PROFESSIONAL ENGINEER, ARCHITECT OR OTHER PERSON HAVING NOT LESS THAN FIVE (5) YEARS EXPERIENCE SUPERVISING THE INSTALLATION OF SUCH MECHANICAL SYSTEMS AND CONDUCTING SUCH TESTS WILL FILE DOCUMENTATION AND REPORTS OF TESTS THAT THE SYSTEM COMPLIES WITH THE CONSTRUCTION DOCUMENTS AND APPLICABLE LAWS.
4. TESTS OF MECHANICAL SYSTEMS SHALL BE PERFORMED IN ACCORDANCE WITH THE FOLLOWING SECTIONS OF THE INTERNATIONAL MECHANICAL CODE 2021:
   A. VENTILATION SYSTEM IMC 2021 - 401
5. THE FOLLOWING WORK ITEMS, COMPONENTS, MATERIALS, CAPACITIES, ETC. SHALL COMPLY WITH THE REFERENCED CODE OR STANDARD:
   A. STANDARDS OF HEATING IMC 2021 - 309.1
   B. DUCT CONSTRUCTION AND INSTALLATION IMC 2021 - 603
   C. AIR INTAKES, EXHAUSTS AND RELIEF IMC 2021 - 401.5
   D. AIR FILTERS IMC 2021 - 605
6. MINIMUM TEMPERATURE TO BE MAINTAINED IN OCCUPIED SPACES DURING HEATING SEASON: 68 DEG. FAHRENHEIT.
7. VENTILATION FOR ALL AREA SHALL COMPLY WITH INTERNATIONAL MECHANICAL CODE 2021, CHAPTER 4.
8. VENTILATION SYSTEM SHALL BE BALANCED TO MAINTAIN THE MINIMUM VENTILATION AIRFLOW RATES AS SHOWN IN VENTILATION REQUIREMENT TABLE. THE SYSTEM SHALL BE BALANCED BY APPROVED METHOD. CONTRACTOR TO SUBMIT THE AIR BALANCE REPORT TO INSPECTOR OF RESPECTIVE BUILDING DEPARTMENT PRIOR TO FINAL INSPECTION.
9. A STATEMENT SHALL BE FILED BY THE OWNER OR TENANT IN POSSESSION THAT THE VENTILATION SYSTEM WILL BE KEPT IN CONTINUOUS OPERATION AT ALL TIMES DURING THE NORMAL OCCUPANCY OF THE STRUCTURE AS REQUIRED BY INTERNATIONAL MECHANICAL CODE 2021 - 403.
10. REFER TO ARCHITECTURAL DRAWINGS FOR REQUIRED FIRE-RATED WALL AND SMOKE WALL CONSTRUCTION AND LOCATION.
11. THESE PLANS ARE APPROVED ONLY FOR THE WORK INDICATED ON THE APPLICATION SPECIFICATION SHEET. ALL OTHER MATTERS SHOWN ARE NOT TO BE RELIED UPON OR TO BE CONSIDERED AS EITHER BEING APPROVED OR IN ACCORDANCE WITH APPLICABLE CODES.
12. ALL HEATING AND COOLING LOADS CALCULATED PER ASHRAE/ACCA 183.
13. SMOKE DETECTOR SHALL MEET UL268A.

THERMOSTATIC CONTROL NOTES

A. 6.4.3.1.1 GENERAL

THE SUPPLY OF HEATING AND COOLING ENERGY TO EACH ZONE SHALL BE INDIVIDUALLY CONTROLLED BY THERMOSTATIC CONTROLS RESPONDING TO TEMPERATURE WITHIN THE ZONE. FOR THE PURPOSES OF THIS SECTION, A DWELLING UNIT SHALL BE PERMITTED TO BE CONSIDERED A SINGLE ZONE.

B. 6.4.3.1.2 DEAD BAND

WHERE USED TO CONTROL BOTH HEATING AND COOLING, ZONE THERMOSTATIC CONTROLS SHALL BE CAPABLE OF AND CONFIGURED TO PROVIDE A TEMPERATURE RANGE OR DEAD BAND OF AT LEAST 5°F WITHIN WHICH THE SUPPLY OF HEATING AND COOLING ENERGY TO THE ZONE IS SHUT OFF OR REDUCED TO A MINIMUM.

C. 6.4.3.2 SET-POINT OVERLAP RESTRICTION

WHERE HEATING AND COOLING TO A ZONE ARE CONTROLLED BY SEPARATE ZONE THERMOSTATIC CONTROLS LOCATED WITHIN THE ZONE, MEANS (SUCH AS LIMIT SWITCHES; MECHANICAL STOPS; OR, FOR DDC SYSTEMS, SOFTWARE PROGRAMMING) SHALL BE PROVIDED TO PREVENT THE HEATING SET POINT FROM EXCEEDING THE COOLING SET POINT, MINUS ANY APPLICABLE PROPORTIONAL BAND.

D. 6.4.3.3 OFF-HOUR CONTROLS

HVAC SYSTEMS SHALL HAVE THE OFF-HOUR CONTROLS REQUIRED BY SECTIONS 6.4.3.3.1 THROUGH 6.4.3.3.5.

E. 6.4.3.3.1 AUTOMATIC SHUTDOWN

HVAC SYSTEMS SHALL BE EQUIPPED WITH AT LEAST ONE OF THE FOLLOWING:

a. CONTROLS THAT CAN START AND STOP THE SYSTEM UNDER DIFFERENT TIME SCHEDULES FOR SEVEN DIFFERENT DAY TYPES PER WEEK, ARE CAPABLE OF RETAINING PROGRAMMING AND TIME SETTING DURING LOSS OF POWER FOR A PERIOD OF AT LEAST TEN HOURS, AND INCLUDE AN ACCESSIBLE MANUAL OVERRIDE OR EQUIVALENT FUNCTION THAT ALLOWS TEMPORARY OPERATION OF THE SYSTEM FOR UP TO TWO HOURS.

b. AN OCCUPANCY SENSOR THAT IS CAPABLE OF SHUTTING THE SYSTEM OFF WHEN NO OCCUPANT IS SENSED FOR A PERIOD OF UP TO 30 MINUTES.

c. A MANUALLY OPERATED TIMER CAPABLE OF BEING ADJUSTED TO OPERATE THE SYSTEM FOR UP TO TWO HOURS.

d. AN INTERLOCK TO A SECURITY SYSTEM THAT SHUTS THE SYSTEM OFF WHEN THE SECURITY SYSTEM IS ACTIVATED.

F. 6.4.3.3.2 SETBACK CONTROLS

HEATING SYSTEMS SHALL BE EQUIPPED WITH CONTROLS CAPABLE OF AND CONFIGURED TO AUTOMATICALLY RESTART AND TEMPORARILY OPERATE THE SYSTEM AS REQUIRED TO MAINTAIN ZONE TEMPERATURES ABOVE AN ADJUSTABLE HEATING SET POINT AT LEAST 10°F BELOW THE OCCUPIED HEATING SET POINT. COOLING SYSTEMS SHALL BE EQUIPPED WITH CONTROLS CAPABLE OF AND CONFIGURED TO AUTOMATICALLY RESTART AND TEMPORARILY OPERATE THE MECHANICAL COOLING SYSTEM AS REQUIRED TO MAINTAIN ZONE TEMPERATURES BELOW AN ADJUSTABLE COOLING SET POINT AT LEAST 5°F ABOVE THE OCCUPIED COOLING SET POINT OR TO PREVENT HIGH SPACE HUMIDITY LEVELS.

GENERAL NOTES

1. CONTRACTOR SHALL SURVEY THE AREA OF THIS WORK BEFORE SUBMITTING A BID AND SHALL BE RESPONSIBLE FOR NOTIFYING THE ARCHITECT OF ANY CONDITIONS WHICH WOULD PREVENT THE INSTALLATION OF THE WORK AS SHOWN ON DRAWINGS.
2. ALL APPLICABLE CODES, LAWS AND REGULATIONS GOVERNING OR RELATING TO ANY PORTION OF THIS WORK ARE HEREBY INCORPORATED INTO AND MADE A PART OF THESE SPECIFICATIONS, AND THEIR PROVISIONS SHALL BE CARRIED OUT BY THE CONTRACTOR WHO SHALL INFORM THE OWNER, PRIOR TO SUBMITTING A PROPOSAL, OF ANY WORK OR MATERIALS WHICH VIOLATE ANY OF THE ABOVE LAWS AND REGULATIONS. ANY WORK DONE BY THE CONTRACTOR CAUSING SUCH VIOLATION SHALL BE CORRECTED BY THE CONTRACTOR.
3. BEFORE PROCEEDING WITH ANY WORK IN OCCUPIED OR USED AREAS, THE CONTRACTOR SHALL APPLY TO OWNER FOR PERMISSION TO ENTER SUCH AREAS. THE CONTRACTOR IS OBLIGED TO PERFORM HIS WORK ONLY AT THE TIMES DESIGNATED BY OWNER. THERE WILL BE NO ADDITIONAL COMPENSATION FOR THE WORK PERFORMED AFTER HOURS OR ON OFF-DAYS WITHOUT PRIOR WRITTEN APPROVAL.
4. THE WORK IN THE BUILDING SHALL BE DONE WHEN AND AS DIRECTED, AND IN A MANNER SATISFACTORY TO THE OWNER. THE WORK SHALL BE PERFORMED SO AS TO CAUSE THE LEAST POSSIBLE INCONVENIENCE AND DISTURBANCE TO THE PRESENT OCCUPANTS.
5. THE CONTRACTOR'S PROPOSAL FOR ALL WORK SHALL BE PREDICATED ON THE PERFORMANCE OF THE WORK DURING REGULAR WORKING HOURS. WHEN SO DIRECTED, HOWEVER, THE CONTRACTOR SHALL INSTALL WORK IN OVERTIME AND THE ADDITIONAL COST TO BE CHARGED THEREFORE SHALL BE ONLY THE "PREMIUM" PORTION OF THE WAGES PAID.
6. CONTRACTOR SHALL ASCERTAIN THE APPROPRIATE METHOD FOR BRINGING THE UNITS INTO AND THROUGH THE BUILDING TO POSITION UNIT IN LOCATION SHOWN ON THE PLANS. WHERE NECESSARY, EQUIPMENT SHALL BE SHIPPED FROM MANUFACTURER IN SECTIONS OF SIZE SUITABLE FOR MOVING THROUGH RESTRICTIVE SPACES. COORDINATE WITH BUILDING OWNER APPROPRIATE TIMES OF DAY SUCH EQUIPMENT MAY BE MOVED THROUGH ALL AREAS.
7. DUCTWORK AND PIPING IS SHOWN DIAGRAMMATICALLY AND DOES NOT SHOW ALL OFFSETS, DROPS AND RISES OF RUNS. THE CONTRACTOR SHALL MAKE ALLOWANCE IN PRICING FOR ROUTING OF DUCTWORK AND PIPING TO AVOID OBSTRUCTIONS. EXACT LOCATIONS ARE SUBJECT TO APPROVAL OF ARCHITECT. COORDINATION WITH THE OTHER TRADES IS REQUIRED.
8. SUPPORT ALL DUCTWORK AND PIPING FROM BUILDING STRUCTURE AND/OR FRAMING IN AN APPROVED MANNER. WHERE OVERHEAD CONSTRUCTION DOES NOT PERMIT FASTENING OR SUPPORTS FOR EQUIPMENT, FURNISH ADDITIONAL FRAMING. INSERTS SHALL BE STEEL, SLOTTED TYPE AND FACTORY PAINTED. SINGLE ROD SHALL BE SIMILAR TO GRINNELL FIG. 281. MULTI-ROD SHALL BE SIMILAR TO FEE & MASON SERIES 9000 WITH END CAPS AND CLOSURE STRIPS. MAXIMUM LOADING INCLUDING PIPES, DUCTWORK CONTENTS AND COVERING SHALL NOT EXCEED 75% OF RATED INSERT CAPABILITY. WHEN SUPPORTING FROM BUILDING USE BEAM CLAMPS IN APPROVED MANNER.
9. PROVIDE ALL NECESSARY FLASHING AND COUNTER FLASHING TO MAINTAIN THE WATERPROOFING INTEGRITY OF THIS BUILDING AS REQUIRED BY THE INSTALLATION OR REMOVAL OF PIPES, DUCTS, LOUVERS, CONDUIT, AND EQUIPMENT. PROVIDE EQUIPMENT CURBS AND DUNNAGE STEEL AS REQUIRED.
10. SEAL OPENINGS AROUND DUCTS AND PIPING THROUGH PARTITIONS, WALLS AND FLOORS (NOT IN SHAFTS) WITH MINERAL WOOL OR OTHER NONCOMBUSTIBLE MATERIAL (FIBERGLASS INSULATION IS NOT ACCEPTABLE).
11. WHERE PENETRATIONS THROUGH FIRE RATED WALLS ARE NOT FIRE PROOFED THIS CONTRACTOR SHALL BE RESPONSIBLE TO SEAL SAME TO MAINTAIN THE RATED INTEGRITY.
12. INSTALL WORK SO AS TO BE READILY ACCESSIBLE FOR OPERATION, MAINTENANCE AND REPAIR. MINOR DEVIATIONS FROM DRAWINGS MAY BE MADE TO ACCOMPLISH THIS, BUT CHANGES WHICH INVOLVE EXTRA COST SHALL NOT BE MADE WITHOUT APPROVAL.
13. ACCESS DOORS ARE REQUIRED FOR ALL BUILDING SERVICE VALVES THAT RUN THROUGH THE SPACE, AND ACCESS DOOR SHALL HAVE THE EQUAL RATED CAPACITY (1HR, 2HR, ETC.) AS WALL. COORDINATE ALL LOCATIONS OF ACCESS DOORS WITH THE ARCHITECT.
14. REMOVABLE ACCESS TILE AND/OR ACCESS DOOR ARE REQUIRED IN HUNG CEILINGS, SHAFTS AND WALLS FOR ALL VOLUME AND FIRE DAMPERS, AUTOMATIC DAMPERS AND ALL OTHER MECHANICAL EQUIPMENT AND DEVICES. HVAC CONTRACTOR TO FURNISH ACCESS LOCATION REQUIREMENTS TO GENERAL CONTRACTOR. ACCESS TILE IDENTIFICATION: PROVIDE BUTTONS, TABS, AND MARKERS TO IDENTIFY LOCATION OF CONCEALED VALVES, DAMPERS AND EQUIPMENT.
15. THE CONTRACTOR SHALL KEEP ALL EQUIPMENT AND MATERIALS, AND ALL PARTS OF THE BUILDING, EXTERIOR SPACES AND ADJACENT STREETS, SIDEWALKS AND PAVEMENTS, FREE FROM MATERIAL AND DEBRIS RESULTING FROM THE EXECUTION OF THIS WORK. EXCESS MATERIALS WILL NOT BE PERMITTED TO ACCUMULATE EITHER ON THE INTERIOR OR THE EXTERIOR.
16. MATERIALS AND WORKMANSHIP, UNLESS OTHERWISE NOTED, SHALL BE IN ACCORDANCE WITH BUILDING STANDARDS.
17. ALL EQUIPMENT SHALL BE PROVIDED WITH ONE YEAR WARRANTY PARTS AND LABOR AND FIVE YEARS ON COMPRESSORS. WARRANTY PERIOD BEGINS UPON PROJECT ACCEPTANCE
18. ALL MATERIAL AND EQUIPMENT TO BE NEW UNLESS OTHERWISE NOTED AND SHALL BE IN ACCORDANCE WITH BUILDING STANDARDS.
19. THE CONTRACTOR SHALL BE RESPONSIBLE FOR HIS WORK WITH ITS COMPLETION AND FINAL ACCEPTANCE AND SHALL REPLACE ANY OF THE SAME WHICH MAY BE DAMAGED, LOST, OR STOLEN WITHOUT ADDITIONAL COST TO THE OWNER.
20. THE CONTRACTOR SHALL BE RESPONSIBLE FOR THE FAILURE OF ANY DUCTWORK SYSTEM OR EQUIPMENT TO FUNCTION PROPERLY UPON COMPLETION OF HIS WORK UPON SAID SYSTEM OR EQUIPMENT.
21. SUBMIT SHOP DRAWING OF ALL WORK WHICH MUST BE APPROVED BY THE ARCHITECT AND ENGINEER BEFORE WORK COMMENCES.
22. INSURANCE: IN ACCORDANCE WITH BUILDING REQUIREMENTS THE CONTRACTOR SHALL INCLUDE A HOLD HARMLESS CLAUSE FOR OWNER AND ENGINEER.
23. THE FINAL ACCEPTANCE WILL BE MADE AFTER THE CONTRACTOR HAS ADJUSTED HIS EQUIPMENT, BALANCED THE VARIOUS SYSTEMS, DEMONSTRATED THAT IT FULFILLS THE REQUIREMENTS OF THE DRAWINGS AND SPECIFICATIONS AND HAS FURNISHED ALL THE REQUIRED CERTIFICATES OF INSPECTION AND APPROVAL.
24. SPECIFICATIONS ARE OF SIMPLIFIED FORM AND INCLUDE INCOMPLETE SENTENCES. WORDS OR PHRASES SUCH AS "THE CONTRACTOR SHALL," "SHALL BE," "FURNISH," "PROVIDE," "A," "THE," AND "ALL" HAVE BEEN OMITTED FOR BREVITY.
25. WHERE A CONFLICT EXISTS BETWEEN THE DRAWINGS, THE SPECIFICATIONS OR ANY OTHER CONSTRUCTION DOCUMENT, THE ONE WITH THE MOST STRINGENT REQUIREMENT(S) SHALL APPLY.

DEFINITIONS:

1) "PROVIDE": TO SUPPLY, INSTALL AND CONNECT UP COMPLETE AND READY FOR SAFE AND REGULAR OPERATION THE PARTICULAR WORK REFERRED TO UNLESS SPECIFICALLY OTHERWISE NOTED.
2) "INSTALL": TO ERECT, MOUNT AND CONNECT COMPLETE WITH RELATED ACCESSORIES.
3) "FURNISH" OR "SUPPLY": TO PURCHASE, PROCURE, ACQUIRE AND DELIVER COMPLETE WITH RELATED ACCESSORIES.

GENERAL HVAC NOTES

1. PROVIDE ALL MATERIAL AND EQUIPMENT AND PERFORM ALL LABOR REQUIRED TO INSTALL COMPLETE AND OPERABLE MECHANICAL SYSTEMS AS INDICATED ON THE DRAWINGS, AS SPECIFIED AND AS REQUIRED BY CODE.
2. CONTRACT DOCUMENT DRAWINGS FOR MECHANICAL WORK (HVAC, PLUMBING, AND FIRE PROTECTION) ARE DIAGRAMMATIC AND ARE INTENDED TO CONVEY SCOPE AND GENERAL ARRANGEMENT ONLY.
3. THE LOCATIONS OF ALL ITEMS SHOWN ON THE DRAWINGS OR CALLED FOR IN THE SPECIFICATIONS THAT ARE NOT FIXED BY DIMENSIONS ARE APPROXIMATE ONLY. THE EXACT LOCATIONS NECESSARY TO SECURE THE BEST CONDITIONS AND RESULTS MUST BE DETERMINED BY THE PROJECT SITE CONDITIONS AND SHALL HAVE THE APPROVAL OF THE ENGINEER BEFORE BEING INSTALLED. DO NOT SCALE DRAWINGS.
4. WHEN MECHANICAL WORK (HVAC, PLUMBING, SHEET METAL, FIRE PROTECTION, ETC.) IS SUBCONTRACTED, IT SHALL BE THE MECHANICAL CONTRACTOR'S RESPONSIBILITY TO COORDINATE SUBCONTRACTORS AND THE ASSOCIATED CONTRACTS. WHEN DISCREPANCIES ARISE PERTAINING TO WHICH CONTRACTOR PROVIDES A PARTICULAR ITEM OF THE MECHANICAL CONTRACT OR WHICH CONTRACTOR PROVIDES FINAL CONNECTIONS FOR A PARTICULAR ITEM OF THE MECHANICAL CONTRACT, IT SHALL BE BROUGHT TO THE ATTENTION OF THE MECHANICAL CONTRACTOR, WHOSE DECISION SHALL BE FINAL.
5. COORDINATE CONSTRUCTION OF ALL MECHANICAL WORK WITH ARCHITECTURAL, STRUCTURAL, CIVIL, ELECTRICAL WORK, ETC., SHOWN ON OTHER CONTRACT DOCUMENT DRAWINGS.
6. INSTALL ALL MECHANICAL EQUIPMENT AND APPURTENANCES IN ACCORDANCE WITH MANUFACTURER'S RECOMMENDATIONS, CONTRACT DOCUMENTS, AND APPLICABLE CODES AND REGULATIONS.
7. WHERE TWO OR MORE ITEMS OF THE SAME TYPE OF EQUIPMENT ARE REQUIRED, THE PRODUCT OF ONE MANUFACTURER SHALL BE USED.
8. COORDINATE ALL EQUIPMENT CONNECTIONS WITH MANUFACTURERS' CERTIFIED DRAWINGS. COORDINATE AND PROVIDE ALL DUCT AND PIPING TRANSITIONS REQUIRED FOR FINAL EQUIPMENT CONNECTIONS TO FURNISHED EQUIPMENT. FIELD VERIFY AND COORDINATE ALL DUCT AND PIPING DIMENSIONS BEFORE FABRICATION.
9. ALL CONTROL WIRE AND CONDUIT SHALL COMPLY WITH THE NATIONAL ELECTRIC CODE AND ELECTRICAL DIVISION OF THE SPECIFICATION.
10. PROVIDE VIBRATION ISOLATION FOR ALL MECHANICAL EQUIPMENT TO PREVENT TRANSMISSION OF VIBRATION TO BUILDING STRUCTURE.
11. LOCATE ALL TEMPERATURE, PRESSURE, AND FLOW MEASURING DEVICES IN ACCESSIBLE LOCATIONS WITH THE STRAIGHT SECTION OF PIPE OR DUCT UP- AND DOWNSTREAM AS RECOMMENDED BY THE MANUFACTURER FOR GOOD ACCURACY.
12. WHERE BEAMS ARE INDICATED TO BE PENETRATED WITH DUCTWORK OR PIPING, COORDINATE DUCTWORK AND PIPING LAYOUT WITH BEAM OPENING SIZE AND OPENING LOCATIONS. COORDINATION SHALL BE DONE PRIOR TO THE FABRICATION OF DUCTWORK, CUTTING OF PIPING, OR FABRICATION OF BEAMS.
13. ALL MISCELLANEOUS STEEL REQUIRED TO ENSURE PROPER INSTALLATION AND AS SHOWN IN THE DETAILS FOR PIPING, DUCTWORK, AND EQUIPMENT (UNLESS OTHERWISE NOTED) SHALL BE FURNISHED AND INSTALLED BY THE MECHANICAL CONTRACTOR.
14. PROVIDE ACCESS PANELS FOR INSTALLATION IN WALLS AND CEILINGS, WHERE REQUIRED, TO SERVICE DAMPERS, VALVES, SMOKE DETECTORS, AND OTHER CONCEALED MECHANICAL EQUIPMENT. ACCESS PANELS SHALL BE TURNED OVER TO THE GENERAL CONTRACTOR FOR INSTALLATION. ACCESS PANELS SHALL HAVE THE EQUAL RATED CAPACITY (1HR, 2HR, ETC.) AS WALL.
15. MECHANICAL EQUIPMENT, DUCTWORK, AND PIPING SHALL NOT BE SUPPORTED FROM A METAL DECK.
16. ALL EQUIPMENT, PIPING, DUCTWORK, ETC., SHALL BE SUPPORTED AS DETAILED, SPECIFIED AND REQUIRED TO PROVIDE A VIBRATION-FREE INSTALLATION.
17. ALL DUCTWORK, PIPING, AND EQUIPMENT SUPPORTED FROM STRUCTURAL STEEL SHALL BE COORDINATED WITH THE GENERAL CONTRACTOR. ALL ATTACHMENTS TO STEEL BAR JOISTS, TRUSSES, OR JOIST GIRDERS SHALL BE AT PANEL POINTS. PROVIDE BEAM CLAMPS MEETING MSS STANDARDS. WELDING TO STRUCTURAL MEMBERS SHALL NOT BE PERMITTED. THE USE OF C-CLAMPS SHALL NOT BE PERMITTED.
18. ALL ROOF-MOUNTED EQUIPMENT CURBS/STEEL RAILS FOR EQUIPMENT PROVIDED BY THE MECHANICAL CONTRACTOR SHALL BE FURNISHED BY THE MECHANICAL CONTRACTOR AND INSTALLED BY THE GENERAL CONTRACTOR.
19. LOCATIONS AND SIZES OF ALL FLOOR, WALL, AND ROOF OPENINGS SHALL BE COORDINATED WITH ALL OTHER TRADES INVOLVED.
20. ALL OPENINGS IN FIRE WALLS DUE TO DUCTWORK, PIPING, CONDUIT, ETC., SHALL BE FIRE STOPPED WITH A PRODUCT SIMILAR TO 3M OR APPROVED EQUAL.
21. ALL AIR CONDITIONING CONDENSATE DRAIN LINES FROM EACH AIR HANDLING UNIT SHALL BE PIPED FULL SIZE OF THE UNIT DRAIN OUTLET, WITH "P" TRAP, AND PIPED TO THE NEAREST DRAIN. SEE THE DETAILS SHOWN IN THE DRAWINGS OR THE CONTRACT SPECIFICATIONS FOR THE DEPTH OF THE AIR CONDITIONING CONDENSATE TRAP.
22. REFER TO TYPICAL DETAILS FOR DUCTWORK, PIPING, AND EQUIPMENT INSTALLATION.

SCOPE OF WORK

SCOPE OF WORK

1. THE WORK UNDER CONTRACT INCLUDES ALL LABOR, MATERIALS AND APPLIANCES NECESSARY FOR THE FURNISHING, INSTALLING AND TESTING, COMPLETE AND READY FOR SAFE OPERATION OF THE SYSTEMS AS DESCRIBED IN THE SPECIFICATIONS, FLOOR PLAN(S) DESIGN, DETAIL DRAWINGS, NOTES, RFI'S, ETC. FOR THIS PROJECT. WORK SHALL BE INSTALLED IN A NEAT, WORKMANLIKE MANNER.
2. THE CONTRACTOR SHALL GIVE NECESSARY NOTICE, FILE DRAWINGS AND SPECIFICATIONS WITH THE DEPARTMENT HAVING JURISDICTION, OBTAIN PERMITS OR LICENSES NECESSARY TO CARRY OUT THIS WORK AND PAY ALL FEES THEREFORE. THE CONTRACTOR SHALL ARRANGE FOR INSPECTION AND TESTS OF ANY OR ALL PARTS OF THE WORK IF SO REQUIRED BY AUTHORITIES AND PAY ALL CHARGES FOR SAME. THE CONTRACTOR SHALL PAY ALL COSTS FOR, AND FURNISH TO THE OWNER BEFORE FINAL BILLING, ALL CERTIFICATES NECESSARY AS EVIDENCE THAT THE WORK INSTALLED CONFORMS WITH ALL REGULATIONS WHERE THEY APPLY TO THIS WORK.
3. THE CONTRACTOR SHALL FURNISH A WRITTEN GUARANTEE TO REPLACE OR REPAIR PROMPTLY AND ASSUME RESPONSIBILITY FOR ALL EXPENSES INCURRED FOR ANY WORKMANSHIP AND EQUIPMENT IN WHICH DEFECTS DEVELOP WITHIN ONE YEAR FROM THE DATE OF FINAL CERTIFICATE FOR PAYMENT AND/OR FROM DATE OR ACTUAL USE OF EQUIPMENT OR OCCUPANCY OF SPACES, BY OWNER, INCLUDED UNDER THE VARIOUS PARTS OF THE WORK, WHICHEVER DATE IS EARLIER. THIS WORK SHALL BE DONE AS DIRECTED BY THE OWNER. THIS GUARANTEE SHALL ALSO PROVIDE THAT WHERE DEFECTS OCCUR, THE CONTRACTOR WILL ASSUME RESPONSIBILITY FOR ALL EXPENSES INCURRED IN REPAIRING AND REPLACING WORK OF OTHER TRADES AFFECTED BY DEFECTS, REPAIRS OR REPLACEMENTS IN EQUIPMENT SUPPLIED BY THE CONTRACTOR.

Property of NY Engineers

PROJECT:
REDLINE ATHLETICS - FLEMINGTON NJ

DRAWING TITLE:
MECHANICAL SYMBOL LIST, ABBREVIATIONS & NOTES

SHEET:
M-001

SPECIFICATIONS

SECTION 0001 - NOTICE TO BIDDERS

1.1 BIDDERS REPRESENTATIONS

A. THE BIDDER BY MAKING A BID REPRESENTS THAT:

B. THE BIDDER HAS READ AND UNDERSTANDS THE BIDDING DOCUMENTS, TO THE EXTENT THAT SUCH DOCUMENTATION RELATES TO THE WORK FOR WHICH THE BID IS SUBMITTED, AND FOR OTHER PORTIONS OF THE PROJECT, IF ANY, BEING BID CONCURRENTLY OR PRESENTLY UNDER CONSTRUCTION.

C. THE BID IS MADE IN COMPLIANCE WITH THE BIDDING DOCUMENTS.

D. THE SPECIFICATIONS AND DRAWINGS ARE INTENDED TO SERVE JOINTLY AS A BASIS FOR THE BIDDER TO SUBMIT A CONTRACT PRICE FOR THE MATERIAL AND LABOR.

E. SHOULD CONFLICTS OR DISCREPANCIES OCCUR WITHIN THE BIDDING DOCUMENTS, THE ITEM OR ITEMS IN DISPUTE THAT REPRESENT THE GREATER COST SHALL PREVAIL IN THE FINAL BID.

F. THE BID IS BASED UPON THE MATERIALS, EQUIPMENT AND SYSTEMS REQUIRED BY THE BIDDING DOCUMENTS WITHOUT EXCEPTION.

1.2 EXISTING CONDITIONS AND COORDINATION

A. THE BIDDER HAS VISITED THE SITE, BECOME FAMILIAR WITH LOCAL CONDITIONS UNDER WHICH THE WORK IS TO BE PERFORMED, AND HAS CORRELATED THE BIDDER'S OBSERVATIONS WITH THE REQUIREMENTS OF THE PROPOSED BIDDING DOCUMENTS.

B. THE BIDDER SHALL PROPOSE COORDINATION OF WORK SUCH THAT CONFLICTS WITH OTHER TRADES AND SPACE ALLOCATIONS ARE AVOIDED.

1.3 RESPONSIBILITIES

A. THE BIDDER UNDERSTANDS THAT ANY CONTRACTOR SHALL BE FULLY RESPONSIBLE FOR THE TIMELY COMPLETION AND ACCEPTANCE OF THEIR WORK AND THAT ANY ITEMS DAMAGED, LOST, OR STOLEN DURING TIME OF CONSTRUCTION SHALL BE REPAIRED OR REPLACED WITHOUT ANY ADDITIONAL COST TO THE OWNER.

B. THE BIDDER UNDERSTANDS THAT ANY PROPOSED WORK IN OCCUPIED TENANT SPACES SHALL BE PERFORMED DURING TIMES OF NON-TENANT OCCUPANCY OR AS SCHEDULED OR DIRECTED BY THE BUILDING MANAGER.

C. THE BIDDER UNDERSTANDS THAT ANY PROPOSED SHUTDOWN OF EXISTING SYSTEMS DURING CONSTRUCTION SHALL BE PRE-ARRANGED WITH THE BUILDING MANAGER AND THAT SUCH SHUTDOWNS ARE TO BE KEPT TO A MINIMUM.

END OF SECTION 0001

SECTION 0101 - QUALITY OF WORK

1.1 WORKMANSHIP

A. ALL WORK SHALL BE FREE FROM DEFECTS IN MATERIALS AND WORKMANSHIP FOR A PERIOD OF ONE YEAR FROM DATE OF FINAL ACCEPTANCE.

B. ALL DEFECTS WHICH DEVELOP OR ARE DISCOVERED WITHIN THIS PERIOD SHALL BE REPAIRED BY THE CONTRACTOR TO THE SATISFACTION OF THE ARCHITECT OR BUILDING MANAGER AT NO ADDITIONAL COST TO THE OWNER.

C. UPON COMPLETION OF THE WORK THE CONTRACTOR SHALL REMOVE FROM THE SITE, ALL TOOLS, DEMOLISHED APPLIANCES AND ANY SURPLUS MATERIAL.

1.2 CODE COMPLIANCE

A. ALL WORK SHALL MEET ALL STATE AND LOCAL CODES HAVING JURISDICTION.

END OF SECTION 0101

SECTION 0102 -REQUIRED DOCUMENTS

1.1 SHOP DRAWINGS

A. A SET OF PRINTS FOR ANY MECHANICAL WORK INCLUDING BUT NOT LIMITED TO, DUCTWORK AND PIPING LAYOUT SHALL BE SUBMITTED FOR APPROVAL TO THE ENGINEER PRIOR TO CONSTRUCTION OR PURCHASE OF MATERIALS.

1.2 SUBMITTALS

A. EQUIPMENT SUBMITTALS OF ALL PROPOSED MECHANICAL AND ANCILLARY EQUIPMENT INCLUDING ALL ACCESSORIES SHALL BE SUBMITTED TO THE ENGINEER FOR REVIEW. ALL PERTINENT MODELS, SIZES, ACCESSORIES, AND CHOICES SHALL BE CHECKED, PRINTED, OR OTHERWISE INDICATED ON THE SUBMITTALS.

1.3 RECORD DRAWINGS

A. UPON COMPLETION OF THE WORK, A RECORD DRAWING SHALL BE SUBMITTED TO THE OWNER DEPICTING ALL SUBSEQUENT CHANGES, ADDITIONS AND OR CORRECTIONS TO THE CONTRACT DRAWINGS AND OR CONTRACT SCOPE MADE DURING CONSTRUCTION. THIS DRAWING SHALL REPRESENT A COMPLETE RECORD OF THE WORK INSTALLED.

1.4 EQUIPMENT OPERATING INSTRUCTIONS

A. ON COMPLETION AND ACCEPTANCE OF WORK, THIS CONTRACTOR SHALL FURNISH WRITTEN INSTRUCTIONS, EQUIPMENT MANUALS AND DEMONSTRATE TO THE OWNER THE PROPER OPERATION AND MAINTENANCE OF ALL EQUIPMENT AND APPARATUS FURNISHED UNDER THIS CONTRACT.

B. THESE INSTRUCTIONS SHALL BE TYPED ON 8-1/2 IN. X 11 IN. PAPER AND BOUND IN THREE-RING BINDERS WITH CLEAR ACETATE COVERS. THE CONTRACTOR SHALL GIVE THREE COPIES OF THE INSTRUCTIONS TO THE OWNER AND ONE ELECTRONIC COPY TO THE ENGINEER.

C. THE INSTRUCTION BOOKLET SHALL BE ORGANIZED IN SECTIONS, WITH ONE SECTION PER SYSTEM. THE COVER OF THE INSTRUCTION BOOKLET SHALL BEAR THE NAME, ADDRESS AND PHONE NUMBER OF THE PROJECT, ARCHITECT, ENGINEER, MECHANICAL CONTRACTOR AND SUBCONTRACTORS.

END OF SECTION 0102

SECTION 078413-PENETRATION FIRE-STOPPING

1.1 QUALITY ASSURANCE

A. INSTALLER QUALIFICATIONS: AN FM GLOBAL-APPROVED FIRE-STOP CONTRACTOR OR A UL-QUALIFIED FIRE-STOP CONTRACTOR.

B. FIRE-TEST-RESPONSE CHARACTERISTICS: UL, INTERTEK ETL SEMKO OR FM GLOBAL

1.2 PENETRATION FIRESTOPPING

A. PENETRATIONS IN FIRE-RESISTANCE-RATED WALLS: F-RATINGS PER ASTM E 814 OR UL 1479.

B. PENETRATIONS IN HORIZONTAL ASSEMBLIES: F- AND T-RATINGS PER ASTM E 814 OR UL 1479:

C. PENETRATIONS IN SMOKE BARRIERS: L-RATINGS PER UL 1479.

D. W-RATINGS: PER UL 1479.

1.3 INSTALLATION

A. IDENTIFICATION: PREPRINTED METAL OR PLASTIC LABELS.

1.5 FIELD QUALITY CONTROL

A. INSPECTION OF INSTALLED FIRE-STOPPING: BY OWNER-ENGAGED AGENCY ACCORDING TO ASTM E 2174.

1.5 THROUGH-PENETRATION FIRESTOP SYSTEM SCHEDULE:

A. WHERE UL-CLASSIFIED SYSTEMS ARE INDICATED, THEY REFER TO SYSTEM NUMBERS IN UL'S "FIRE RESISTANCE DIRECTORY" UNDER PRODUCT CATEGORY XHEZ.

B. FOR THE FOLLOWING SYSTEMS: METALLIC AND NON-METALLIC PIPES, CONDUIT, OR TUBING, ELECTRICAL CABLES, CABLE TRAYS WITH ELECTRIC CABLES, MISCELLANEOUS ELECTRICAL PENETRANTS, INSULATED PIPES, GROUPINGS OF PENETRANTS, USE ONE OR MORE OF THE FOLLOWING MATERIALS:

a. LATEX SEALANT

b. SILICONE SEALANT

c. MORTAR

d. SILICONE FOAM

e. PILLOWS/BAGS

f. INTUMESCENT WRAP STRIPS

1.6 MANUFACTURERS

A. HILTI CONSTRUCTION CHEMICAL, INC

B. 3M FIRE PROTECTION PRODUCTS

END OF SECTION 078413

SECTION 230517 - SLEEVES AND SLEEVE SEALS FOR HVAC PIPING

1.1 SLEEVE-SEAL SYSTEMS

A. FIELD-ASSEMBLED, MODULAR SEALING-ELEMENT UNIT FOR FILLING ANNULAR SPACE BETWEEN PIPING AND SLEEVE.

1. SEALING ELEMENTS: EPDM RUBBER OR NBR.
2. PRESSURE PLATES: CARBON STEEL, PLASTIC, STAINLESS STEEL.
3. CONNECTING BOLTS AND NUTS: CARBON STEEL WITH CORROSION-RESISTANT COATING, STAINLESS STEEL.

B. MANUFACTURERS: SUBJECT TO COMPLIANCE WITH REQUIREMENTS, AVAILABLE MANUFACTURERS OFFERING PRODUCTS THAT MAY BE INCORPORATED INTO THE WORK INCLUDE, BUT ARE NOT LIMITED TO, THE FOLLOWING:

1. ADVANCE PRODUCTS & SYSTEMS, INC.
2. CALPICO, INC.
3. METRAFLEX COMPANY (THE).
4. PIPELINE SEAL AND INSULATOR, INC.

1.2 SLEEVE-SEAL FITTINGS

A. MANUFACTURED PLASTIC, SLEEVE-TYPE, PLASTIC OR RUBBER WATER-STOP ASSEMBLY MADE FOR IMBEDDING IN CONCRETE SLAB OR WALL.

1.3 GROUT

A. NON-SHRINK, FACTORY PACKAGED.

1.4 SLEEVE AND SLEEVE-SEAL SCHEDULE

A. USE SLEEVES AND SLEEVE SEALS FOR THE FOLLOWING PIPING-PENETRATION APPLICATIONS:

1. INTERIOR PARTITIONS:

a. PIPING SMALLER THAN NPS 6 (DN 150): GALVANIZED-STEEL-PIPE SLEEVES, PVC-PIPE SLEEVES.

b. PIPING NPS 6 (DN 150) AND LARGER: GALVANIZED-STEEL-SHEET SLEEVES.

END OF SECTION 230517

SECTION 230529 - HANGERS AND SUPPORTS FOR HVAC PIPING AND EQUIPMENT

1.1 PERFORMANCE REQUIREMENTS

A. DELEGATED DESIGN: DESIGN TRAPEZE PIPE HANGERS AND EQUIPMENT SUPPORTS, INCLUDING COMPREHENSIVE ENGINEERING ANALYSIS BY A QUALIFIED PROFESSIONAL ENGINEER, USING PERFORMANCE REQUIREMENTS AND DESIGN CRITERIA INDICATED.

B. STRUCTURAL PERFORMANCE: HANGERS AND SUPPORTS FOR HVAC PIPING AND EQUIPMENT SHALL WITHSTAND THE EFFECTS OF GRAVITY LOADS AND STRESSES WITHIN LIMITS AND UNDER CONDITIONS INDICATED ACCORDING TO ASCE/SEI 7.

1. DESIGN SUPPORTS FOR MULTIPLE PIPES CAPABLE OF SUPPORTING COMBINED WEIGHT OF SUPPORTED SYSTEMS, SYSTEM CONTENTS, AND TEST WATER.
2. DESIGN EQUIPMENT SUPPORTS CAPABLE OF SUPPORTING COMBINED OPERATING WEIGHT OF SUPPORTED EQUIPMENT AND CONNECTED SYSTEMS AND
3. DESIGN SEISMIC-RESTRAINT HANGERS AND SUPPORTS FOR PIPING AND EQUIPMENT AND OBTAIN APPROVAL FROM AUTHORITIES HAVING JURISDICTION.

1.2 SUBMITTALS

A. SHOP DRAWINGS: SIGNED AND SEALED BY A PROFESSIONAL ENGINEER

1.3 QUALITY ASSURANCE

A. AWS D1.1/D1.1M, "STRUCTURAL WELDING CODE - STEEL."

1.4 COMPONENTS

A. METAL PIPE HANGERS AND SUPPORTS: CARBON OR STAINLESS STEEL

B. FIBERGLASS PIPE HANGERS: -CLEVIS, CENTURY COMPOSITES, COOPER B-LINE

D. METAL FRAMING SYSTEMS: MFMA MANUFACTURER

E. FIBERGLASS STRUT SYSTEMS: COOPER B-LINE

F. THERMAL-HANGER SHIELD INSERTS:

G. FASTENER SYSTEMS: POWDER-ACTUATED FASTENERS OR MECHANICAL-EXPANSION ANCHORS

H. PIPE STANDS: COMPACT, LOW TYPE, SINGLE PIPE, HIGH TYPE, SINGLE PIPE, HIGH TYPE, MULTIPLE PIPES, CURB-MOUNTED TYP EQUIPMENT SUPPORTS.

END OF SECTION 230529

SECTION 230548 - VIBRATION CONTROLS FOR PIPING AND HVAC EQUIPMENT

PART 1 - GENERAL

1.1 PERFORMANCE REQUIREMENTS

A. SEISMIC-RESTRAINT LOADING:

1. SITE CLASS AS DEFINED IN THE IBC: A, B
2. ASSIGNED SEISMIC USE GROUP OR BUILDING CATEGORY AS DEFINED IN THE IBC: I II III
   a. COMPONENT IMPORTANCE FACTOR: 1.0
   b. COMPONENT RESPONSE MODIFICATION FACTOR: 2.5
   c. COMPONENT AMPLIFICATION FACTOR: 2.5.
3. DESIGN SPECTRAL RESPONSE ACCELERATION AT SHORT PERIODS (0.2 SECOND) 18%
4. DESIGN SPECTRAL RESPONSE ACCELERATION AT 1-SECOND PERIOD: 8%

1.2 COMPONENTS

A. VIBRATION ISOLATORS:

1. ISOLATOR PADS: NEOPRENE, RUBBER, HERMETICALLY AND/OR SEALED COMPRESSED FIBERGLASS
2. MOUNTS: DOUBLE-DEFLECTION TYPE.
3. RESTRAINED MOUNTS: ALL DIRECTIONAL MOUNTINGS WITH SEISMIC RESTRAINT; CAST-DUCTILE-IRON HOUSING.
4. SPRING ISOLATORS: FREESTANDING, LATERALLY STABLE, OPEN-SPRING TYPE.
5. RESTRAINED SPRING ISOLATORS: FREESTANDING, STEEL, OPEN-SPRING TYPE WITH SEISMIC RESTRAINT.
6. HOUSED SPRING MOUNTS: DUCTILE-IRON OR STEEL HOUSING, WITH INTEGRAL, VERTICALLY ADJUSTABLE SEISMIC SNUBBERS.
7. ELASTOMERIC HANGERS: DOUBLE-DEFLECTION TYPE.
8. SPRING HANGERS: COMBINATION COIL-SPRING AND ELASTOMERIC-INSERT HANGERS WITH SPRING AND INSERT IN COMPRESSION.
9. SPRING HANGERS WITH VERTICAL-LIMIT STOP: COMBINATION COIL-SPRING AND ELASTOMERIC-INSERT HANGERS WITH SPRING AND INSERT IN COMPRESSION AND WITH VERTICAL-LIMIT STOP.
10. PIPE RISER RESILIENT SUPPORT: ALL-DIRECTIONAL, ACOUSTICAL PIPE ANCHOR.
11. RESILIENT PIPE GUIDES.

B. AIR-MOUNTING SYSTEMS:

1. AIR MOUNTS: FREESTANDING, SINGLE OR MULTIPLE, COMPRESSED-AIR BELLOWS.
2. RESTRAINED AIR MOUNTS: HOUSED COMPRESSED-AIR BELLOWS.

C. RESTRAINED VIBRATION ISOLATION ROOF-CURB RAILS: FACTORY-ASSEMBLED, FULLY ENCLOSED, INSULATED, AIR- AND WATERTIGHT CURB RAIL; WITH SPRING ISOLATORS MOUNTED ON ELASTOMERIC ISOLATION PADS, AND SNUBBER BUSHINGS.

D. VIBRATION ISOLATION EQUIPMENT BASES:

1. STEEL BASE: FACTORY- FABRICATED, WELDED, STRUCTURAL-STEEL BASES AND RAILS.
2. INERTIA BASE: FACTORY- FABRICATED, WELDED, STRUCTURAL-STEEL BASES AND RAILS READY FOR FIELD-APPLIED, CAST-IN-PLACE CONCRETE

1.3 FIELD QUALITY CONTROL

A. TESTING: BY EITHER OWNER-ENGAGED AGENCY, CONTRACTOR-ENGAGED AGENCY, OR CONTRACTOR.

PART-2 PRODUCTS

1.4 VIBRATION ISOLATORS & SEISMIC-RESTRAINT DEVICES

A. AVAILABLE MANUFACTURERS: SUBJECT TO COMPLIANCE WITH REQUIREMENTS, MANUFACTURERS OFFERING PRODUCTS THAT MAY BE INCORPORATED INTO THE WORK INCLUDE, BUT ARE NOT LIMITED TO, THE FOLLOWING:

B. MANUFACTURERS: SUBJECT TO COMPLIANCE WITH REQUIREMENTS, PROVIDE PRODUCTS BY ONE OF THE FOLLOWING:

1. ACE MOUNTINGS CO., INC.
2. AMBER/BOOTH COMPANY, INC.
3. CALIFORNIA DYNAMICS CORPORATION.
4. COOPER B-LINE, INC.; A DIVISION OF COOPER INDUSTRIES.
5. HILTI, INC.
6. ISOLATION TECHNOLOGY, INC.
7. KINETICS NOISE CONTROL.

END OF SECTION 230548

SECTION 230593 - TESTING, ADJUSTING, AND BALANCING FOR HVAC

1.1 SUMMARY

A. TESTING, ADJUSTING, AND BALANCING FOR THE FOLLOWING:

1. MOTORS.
2. CONDENSING UNITS.
3. AIR SYSTEM: CONSTANT VOLUME

1.2 QUALITY ASSURANCE

A. THE CONTRACTOR SHALL PROCURE THE SERVICES OF A TESTING, ADJUSTING AND BALANCING (TAB) SPECIALIST WHO SPECIALIZES IN HEATING, VENTILATION AND AIR CONDITIONING SYSTEMS. THE TAB AGENT SHALL HAVE THE FOLLOWING QUALIFICATIONS: AABC, NEBB OR TABB CERTIFIED.

1.3 EXECUTION

A. THE TAB SPECIALIST SHALL PERFORM FLOW MEASUREMENTS OF ALL EXISTING AIR AND HYDRONIC SYSTEMS THAT ARE TO REMAIN OR TO BE INCORPORATED INTO NEW WORK PRIOR TO THE STARTING OF WORK IN THE PROJECT SCOPE. A REPORT OF THESE MEASUREMENTS, INDICATING ANY AND ALL DEFICIENCIES SHALL BE SUBMITTED FOR OWNER REVIEW.

B. THE TAB SPECIALIST SHALL PERFORM FLOW MEASUREMENTS OF ALL NEW AIR AND HYDRONIC SYSTEMS AS LISTED ABOVE IN THE PROJECT SCOPE. A REPORT OF THESE MEASUREMENTS, INDICATING ANY AND ALL DEFICIENCIES SHALL BE SUBMITTED FOR OWNER REVIEW.

C. THE REPORT SHALL INDICATE A SCHEMATIC DIAGRAM INDICATING LOCATIONS OF ALL EQUIPMENT TESTED AND MEASUREMENT LOCATIONS.

D. PRIOR TO FINAL INSPECTION OF THE WORK, THE TAB SPECIALIST SHALL BALANCE ALL SYSTEMS AS INDICATED ABOVE TO THE REQUIREMENTS OF THE DESIGN.

E. THE CONTRACTOR SHALL HAVE FURNISH AND INSTALL ALL ADDITIONAL BALANCING EQUIPMENT, PRESSURE TAPS, GAUGES AND OTHER EQUIPMENT AS REQUIRED FOR A PROPERLY BALANCED SYSTEM AT NO ADDITIONAL COST TO THE OWNER. SUCH ADDITIONAL EQUIPMENT SHALL ADHERE IN STRICT ACCORDANCE WITH THE RESPECTIVE EQUIPMENT MANUFACTURER'S RECOMMENDATIONS.

F. THE CONTRACTOR SHALL HAVE THE TESTING AND BALANCING SPECIALIST COORDINATE ALL WORK OF THIS S3ECTION WITH THE BUILDING MANAGER. BALANCING WORK SHALL NOT CONFLICT WITH OTHER WORK SO AS TO MAINTAIN COMPLETION WITHIN THE SPECIFIED TIME.

G. ALL INSTRUMENTS USED FOR TAB SHALL BE MAINTAINED IN GOOD WORKING CONDITION AND ACCURATELY CALIBRATED.

H. TOLERANCES: PLUS OR MINUS 5 PERCENT OF DESIGN VALUES.

I. INSPECTIONS: RANDOM CHECKS BY OWNER OR ARCHITECT TO VERIFY FINAL TESTING, ADJUSTING, AND BALANCING REPORT.

J. ADDITIONAL TESTS: RANDOM TESTS WITHIN 90 DAYS OF COMPLETING TAB TO VERIFY BALANCE CONDITIONS AND SEASONAL TESTS.

END OF SECTION 230593

SECTION 233713 - DIFFUSERS, REGISTERS, AND GRILLES

1.1 PRODUCTS

A. DIFFUSERS, REGISTERS AND GRILLES SHALL BE FURNISHED AND INSTALLED FOR CAPACITIES AND IN LOCATIONS INDICATED ON DRAWINGS. ALL REGISTERS AND DIFFUSERS SHALL BE PRIME COATED STEEL OR EXTRUDED ALUMINUM FINISHED UNLESS OTHERWISE NOTED IN BAKED WHITE ENAMEL.

B. MANUFACTURERS: TITUS

1. SUBJECT TO COMPLIANCE WITH REQUIREMENTS, PROVIDE PRODUCT BY ONE OF THE FOLLOWING:

a. HART & COOLEY INC.

b. KRUEGER.

c. METALAIRE, INC.

d. RUSKIN

C. ALL DIFFUSERS SHALL HAVE CONTROLLING/EQUALIZING GRID AND OPPOSED BLADE DAMPER UNLESS OTHERWISE NOTED.

D. ALL DUCTED RETURN REGISTERS SHALL HAVE AN OPPOSED BLADE DAMPER UNLESS OTHERWISE NOTED.

END OF SECTION 233713

SECTION 233113 - METAL DUCTS

1.1 CONSTRUCTION

A. EACH DUCT SYSTEM SHALL BE CONSTRUCTED FOR THE SPECIFIC SMACNA DUCT PRESSURE CLASSIFICATIONS SHOWN ON THE CONTRACT DRAWINGS. WHERE NO PRESSURE CLASSES ARE SPECIFIED BY THE DESIGNER, THE SMACNA 1 INCH WG PRESSURE, SEAL CLASS "A".

B. ALL DUCTWORK SHALL BE CONSTRUCTED TO SMACNA 1" WG DESIGN AND NOT LESS THAN THE FOLLOWING STANDARDS:

1. CONSTRUCT SO THAT ALL INTERIOR SURFACES ARE SMOOTH. USE SLIP AND DRIVE OR FLANGED AND BOLTED CONSTRUCTION WHEN FABRICATING RECTANGULAR DUCTWORK. USE SPIRAL LOCK SEAM CONSTRUCTION WHEN FABRICATING ROUND SPIRAL DUCTWORK. SHEET METAL SCREWS MAY BE USED ON DUCT HANGERS, TRANSVERSE JOINTS AND OTHER SMACNA APPROVED LOCATIONS IF THE SCREW DOES NOT EXTEND MORE THAN 1/2 INCH INTO THE DUCT.
2. SHEET STEEL SHALL COMPLY WITH ASTMA653 STANDARD SPECIFICATION FOR STEEL SHEET METAL, ZINC COATED (GALVANIZED) OR ZINC IRON ALLOY-COATED (GALVANNEALED) BY HOT DIP PROCESS, AND A924 STANDARD SPECIFICATION FOR GENERAL REQUIREMENT FOR SHEET METALLIC-COATED BY HOT DIP PROCESS. ALL ANGLE IRON USED FOR SUPPORT SHALL BE GALVANIZED. CONNECTIONS TO WALLS OR FLOOR SHALL BE AIR TIGHT WITH ANGLE IRON AND CAULKING. SEAL ALL DUCT SEAMS, TRANSVERSE AND LONGITUDINAL, AIR TIGHT. PROVIDE TURNING VANES ALL 90° ELBOWS.
3. USE ELBOWS AND TEES WITH A CENTER LINE RADIUS TO WIDTH OR DIAMETER RATIO OF 1.5 WHEREVER SPACE PERMITS. WHEN A SHORTER RADIUS MUST BE USED DUE TO LIMITED SPACE, INSTALL SINGLE WALL SHEET METAL SPLITTER VANES IN ACCORDANCE WITH SMACNA PUBLICATIONS, TYPE RE 3. WHERE SPACE WILL NOT ALLOW AND THE C VALUE OF THE RADIUS ELBOW, AS GIVEN IN SMACNA PUBLICATIONS, EXCEEDS 0.31, USE RECTANGULAR ELBOWS WITH TURNING VANES AS SPECIFIED IN SECTION 23 33 00. SQUARE THROAT-RADIUS HEEL ELBOWS WILL NOT BE ACCEPTABLE. STRAIGHT TAPS OR BULLHEAD TEES ARE NOT ACCEPTABLE.
4. WHERE RECTANGULAR ELBOWS ARE USED, PROVIDE TURNING VANES IN ACCORDANCE WITH SECTION 23 33 00.
5. PROVIDE EXPANDED TAKE-OFFS OR 45 DEGREE ENTRY FITTINGS FOR BRANCH DUCT CONNECTIONS WITH BRANCH DUCTWORK AIRFLOW VELOCITIES GREATER THAN 700 FPM. SQUARE EDGE 90-DEGREE TAKE-OFF FITTINGS OR TRAIGHT TAPS WILL NOT BE ACCEPTED.
6. BUTTON PUNCH SNAP-LOCK CONSTRUCTION WILL NOT BE ACCEPTED ON ALUMINUM DUCTWORK.

C. WHERE LATEST EDITION OF SMACNA DOES NOT CLEARLY STATE GAUGES AND/OR STIFFENERS TO BE USED OR, WHERE SMACNA STANDARDS REQUIRE INTERPRETATION, THE FOLLOWING MINIMUM METAL GAUGES AND BRACING SHALL BE USED:

SUPPORT SCHEDULE - DUCTWORK

USG	MAX SIDE INCHES	TRANSVERSE JOINT AND BRACING
22	UP TO 12	S SLIP, DRIVE, ONE INCH POCKET ON 8 FOOT
22	13 TO 24	1"X1"X1/8" ANGLES ON 4 FOOT CENTERS
20	25 TO 35	1"X1"X1/8" ANGLES ON 2 FOOT CENTERS

D. PROVIDE TAPPING IN DUCTS FOR THERMOMETERS WHERE SPECIFIED IN ADDITION, PROVIDE AN AIRTIGHT PLUGGED TAPPING LOCATED AS FOLLOWS:

1. UPSTREAM OF EACH REHEAT COIL AND VAV BOX.
2. DOWNSTREAM OF EACH REHEAT COIL AND VAV BOX.

E. FLAT OVAL OR ROUND DUCTWORK MAY BE PROVIDED IN LIEU OF RECTANGULAR DUCTWORK WITH THE REINFORCEMENT FOR FLAT SIDES SAME AS SPECIFIED FOR THE RECTANGULAR DUCTWORK, AND AS PER SMACNA FLAT OVAL DUCT CONSTRUCTION STANDARDS

F. ALL DUCTWORK SHALL BE SEALED TO CLASS "A" AND LEAK TESTED TO MEAT SMACNA CLASS 6 FOR RECTANGULAR AND CLASS 3 FOR ROUND DUCTS.

1.2 MATERIALS

A. SINGLE-WALL RECTANGULAR DUCTS AND FITTINGS.

B. SINGLE-WALL ROUND AND FLAT-OVAL DUCTS AND FITTINGS.

C. SHEET METAL MATERIALS:

1. GALVANIZED SHEET STEEL.
2. STAINLESS-STEEL SHEETS.
3. ALUMINUM SHEETS.
4. FACTORY-APPLIED ANTI-MICROBIAL COATING.

D. DUCT LINER:

1. FIBROUS GLASS, TYPE 1, FLEXIBLE WITH ANTI-MICROBIAL EROSION-RESISTANT COATING.
2. FLEXIBLE ELASTOMERIC.
3. NATURAL FIBER.

E. SEALANT MATERIALS:

3. TWO-PART TAPE SEALING SYSTEM.
4. WATER-BASED JOINT AND SEAM SEALANT.
5. SOLVENT-BASED JOINT AND SEAM SEALANT.
6. FLANGED JOINT SEALANT.
7. FLANGE GASKETS.
8. ROUND DUCT JOINT O-RING SEALS.

1.3 DUCT CLEANING

A. CLEAN EXISTING DUCT SYSTEM(S) BEFORE TESTING, ADJUSTING, AND BALANCING.

B. CLEAN THE FOLLOWING ITEMS:

1. AIR OUTLETS AND INLETS.
2. SUPPLY, RETURN, AND EXHAUST FANS.
3. AIR-HANDLING UNITS.
4. COILS AND RELATED COMPONENTS.
5. RETURN-AIR DUCTS, DAMPERS, ACTUATORS, AND TURNING VANES.
6. SUPPLY-AIR DUCTS, DAMPERS, ACTUATORS, AND TURNING VANES.
7. DEDICATED EXHAUST AND VENTILATION COMPONENTS AND MAKEUP AIR SYSTEMS.

1.4 DUCT SCHEDULE

A. ALL DUCTS SHALL BE GALVANIZED STEEL EXCEPT AS FOLLOWS:

1. MOIST ENVIRONMENT DUCT MATERIAL: ALUMINUM.

END OF SECTION 233113

SECTION 230713 - INSULATION

INSULATION - GENERAL REQUIREMENTS

A. ALL INSULATION MATERIALS, INCLUDING JACKETS, FACING, ADHESIVE, COATINGS, AND ACCESSORIES ARE TO BE FIRE HAZARD RATED AND LISTED BY UNDERWRITERS LABORATORIES, INC. USING STEINER TUNNEL TEST METHOD FOR FIRE HAZARD CLASSIFICATION OF BUILDING MATERIALS, STANDARD UL 723 (ASTM E-84), (ASA A2.5-1963). FLAMESPREAD: MAXIMUM 25. FUEL CONTRIBUTED AND SMOKE DEVELOPED: MAXIMUM 50. FLAMEPROOFING TREATMENTS SUBJECT TO DETERIORATION FROM MOISTURE OR HUMIDITY ARE NOT ACCEPTABLE.

B. DEFINITIONS:

1) EXPOSED: INDOOR DUCTS, PIPING OR EQUIPMENT LOCATED IN MECHANICAL EQUIPMENT ROOMS AND IN AREAS WHICH WILL BE VISIBLE WITHOUT REMOVING CEILINGS OR OPENING ACCESS PANELS.

2) CONCEALED: INDOOR DUCTS, PIPING OR EQUIPMENT WHICH IS NOT EXPOSED.

3) OUTDOOR: DUCTS, PIPING OR EQUIPMENT WHICH IS EXPOSED TO THE WEATHER.

DUCTWORK INSULATION

A. INSULATE ALL DUCTWORK IN ACCORDANCE WITH INSULATION SCHEDULE EXCEPT AS OTHERWISE NOTED.

INSULATION SCHEDULE - DUCTWORK

SERVICE	LOCATION	R-VALUE	TYPE	FINISH
SUPPLY/RETURN	CONCEALED	R-6	D-1	VAPORSEAL
SUPPLY/RETURN	EXPOSED	R-12	D-1	VAPORSEAL
INTAKE	ALL	R-12	D-1	VAPORSEAL
SUPPLY	EXTERIOR	R-12	D-1	VAPORSEAL

B. REINSULATE ALL DUCTWORK AND PIPING WHICH IS EXISTING TO REMAIN AND WAS DAMAGED DURING CONSTRUCTION OR SHOWN OR REQUIRED TO BE RELOCATED. INSULATE WITH SAME MATERIAL AND THICKNESS.

C. NON-INSULATED DUCTWORK:

1) WHERE SOUND LINING IS OF MINIMUM THICKNESS SPECIFIED FOR INSULATION.

2) AIR CONDITIONING RETURN AIR DUCTWORK EXPOSED IN AIR CONDITIONED SPACES AND INSTALLED IN HUNG CEILINGS WHERE SPACE IMMEDIATELY ABOVE AND BELOW ARE BOTH AIR CONDITIONED.MATERIAL:

D. MATERIAL:

1) TYPE D-1: MINIMUM 1-LB DENSITY FIBERGLASS BLANKET, MAXIMUM 0.28 K-FACTOR AT 75 ADEG F MEAN TEMPERATURE WITH FACTORY-APPLIED FOIL-SKRIM-KRAFT FACING SIMILAR TO MANVILLE MICROLITE.

2) TYPE D-2: 3 LB. FIBERGLASS BOARD. THE MAXIMUM K FACTOR SHALL BE 0.23 AT 75 DEG F MEAN TEMPERATURE WITH A MINIMUM DENSITY OF 3 LB. THE INSULATION
SHALL BE PROVIDED WITH A FACTORY-APPLIED ALL PURPOSE OR ALL SERVICE FACING. THE INSULATION SHALL BE EQUAL TO MANVILLE TYPE 814 SPIN-GLAS AP.

3) TYPE D-3: MINIMUM 6 LB FIBERGLASS BOARD. MAXIMUM 0.22 K-FACTOR AT 75 DEG F MEAN TEMPERATURE WITH FACTORY APPLIED ALL PURPOSE OR ALL SERVICE FACING. SIMILAR TO MANVILLE 817 SPIN-GLAS AP

E. FINISH:

1) TYPE F-1: FITTING COVER, MOLDED WHITE PVC JACKET, UL CLASS 1, MAXIMUM PERMEANCE 0.05 SIMILAR TO MANVILLE ZESTRON.

2) TYPE F-2: WHITE VAPOR BARRIER COATING WITH 10X10 OR 20X20 MESH WHITE GLASS, POLYESTER OR NYLON CLOTH REINFORCING MEMBRANE, MINIMUM 31 MIL DRY FILM THICKNESS, SIMILAR TO FOSTER TITE-FIT, UL LABEL.

3) TYPE F-4: ALUMINUM JACKETING WITH MINIMUM 0.016 IN. WALL THICKNESS AND LONGITUDINAL JOINTS WITH LOCK SEAMS.

4) TYPE F-6: WHITE FINISHING AND INSULATING CEMENT APPLIED OVER HEXAGONAL WIRE MESH. CEMENT SIMILAR TO KEENE SUPERSLICK.

F. INSTALLATION:

a. FIBERGLASS BLANKET: 2 IN. LAP STRIPS AT ALL SEAMS. SECURE BOTTOM OF ALL DUCTS OVER 24 IN. WIDE WITH MIN 2 ROWS OF WELD PINS 12 IN. ON CENTER. SECURE ALL SEAMS WITH FOIL VAPOR BARRIER TAPE AND VAPORSEAL ADHESIVE.

b. FIBERGLASS BOARD: SEAL JOINTS AND BREAKS IN FACING WITH 3 IN. WIDE TAPE TO MATCH FACING AND ADHERE WITH VAPOR SEAL ADHESIVE. APPLY 5 IN. WIDE TAPE AT CORNERS, WELD PINS ON TOP, SIDES AND BOTTOM.

G. ACOUSTICAL TREATMENT

PROVIDE ACOUSTICAL LINER FOR FIRST 10 FEET OF BOTH SUPPLY AND RETURN DUCTWORK, LOW PRESSURE DUCTWORK SHALL BE LINED WITH 1.5" THICK R-6 AS MANUFACTURED BY DUCTMATE, 1-1/2 POUND MINIMUM DENSITY, NEOPRENE COATED, FLEXIBLE FIBERGLASS DUCT LINER. LINING SHALL COMPLY WITH NFPA 90A AND SHALL HAVE A FLAME SPREAD CLASSIFICATION OF NOT MORE THAN 25 AND A SMOKE DEVELOPED RATING NOT MORE THAN 50. DUCT SIZES WHERE LINING IS INDICATED ON PLANS ARE MINIMUM INSIDE CLEAR DIMENSIONS REQUIRED,

Property of MY Engineers

PROJECT:
REDLINE ATHLETICS - FLEMINGTON NJ

DRAWING TITLE:
MECHANICAL SPECIFICATIONS

SHEET:
M-002

GENERAL NOTES:

A. CONTRACTOR SHALL BALANCE EACH DEVICE WITH THE CFM SHOWN ON PLAN.

B. NEW DUCTWORK SHOWN ON PLAN ARE SCHEMATIC ONLY. CONTRACTOR SHALL COORDINATE WITH OTHER TRADES FOR PIPING AND DUCTWORK ROUTING. OFFEST AND RUN PIPING, DUCTWORK INSIDE THE STRUCTURE IF REQUIRED. PROVIDE ANY EXTRA PIPING, DUCTWORK, FITTINGS, INSULATIONS AND OTHER ACCESSORIES IN ORDER TO COMPLETE THE INSTALLATION.

C. COORDINATE LOCATIONS AND SIZES OF INTAKE & EXHAUST OPENINGS WITH OWNER AND RESPECTIVE ENGINEER.

D. EQUIPMENT SIZES, DIMENSIONS AND REQUIRED CONNECTIONS SHALL BE VERIFIED WITH THE ACTUAL EQUIPMENT SELECTED VENDOR DRAWINGS BEFORE FABRICATION OF DUCTWORK, PIPING ETC.

E. DUCT SIZES SHOWN ON PLANS ARE CLEAR INSIDE AIR STREAM DIMENSIONS.

F. CONTRACTOR SHALL COORDINATE ALL ELECTRICAL REQUIREMENTS FOR ALL HVAC BASED ON ACTUAL EQUIPMENT SELECTED PRIOR TO INSTALLATION.

G. CONTRACTOR SHALL COORDINATE EQUIPMENT WEIGHTS AND SUPPORTS BASED ON ACTUAL EQUIPMENT SELECTED.

H. COORDINATE WITH ALL TRADES FOR MATERIALS IN RATED AND PLENUM SPACES.

I. NEW DUCTWORK IN CONCEALED AREAS MAY BE RECTANGULAR WITH EQUIVALENT CROSS SECTIONAL FLOW AREA.

J. PROVIDE INTERNAL INSULATION FOR ALL EXPOSED DUCTWORK AND EXTERNAL FOR ALL DUCTWORK IN CONCEALED AREAS.

K. PROVIDE FIRE OR FIRE+SMOKE DAMPER WHEREVER DUCTS ARE CROSSING FIRE/SMOKE RATED WALLS/BARRIERS. COORDINATE WITH ARCHITECTURAL DRAWINGS FOR FIRE RATINGS OF THE WALLS.

L. ARCHITECTURAL LAYOUT AND DIMENSIONS FOR EQUIPMENT TO TAKE PRECEDENCE OVER MEP.

M. LIMIT FLEXIBLE DUCT LENGTH TO 5 LINEAR FEET. MAKE SURE DUCT IS FULLY STRETCHED OUT WITH NO KINKS & SHARP BENDS.

N. PROVIDE CORD OPERATED DAMPER IN INACCESSIBLE CEILING.

O. ACOUSTICALLY LINE THE FIRST 10'-0" OF BOTH SUPPLY AND RETURN DUCTS.

P. THE ENTIRE INSTALLATION SHALL BE GUARANTEED FREE OF DEFECTS AND CONTRACTOR SHALL REPAIR AND / OR REPLACE ANY DEFECTIVE MATERIALS OR EQUIPMENT AT NO COST TO THE OWNER FOR A MINIMUM PERIOD OF ONE YEAR FROM THE DATE OF ACCEPTANCE BY ARCHITECT OR ENGINEER.

Q. ALL WORK SHALL BE SUBJECT TO THE ACCEPTANCE AND APPROVAL OF THE ARCHITECT AND OWNER. THE ARCHITECT SHALL BE NOTIFIED OF ANY AND ALL DISCREPANCIES BETWEEN FIELD CONDITIONS AND THE CONTRACT DOCUMENTS BEFORE PROCEEDING WITH THAT PORTION OF THE WORK. FAILURE OF PROPER NOTIFICATION DOES NOT RELIEVE THE CONTRACTOR. THE CONTRACTOR SHALL CORRECT ANY AND ALL WORK ARISING FROM SUCH FAILURE TO COORDINATE DISCREPANCIES TO THE SATISFACTION OF THE ARCHITECT WITHOUT ADDITIONAL COST TO THE OWNER.

R. THE CONTRACTOR SHALL, UPON COMPLETION OF PROJECT, PERFORM A COMPLETE TEST AND BALANCE OF ALL EQUIPMENT. PROVIDE A WRITTEN REPORT TO THE ARCHITECT. ALL CAPACITIES MUST BE SET TO WITHIN ±10% OF AMOUNTS INDICATED ON THE FLOOR PLAN AND SCHEDULES.


S. COORDINATE ALL EQUIPMENT WITH STRUCTURAL DRAWING.

T. MAINTAIN ALL CODE AND MANUFACTURERS RECOMMENDED CLEARANCE AROUND ALL ROOF EQUIPMENT.

U. ALL SOURCE OF MECHANICAL INTAKE SHALL MAINTAIN 10 FEET SEPARATION BETWEEN ANY SOURCE OF EXHAUST. CONTRACTOR IS RESPONSIBLE TO ADJUST DUCT LENGTH AS NEEDED.

KEY NOTES: (#)

1. LOCATION OF DIGITAL THERMOSTAT CONTROL. INSTALL AND WIRE NEW 7-DAY PROGRAMMABLE THERMOSTAT. COORDINATE EXACT LOCATION WITH ARCHITECT AND OWNER PRIOR TO ROUGH-IN. PROVIDE LOCKABLE COVER.
2. CONNECT 1-1/4" CD FROM UNIT TO NEAREST PLUMBING DRAIN WITH AIR GAP FITTING. INSTALL CONDENSATE DRAIN WITH 1% TOWARD DRAIN. PROVIDE CONDENSATE PUMP AS/IF REQUIRED.
3. INSTALL REFRIGERANT PIPING BETWEEN INDOOR AND OUTDOOR UNIT AS PER MANUFACTURERS RECOMMENDATIONS. PROVIDE INSULATION TO REF PIPING AS PER ENERGY CONSERVATION CODE. COORDINATE WITH BASE BUILDING ENGINEER FOR PIPE ROUTING AND RISER LOCATION. NOTIFY THE ENGINEER OF ANY DISCREPANCY BEFORE COMMENCING BID.
4. MD TO INTERLOCK WITH RESPECTIVE UNITS.
5. INSTALL CONDENSING UNIT ON THE ROOF AS PER MANUFACTURER RECOMMENDATION WITH ALL REQUIRED ACCESSORIES. COORDINATE FINAL LOCATION OF EQUIPMENTS WITH LL.
6. CEILING MOUNTED EXHAUST FAN. FAN SHALL BE SUSPENDED FROM STRUCTURE ABOVE VERIFY EXACT LOCATION OF STRUCTURE MEMBER PRIOR TO INSTALLATION.
7. INSTALL INLINE FAN AS PER MANUFACTURE RECOMMENDATION. FAN SHALL BE SUSPENDED FROM STRUCTURE ABOVE VERIFY EXACT LOCATION OF STRUCTURE MEMBER PRIOR TO INSTALLATION.
8. CONTRACTOR TO INSTALL LOUVER WITH MINIMUM 50% FREE AREA. CONTRACTOR TO USE THE EXISTING WINDOW OPENING FOR LOUVER. FIELD VERIFY THE EXACT LOCATION. COORDINATE WITH ARCHITECT FOR DESIGN, TYPE, COLOR AND FINISH.
9. CONTRACTOR TO CONNECT OUTSIDE AIR DUCT TO EXISTING INSTALLED EXTERIOR WALL PENETRATION. FIELD VERIFY THE EXACT LOCATION.
10. CONTRACTOR TO CONNECT EXHAUST AIR DUCT TO EXISTING INSTALLED EXTERIOR WALL PENETRATION. FIELD VERIFY THE EXACT LOCATION.
11. EXHAUST TERMINATION SHALL TERMINATE 10 FEET FROM PROPERTY/ LOT LINE, 3 FEET AWAY FROM ANY OPERABLE OPENING INTO THE BUILDING AND 10 FEET AWAY FROM ANY OUTSIDE AIR INTAKES.
12. OUTSIDE AIR INTAKE SHALL TERMINATE 10 FEET FROM PROPERTY/ LOT LINE, AND 10 FEET AWAY FROM ANY EXHAUST SOURCES.
13. EXISTING GAS UNIT HEATER TO REMAIN AS IT IS ALONG WITH ALL ACCESSORIES.
14.
15. CONTRACTOR TO INSTALL ECLECTIC DUCT HEATER AS PER MANUFACTURER RECOMMENDATION WITH ALL REQUIRED ACCESSORIES. INTERLOCK DUCT HEATER WITH OAF-1.
16. CONTRACTOR TO INSTALL ECLECTIC UNIT HEATER AS PER MANUFACTURER RECOMMENDATION WITH ALL REQUIRED ACCESSORIES.
17. PROVIDE 12"X6" DOOR TRANSFER GRILLE.

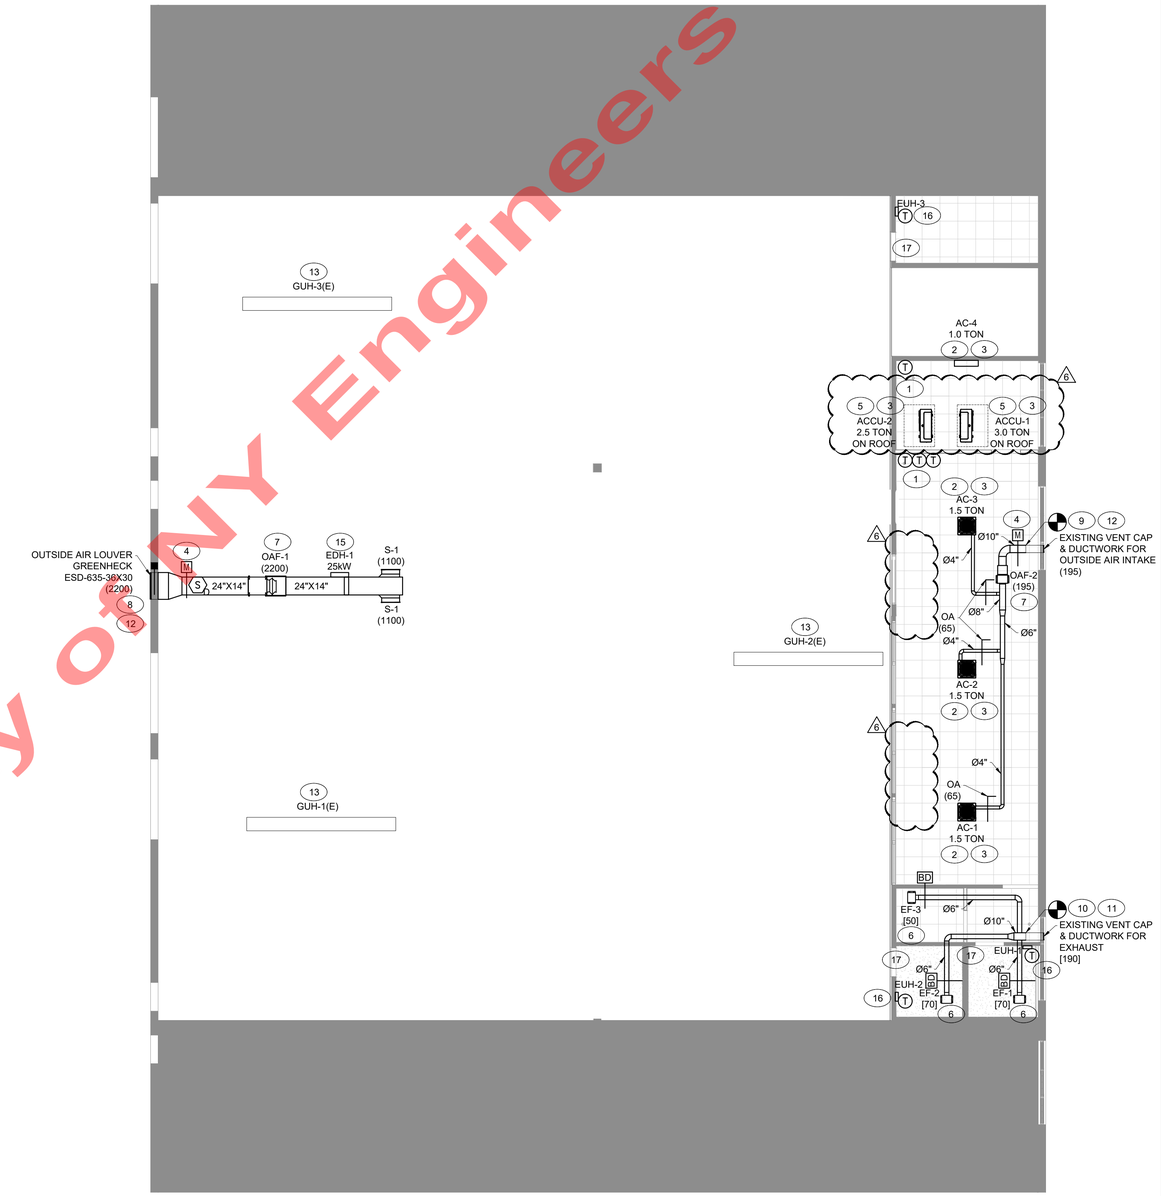


1 MECHANICAL FLOOR PLAN
SCALE: 1/8" = 1'-0"

Property of NY Engineers

PROJECT:
REDLINE ATHLETICS - FLEMINGTON NJ

DRAWING TITLE:
MECHANICAL FLOOR PLAN

SHEET:
M-101

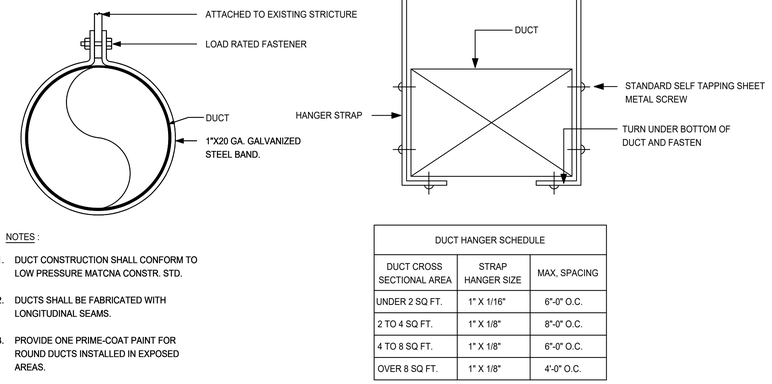


NOTES :


1. DUCT CONSTRUCTION SHALL CONFORM TO LOW PRESSURE MATCNA CONSTR. STD.
2. DUCTS SHALL BE FABRICATED WITH LONGITUDINAL SEAMS.
3. PROVIDE ONE PRIME-COAT PAINT FOR ROUND DUCTS INSTALLED IN EXPOSED AREAS.

DUCT HANGER SCHEDULE		
DUCT CROSS SECTIONAL AREA	STRAP HANGER SIZE	MAX. SPACING
UNDER 2 SQ FT.	1" X 1/16"	6'-0" O.C.
2 TO 4 SQ FT.	1" X 1/8"	8'-0" O.C.
4 TO 8 SQ FT.	1" X 1/8"	6'-0" O.C.
OVER 8 SQ FT.	1" X 1/8"	4'-0" O.C.


1 DUCT WORK HANGING DETAIL
N.T.S.

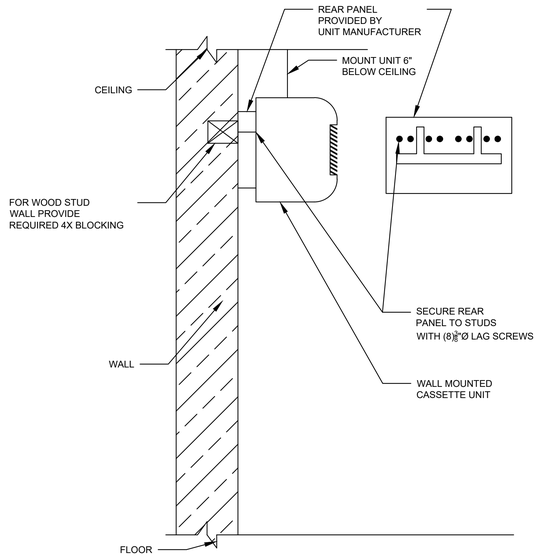

2 WALL MOUNTED UNIT INSTALLATION DETAIL
N.T.S.

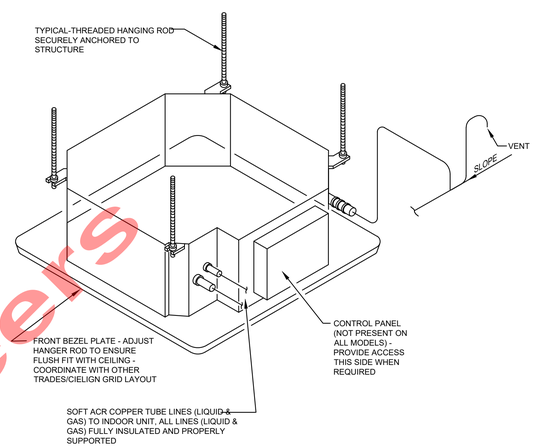


3 CASSETTE UNIT INSTALLATION DETAIL
N.T.S.

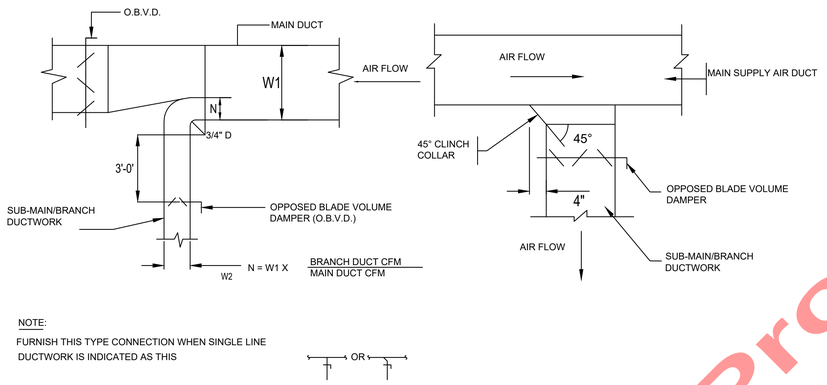


NOTE:
FURNISH THIS TYPE CONNECTION WHEN SINGLE LINE DUCTWORK IS INDICATED AS THIS

OR

4 SUPPLY AIR DUCTWORK SUB-MAIN BRANCH DUCT CONNECTION
N.T.S.

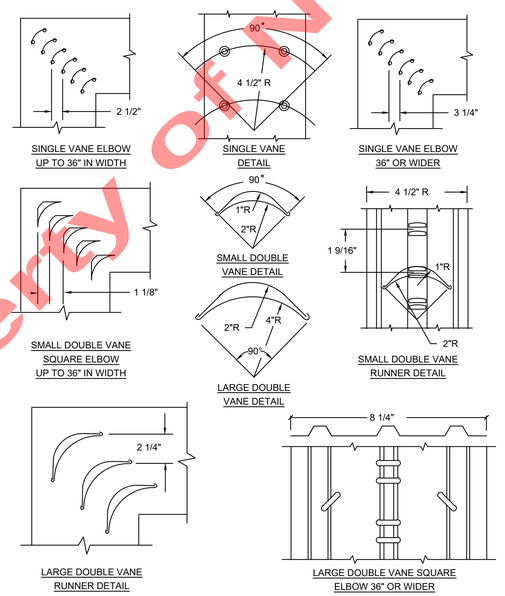

5 LOW VELOCITY DUCTWORK ELBOWS
N.T.S.

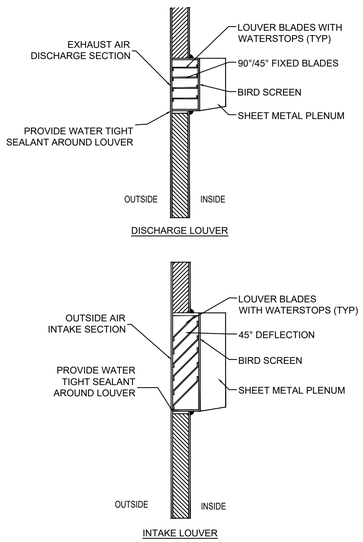


6 LOUVER INSTALLATION DETAIL
N.T.S.

Property of NY Engineers

PROJECT:
REDLINE ATHLETICS - FLEMINGTON NJ

DRAWING TITLE:
MECHANICAL DETAILS (1 OF 2)

SHEET:
M-201

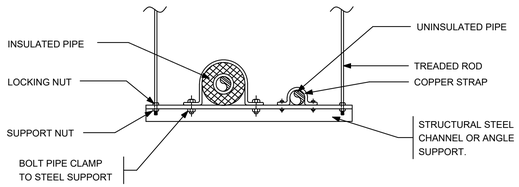


TYPICAL TRAPEZE HANGER SUPPORT

PIPE HANGER ROD AND SPACING SCHEDULE


NOMINAL PIPE OR TUBE SIZE - INCHES	5/8	3/4	7/8	1	1 1/2	2	2 1/2
HANGER ROD SIZES INCHES	3/8	3/8	3/8	3/8	3/8	3/8	3/8
MAX. SPACING BETWEEN PIPE SUPPORTS - FEET	-	6	-	7	9	10	11
MAX. SPACING BETWEEN CU. TUBE SUPPORTS-FT.	6	6	6	6	8	9	10

NOTES : TRAPEZE HANGER SPACING SHALL BE BASED ON SPACING OF SMALLEST PIPE ON TRAPEZE. TRAPEZE SHALL BE DESIGNED WITH A FACTOR OF SAFETY OF 5 FOR CENTER OF SPAN CONCENTRATED LOAD.

1 REF. PIPE SUPPORT DETAIL
N.T.S.

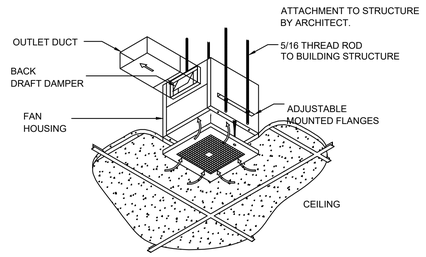


2 CEILING MOUNTED EXHAUST FAN DETAIL
N.T.S.

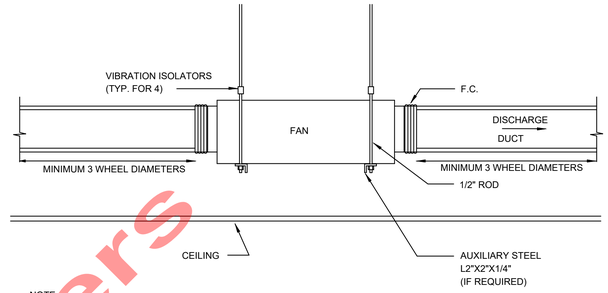

NOTE:
1. DUCT LENGTH TO BE MINIMUM THREE WHEEL DIAMETER ON DISCHARGE AND INLET.


3 INLINE FAN DETAIL
N.T.S.

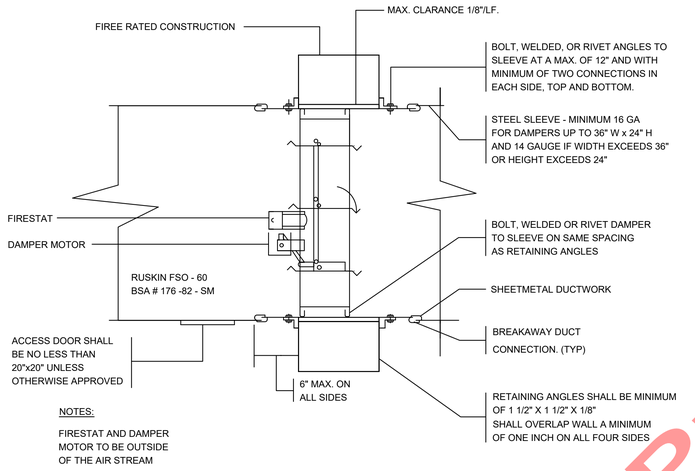

NOTES:

FIRESTAT AND DAMPER MOTOR TO BE OUTSIDE OF THE AIR STREAM

4 FIRE AND SMOKE DAMPER DETAIL
N.T.S.

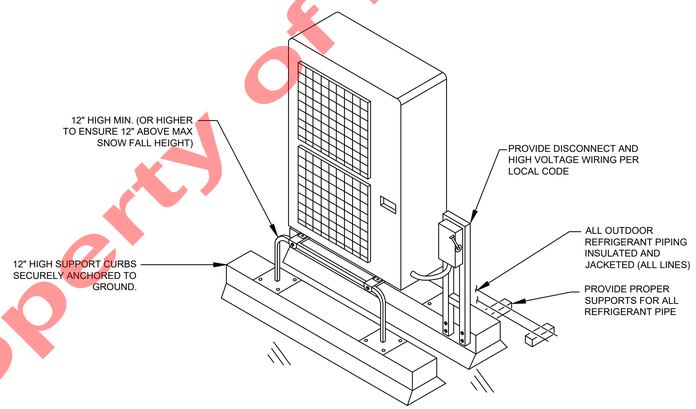

5 OUTDOOR UNIT INSTALLATION DETAIL
N.T.S.

Property of NY Engineers

PROJECT:
REDLINE ATHLETICS - FLEMINGTON NJ

DRAWING TITLE:
MECHANICAL DETAILS (2 OF 2)

SHEET:
M-202

AC UNIT SCHEDULE

UNIT ID	MANUFACTURER	MODEL NO.	LOCATION	AREA SERVED	TYPE	CAP. (TON)	COOLING MBH	HEATING MBH	TOTAL SUPPLY CFM	OUTSIDE AIR CFM	ELECTRICAL DATA		DIMENSIONS (HXWXD) (INCH)	PIPE SIZE (INCH)			WEIGHT (LBS.)
											VOLT/HZ/PH	RATED AMPS	UNIT	LIQ.	SUCTION	DRAIN (ID)	
AC-1	LG OR EQUIVALENT	KNUDB121A	SEE ON PLAN	SEE PLAN	CASSETTE	1.5	18.0	20.8	459	-	UNIT POWERED BY OUTDOOR		11X24X24	1/4"	1/2"	1"	38
AC-2	LG OR EQUIVALENT	KNUDB181A	SEE ON PLAN	SEE PLAN	CASSETTE	1.5	18.0	20.8	459	-	UNIT POWERED BY OUTDOOR		11X24X24	1/4"	1/2"	1"	38
AC-3	LG OR EQUIVALENT	KNUDB181A	SEE ON PLAN	SEE PLAN	CASSETTE	1.5	18.0	20.8	459	-	UNIT POWERED BY OUTDOOR		11X24X24	1/4"	1/2"	1"	38
AC-4	LG OR EQUIVALENT	KNUAB121A	SEE ON PLAN	SEE PLAN	WALL MOUNTED	1.0	12.0	13.6	282	-	UNIT POWERED BY OUTDOOR		12X32X8	1/4"	3/8"	5/8"	20

NOTES:-

1. REFRIGERANT R32 SHALL BE PROVIDED.
2. PROVIDE MOUNTING BRACKETS AND ALL ASSOCIATED ACCESSORIES.
3. ALL REFRIGERANT PIPING TO BE SIZED PER MANUFACTURERS RECOMMENDATIONS.
4. CONTRACTOR SHALL ALL CONTROL AND POWER WIRING FROM OUTOOR UNIT TO INDOOR UNIT, WIRE SHALL BE SIZED AS PER MANUFACTURER RECOMMENDATIONS.
5. CONTRACTOR SHALL PROVIDE A LONG LINE SET FOR REFRIGERANT PIPING IN THE EVENT THAT TOTAL REFRIGERANT LENGTH EXCEEDS THE MANUFACTURER'S STANDARD RECOMMENDED LENGTH.
6. ALL CEILING MOUNTED AC TO BE INSTALLED WITH VIBRATION ISOLATOR (RESILENTLY SUPPORTED) TO MINIMIZE SOUND AND VIBRATION TO SPACE.

AIR COOLED CONDENSING UNIT SCHEDULE

UNIT ID	MANUFACTURER	MODEL NO.	LOCATION	INDOOR UNIT SERVED	CAP. (TON)	COOLING MBH	HEATING MBH	ELECTRICAL DATA			PIPE SIZE (INCH)		DIMENSIONS (HXWXD) (IN.)	WEIGHT (LBS)	EER2/ SEER2	HSPF2
								VOLT/PH/HZ	MCA (A)	MOP (A)	LIQ.	SUCTION				
ACCU-1	LG OR EQUIVALENT	KUMXB361A	SEE PLAN	AC-1 & AC-2	3.0	32.8	36.0	208-230/1/60	19	25	1/4"X4	3/8"X4	33X38X16	140	12.5/21.5	9.5
ACCU-2	LG OR EQUIVALENT	KUMXB301A	SEE PLAN	AC-3 & AC-4	2.5	30.0	32.0	208-230/1/60	19	25	1/4"X4	3/8"X4	33X38X16	140	13.0/22.0	9.5

NOTES:-

1. UNIT SHALL HAVE TEN YEAR EXTENDED WARRANTY FOR COMPRESSORS/PARTS.
2. PROVIDE LOW AMBIENT CONTROL FOR CONDENSING UNIT OPERATION DOWN TO -4°F.
3. PROVIDE COMPRESSOR CYCLE PROTECTOR.
4. STEEL RAILS SUPPORT TO BE PROVIDED BY MECHANICAL CONTACTOR.
5. CONTRACTOR SHALL PROVIDE A LONG LINE SET FOR REFRIGERANT PIPING IN THE EVENT THAT TOTAL REFRIGERANT LENGTH EXCEED THE MANUFACTURER'S STANDARD RECOMMENDED LENGTH.
6. UNIT TO BE MOUNTED OFF THE GROUND WITH VIBRATION ISOLATION.
7. OUTDOOR REFRIGERANT LINESETS TO BE WRAPPED IN UV RESISTANT , FIRE RATED, AND ANTI MICROBIAL INSULATION PROTECTION BASED ON AIREX-FLEX GUARD OR EQUAL.
8. OUTDOOR HEAT PUMPS TO BE LOCATED WITH PROPER CLEARANCES AND MUST PREVENT RE-CIRCULATION OF AIR. COORDINATE WITH MANUFACTURER AND ARCHITECT.
9. REFRIGERANT R32 SHALL BE PROVIDED.
10. CONTRACTOR SHALL ALL CONTROL AND POWER WIRING FROM OUTOOR UNIT TO INDOOR UNIT, WIRE SHALL BE SIZED AS PER MANUFACTURER RECOMMENDATIONS.

UNIT HEATER SCHEDULE

TAG	MANUFACTURER	MODEL	HEATING INPUT (MBH)	HEATING OUTPUT (MBH)	THERMAL EFF. (%)	kW	ELECTRICAL DATA	
							V/PH/Hz	CURRENT RATING (A)
GUH-1(E)	SPACE-RAY & V.I.F.	LTU 100 & V.I.F.	100 & V.I.F.	V.I.F.	S.A.E.	-	120/1/60 & V.I.F.	2.6 & V.I.F.
GUH-2(E)	SPACE-RAY & V.I.F.	LTU 100 & V.I.F.	101 & V.I.F.	V.I.F.	S.A.E.	-	120/1/60 & V.I.F.	2.6 & V.I.F.
GUH-3(E)	SPACE-RAY & V.I.F.	LTU 100 & V.I.F.	102 & V.I.F.	V.I.F.	S.A.E.	-	120/1/60 & V.I.F.	2.6 & V.I.F.
EUH-1	QMARK	CWH1208DSF	-	-	-	1	208/1/60	4.8
EUH-2	QMARK	CWH1208DSF	-	-	-	1	208/1/60	4.8
EUH-3	QMARK	CWH1208DSF	-	-	-	1	208/1/60	4.8

NOTES FOR EXISTING HEATER:

1. INFRARED UNIT TUBE HEATER TO REMIAN AS IT IS ALONG WITH ALL ACCESSORIES.
2. S.A.E. = SAME AS EXISTING, V.I.F. = VARIFY IN FIELD.

NOTES / ACCESSORIES FOR NEW HEATER:

1. PROVIDE DISCONNECTION SWITCH.
2. "HEATER ON" PILOT LIGHT.
3. THREE-POSITION SELECTOR SWITCH (HEATER-STANDBY-FAN)
4. BUILT-IN THERMOSTAT 40F TO 85 F RANGE.
5. ALL UNIT HEATERS SHALL BE INSTALLED IN ACCORDANCE WITH THE LISTING AND MANUFACTURER'S INSTALLATION INSTRUCTIONS.

ELECTRIC DUCT HEATER SCHEDULE

UNIT ID	MANUFACTURER	MODEL	HEATER TYPE	LOCATION	CFM	DUCT HEATER DIMENSIONS (IN)			ELECTRICAL DATA				
						W	H	D	kW	V	PH	Hz	Amps (A)
EDH-1	GREENHECK	IDHE	SLIP IN	SEE PLAN	2200	24	14	6	25.0	460	3	60	31.41

NOTES / ACCESSORIES:

1. INSTALL ELECTRIC DUCT HEATER AS PER MANUFACTUR'S RECOMMENADATION.
2. PROVIDE T-STAT AND WIRE TO DUCT HEATER.
3. PROVIDE DISCONNECT SWTICH, VAPOR BARRIER, DUST TIGHT BOX AND FAN INTERLOCK SWITCH.
4. PROVIDE DUCT HEATER WITH SCR CONTROL AND THERMOSTAT.

OUTDOOR AIR VENTILATION SCHEDULE (IMC 2021) CONSTANT VOLUME SYSTEM

ROOM	OCCUPANCY DESCRIPTION	OCCUPANT DENSITY (#/1000 SQFT.)	Az	Pz	Rp	Ra	Ez	CODE TOTAL EXHAUST (CFM)	EXHAUST SPECIFIED ON DRAWINGS	Voz=(Rp*Pz+Ra*Az)/Ez	OUTSIDE AIR SPECIFIED ON DRAWINGS
			SQFT.	# PEOPLE	CFM/PERSON	CFM/AREA	ZONE AIR DISTANCE EFFECTIVENESS			MINIMUM OUTSIDE AIR REQUIRED	
STORAGE & STAFF BREAK AREA	STORAGE ROOMS	-	125	-	-	0.12	0.8	-	-	19	195
OFFICE & IT	OFFICE SPACES	5	165	2	5	0.06	0.8	-	-	25	
LOBBY	MAIN ENTRY LOBBIES	10	820	8	5	0.06	0.8	-	-	113	
TURF AREA	PLAY AREA	7	7730	40	20	0.18	1	-	-	2191	2200
JANITOR CLOSET	STORAGE ROOMS	-	45	-	-	0.12	0.8		50	7	
RESTROOM-1	TOILET ROOMS	-	60	-	-	-	-	70	70	-	-
RESTROOM-2	TOILET ROOMS	-	60	-	-	-	-	70	70	-	
TOTAL									**190**	**2355**	**2395**

AIR BALANCE

UNIT	AREA SERVED	SUPPLY AIR (CFM)	OUTSIDE AIR (CFM)	RETURN AIR (CFM)	EXHAUST AIR(CFM)
AC-1	SEE PLAN	459	65	394	-
AC-2	SEE PLAN	459	65	394	-
AC-3	SEE PLAN	459	65	394	-
OAF-1	SEE PLAN	2200	2200	-	-
EF-1	SEE PLAN	-	-	-	70
EF-2	SEE PLAN	-	-	-	70
EF-3	SEE PLAN	-	-	-	50
TOTAL:		3577	2395	1182	190
BUILDING PRESSURE:			**2205**	**POSITIVE**	

NOTES:

1. CONTRACTOR TO ADJUST MOTORIZED DAMPER ON OUTSIDE AIR TAP TO PROVIDE OUTSIDE AIR AS MENTIONED IN ABOVE TABLE.

TOILET EXHAUST FAN SCHEDULE

TAG	MANUFACTURER	MODEL	CFM	RPM	E.S.P. (IN. W.G.)	ELECTRICAL DATA			WEIGHT (LBS)
						VOLTS (V)	PHASE	FLA (A)	
EF-1	GREENHECK	SP-A90	70	900	0.25	115	1	0.17	12
EF-2	GREENHECK	SP-A90	70	900	0.25	115	1	0.17	12
EF-3	GREENHECK	SP-A90	50	900	0.25	115	1	0.17	12

NOTES / ACCESSORIES:

1. DIRECT DRIVE, GALVANIZED STEEL FORWARD CURVE FAN, ECM MOTOR; LOW SOUND CONSTRUCTION; HEAVY GAUGE CABINET INTERNALLY LINED WITH 1/2" ACOUSTICAL LINER; CEILING GRILLE; BACKDRAFT DAMPER; ELECTRICAL DISCONNECT; INTERNAL SPEED CONTROLLER; INTERLOCK WITH LIGHTS.

OUTSIDE AIR FAN SCHEDULE

TAG	MANUFACTURER	MODEL	CFM	RPM	E.S.P. (IN. W.G.)	ELECTRICAL DATA			WEIGHT (LBS)
						V/PH/Hz	MCA(A)	MOCP(A)	
OAF-1	GREENHECK	SQ-16-M2-VG	2200	1038	0.5	208/1/60	10	15	120
OAF-2	GREENHECK	CSP-A390-VG	195	1689	1.0	115/1/60	1.9	15	24

NOTES:

1. PROVIDE ALL MANUFACTURER RECOMMENDED ACCESSORIES.
2. PROVIDE MERV-8 2" THICKNESS FILTER.
3. PROVIDE WITH DISCONNECT. REFER TO ELECTRICAL PLANS FOR RATINGS & COORDINATE WITH E.C.
4. VARIABLE SPEED CONTROL.
5. THERMAL OVERLOAD PROTECTION.

DIFFUSERS, REGISTERS AND GRILLES SCHEDULE

UNIT ID	MANUFACTURER	MODEL	FRAME SIZE	NECK SIZE	MAX NC	DESCRIPTION	MOUNTING
S-1	TITUS	272FS	26X14	24X12	30	DBL-DEFLECTION REGISTER	WALL
R-1	TITUS	3F	26X14	24X12	30	LOUVERED GRILLE	WALL

NOTES / ACCESSORIES:

1. CONTRACTOR SHALL COORDINATE WITH ARCHITECT FOR FRAME, FININSH AND COLOUR.

Property of NY Engineers

PROJECT:
REDLINE ATHLETICS - FLEMINGTON NJ

DRAWING TITLE:
MECHANICAL SCHEDULE

SHEET:
M-301

PLUMBING SYMBOL LIST

— SAN —	SANITARY SEWER PIPING (ABOVE FLOOR)
— SAN —	SANITARY SEWER PIPING (UNDERGROUND)
- - - - -	VENT PIPING
— - —	COLD WATER PIPING
— - - —	HOT WATER PIPING
	P-TRAP
	PIPE UP
	PIPE DROP
	CLEANOUT
	PLUGGED OUTLET/CLEANOUT
	SHUT-OFF VALVE
	EXPANSION TANK
	WATER HAMMER ARRESTOR
	POINT OF CONNECTION

PLUMBING ABBREVATIONS

FCO	FLOOR CLEANOUT
WCO	WALL CLEANOUT
CW	COLD WATER
HW	HOT WATER
SAN	SANITARY
V	VENT
LAV	LAVATORY
WC	WATER CLOSET
TYP.	TYPICAL
DN	DOWN
FD	FLOOR DRAIN
N.I.C.	NOT IN SCOPE
WHA	WATER HAMMER ARRESTOR
WH	WATER HEATER
ET	EXPANSION TANK

PLUMBING DRAWING LIST

P-001 PLUMBING SYMBOLS, ABBREVIATIONS & SPECIFICATIONS

P-002 PLUMBING SPECIFICATIONS & SCHEDULE

P-101 PLUMBING WATER & GAS SUPPLY FLOOR PLAN & WATER SUPPLY RISERS

P-102 PLUMBING DRAINAGE FLOOR PLAN & RISER

P-201 PLUMBING DETAILS

BUILDING DEPARTMENT PLUMBING NOTES

1. ALL PLUMBING SYSTEMS (SANITARY, WASTE, VENT, WATER) AND ASSOCIATED EQUIPMENT SHALL BE INSTALLED, OPERATED AND MAINTAINED IN ACCORDANCE WITH THE REQUIREMENTS OF 2021 NATIONAL STANDARD PLUMBING CODE NJ EDITION (NSPC 2021).
2. INSTALLATION OF UNDERGROUND PIPING SHALL BE IN ACCORDANCE WITH THE REQUIREMENTS OF 2021 NATIONAL STANDARD PLUMBING CODE (NSPC 2021) SECTION 702.2
3. PROTECTION OF PIPING AND PLUMBING SYSTEM COMPONENTS AS PER 2021 NATIONAL STANDARD PLUMBING CODE (NSPC 2021) SECTION 305.
4. TRENCHING, EXCAVATION AND BACKFILL AS PER 2021 NATIONAL STANDARD PLUMBING CODE (NSPC 2021) SECTION 306.
5. RODENT PROOFING AS PER 2021 NATIONAL STANDARD PLUMBING CODE (NSPC 2021) SECTION 304.
6. MATERIALS USED IN PLUMBING SYSTEMS SHALL BE IN ACCORDANCE WITH THE REQUIREMENTS OF SECTION 2021 NATIONAL STANDARD PLUMBING CODE (NSPC 2021) 303, 605, 702, 902.
7. EQUIPMENT CONNECTIONS AND JOINING OF PIPING SHALL BE IN ACCORDANCE WITH THE REQUIREMENTS OF 2021 NATIONAL STANDARD PLUMBING CODE (NSPC 2021) CHAPTERS 4, 5, 6, 7, 8 AND 9.
8. DEEP SEAL TRAPS FOR FLOOR DRAINS SHALL BE PROVIDED AS PER 2021 NATIONAL STANDARD PLUMBING CODE (NSPC 2021) 1002, AND CLEAN-OUTS SHALL BE INSTALLED IN ACCORDANCE WITH THE REQUIREMENTS OF SECTION 2021 NATIONAL STANDARD PLUMBING CODE (NSPC 2021) SECTION 708.
9. VERTICAL AND HORIZONTAL PIPING SHALL BE SUPPORTED IN ACCORDANCE WITH THE REQUIREMENTS OF SECTION 2021 NATIONAL STANDARD PLUMBING CODE (NSPC 2021) SCETION 308.
10. WATER SUPPLY SYSTEMS SHALL BE INSTALLED AND MAINTAINED IN ACCORDANCE WITH THE REQUIREMENTS OF 2021 NATIONAL STANDARD PLUMBING CODE (NSPC 2021) CHAPTER 6 SECTION 601, 602, 603, 604, 606, 607, 608, 610, 611 AND 613.
11. THE SANITARY DRAINAGE SYSTEM SHALL BE SIZED AND INSTALLED IN ACCORDANCE WITH THE REQUIREMENTS OF 2021 NATIONAL STANDARD PLUMBING CODE (NSPC 2021) CHAPTER 7 SECTION 701, 704, 705, 706, 707, 708, 709 AND 710.
12. VENT PIPING FOR THE SANITARY DRAINAGE SYSTEM SHALL BE INSTALLED IN ACCORDANCE WITH THE REQUIREMENTS OF 2021 NATIONAL STANDARD PLUMBING CODE (NSPC 2021) CHAPTER 9 SECTIONS 901 THROUGH 2021 NATIONAL STANDARD PLUMBING CODE (NSPC 2021) SECTION 919.
13. INSPECTION AND TESTING OF PLUMBING PIPING SYSTEMS SHALL BE IN ACCORDANCE WITH SECTION 2021 NATIONAL STANDARD PLUMBING CODE (NSPC 2021) SECTION 107 AND 312.

PLUMBING SPECIFICATIONS

1. BASIC PLUMBING REQUIREMENTS, MATERIALS AND METHODS

1.01 SCOPE

A. PROVIDE ALL MATERIAL, TOOLS, SUPERVISION AND LABOR INCLUDING ALL MISCELLANEOUS AND INCIDENTAL ITEMS REQUIRED FOR COMPLETE AND OPERABLE PLUMBING INSTALLATIONS AS SHOWN OR DESCRIBED ON THE DRAWINGS AND IN THESE SPECIFICATIONS.

B. THE CONTRACTOR SHALL BE RESPONSIBLE FOR THE PROTECTION OF ALL EXISTING AND NEW CONDITIONS AND MATERIALS WITHIN THE CONSTRUCTION AREA. ANY DAMAGE CAUSED BY THE CONTRACTOR SHALL BE REPAIRED TO THE OWNER'S SATISFACTION.

C. OBTAIN ALL PERMITS, PAY ALL PERMIT FEES AND SCHEDULE ALL REQUIRED INSPECTIONS. COPIES OF ALL PERMITS AND INSPECTION CERTIFICATES SHALL BE FORWARDED TO THE OWNER FOR RECORD.

D. THE GENERAL CONDITIONS OF THE CONTRACT AND ALL DIVISION 1 REQUIREMENTS APPLY TO THE WORK OF THIS SECTION.

E. THE CONTRACTOR SHALL VISIT THE SITE PRIOR TO SUBMITTING BID TO DETERMINE CONDITIONS AND THE EXTENT OF THE WORK. BY COMMENCING WORK, THE CONTRACTOR ACKNOWLEDGES HIS CONFIRMATION OF ALL CONDITIONS AS ACCEPTABLE WITH REFERENCE TO HIS CONTRACT, SCOPE OF WORK AND BID PRICE SUCH THAT NO ADDITIONAL COMPENSATION SHALL BE FORTHCOMING FOR UNFORESEEN EXISTING CONDITIONS.

F. IN ALL AREAS SUBJECT TO FREEZING CONDITIONS, THE CONTRACTOR SHALL PROVIDE FREEZE PROTECTION FOR ALL DOMESTIC WATER PIPING INSTALLED UNDER HIS CONTRACT.

G. ALL ELECTRICAL REQUIREMENTS SHALL BE COORDINATED WITH THE CONTRACTOR FOR ELECTRICAL WORK. THIS CONTRACTOR IS RESPONSIBLE FOR ALL LOW VOLTAGE WIRING FOR EQUIPMENT INSTALLED UNDER HIS CONTRACT. THE CONTRACTOR FOR ELECTRICAL WORK IS RESPONSIBLE FOR LINE VOLTAGE POWER WIRING ONLY.

H. COLOR AND FINISH SELECTIONS FOR ALL MATERIALS, INCLUDING PAINTING OF PIPING, SHALL BE AS DIRECTED AND/OR APPROVED BY THE ARCHITECT.

I. MINOR DETAILS NOT SHOWN OR SPECIFIED, BUT NECESSARY FOR THE PROPER AND ACCEPTABLE CONSTRUCTION, INSTALLATION OR OPERATION OF ANY PART OF THE WORK AS DETERMINED BY THE ENGINEER SHALL BE INCLUDED AS IF SPECIFIED OR INDICATED ON THE DRAWINGS.

J. THIS CONTRACTOR SHALL BE RESPONSIBLE FOR COORDINATING ALL REQUIREMENTS FOR THE INSTALLATION, CONNECTION, EXTENSION OR MODIFICATION TO ALL UTILITY SERVICES WITH RESPECTIVE PROVIDERS INCLUDING PAYMENT OF ALL ASSOCIATED FEES.

K. THE CONTRACTOR IS RESPONSIBLE FOR ALL PAINTING ASSOCIATED WITH CUTTING AND PATCHING. ALL PAINTING IN AREAS WITH COMPLETE FINISH RENOVATIONS SHALL BE PROVIDED BY THE GENERAL CONTRACTOR.

1.02 SUBMITTALS

A. SUBMITTAL REQUIREMENTS SHALL BE COORDINATED WITH THE ARCHITECT AND AUTHORITIES HAVING JURISDICTION. UNLESS OTHERWISE DIRECTED, CONTRACTOR SHALL PROVIDE SUBMITTALS AS LISTED BELOW.

1. PIPE AND FITTINGS
2. VALVES
3. HANGERS AND SUPPORTS
4. PLUMBING PIPING LAYOUT
5. TESTS
6. PLUMBING FIXTURES
7. MIXING VALVES
8. ALL SCHEDULED PLUMBING EQUIPMENT
9. WATER HEATER

B. SUBMITTALS FROM SUPPLIERS OR MANUFACTURERS WHICH DO NOT BEAR THE STAMP OF THE SUBMITTING CONTRACTOR INDICATING THAT THE CONTRACTOR HAS REVIEWED THE SUBMITTAL FOR CONFORMANCE WITH THE PROJECT REQUIREMENTS WILL BE RETURNED REJECTED.

C. THE ENGINEER'S REVIEW OF SUBMITTALS IS A COURTESY WHICH DOES NOT RELIEVE THE CONTRACTOR FROM CONFORMING WITH THE CONSTRUCTION DOCUMENTS, REGARDLESS OF THE ACTION INDICATED BY THE SHOP DRAWINGS STAMP.

D. REVIEW OF SHOP DRAWINGS BY THE ENGINEER SHALL BE LIMITED TO THE INITIAL REVIEW, AND A SECOND REVIEW OF ANY REQUIRED RESUBMITTED DATA. IF THE ENGINEER IS REQUIRED TO REVIEW SHOP DRAWINGS FOR A THIRD (OR MORE) SUBMISSION OF THE SAME ITEM, THE CONTRACTOR SHALL BE LIABLE FOR COMPENSATING THE ENGINEER FOR THESE SUBSEQUENT REVIEWS AS PER THE ENGINEER'S CURRENT HOURLY RATE SCHEDULE.

E. SUBMIT PROOF OF APPROVAL AND/OR CONFIRMATION OF SATISFACTORY TEST RESULTS TO THE OWNER AND THE ARCHITECT.

F. SUBMIT TO THE OWNER'S MAINTENANCE PERSONNEL OPERATION AND MAINTENANCE DATA FOR ALL SYSTEM COMPONENTS, SERVICING REQUIREMENTS, INSPECTION DATA, REPLACEMENT PART NUMBERS AND AVAILABILITY AND CONTACT INFORMATION FOR SERVICE/SUPPLY COMPANY.

G. FOR ALL BELOW GRADE PIPING WHERE ACTUAL INSTALLATION DEVIATES FROM CONSTRUCTION DRAWINGS, THE CONTRACTOR SHALL PROVIDE AS-BUILT DRAWINGS INDICATING BELOW GRADE PIPE LOCATIONS DIMENSIONED TO NEAREST COLUMN LINES.

H. RECORD AS-BUILT DRAWINGS SHALL BE SUPPLIED TO THE OWNER/TENANT AFTER COMPLETION OF THE WORK SHOWING ANY ALTERATIONS, ADDITIONS AND/OR DELETIONS TO THE SYSTEM(S) INSTALLED.

1.03 SUBSTITUTIONS

A. ALL EQUIPMENT SHALL BE PRODUCTS OF THE SPECIFIED MANUFACTURER OR MANUFACTURERS. ALL BIDS SHALL BE BASED ON THE SPECIFIED MANUFACTURER OR MANUFACTURER'S EQUIPMENT. FOR SUBSTITUTIONS OF OTHER MANUFACTURER'S EQUIPMENT TO BE CONSIDERED, THE SUBSTITUTION MUST BE INDICATED PRIOR TO BIDDING WITH THE REASON FOR THE PROPOSED SUBSTITUTION IDENTIFIED, AND THE PROPOSED CREDIT TO THE OWNER INDICATED. THE ENGINEER SHALL DETERMINE THE ACCEPTABILITY OF ANY PROPOSED SUBSTITUTIONS.

B. THE CONTRACTOR ASSUMES ALL RESPONSIBILITY FOR COORDINATING THE WORK OF OTHER TRADES WHICH MAY BE AFFECTED BY SUBSTITUTIONS, INCLUDING ALL RELATED COSTS.

1.04 DEFINITIONS

A. FURNISH: TO PURCHASE, PROCURE, ACQUIRE AND DELIVER, COMPLETE WITH RELATED ACCESSORIES.

B. INSTALL: TO ERECT, MOUNT AND CONNECT, COMPLETE WITH RELATED ACCESSORIES.

C. PROVIDE: TO FURNISH AND INSTALL.

D. PLUMBING CONTRACTOR, THE CONTRACTOR, THIS CONTRACTOR: THE CONTRACTOR FOR PLUMBING WORK WHICH IS SPECIFIED HEREIN AND SHOWN ON THESE DRAWINGS.

1.05 DRAWINGS

A. THE DRAWINGS ARE DIAGRAMMATIC AND ARE INTENDED TO ILLUSTRATE THE GENERAL ARRANGEMENT AND ROUTING OF PIPING AND GENERAL LOCATIONS OF EQUIPMENT. PRECISE LOCATIONS OF EQUIPMENT, RISERS AND STACKS, AND ROUTING AND ELEVATION OF ALL PIPING SYSTEMS SHALL BE COORDINATED IN THE FIELD WITH THE ARCHITECT, ARCHITECTURAL DRAWINGS, THE WORK OF OTHER TRADES, EXISTING AND NEW BUILDING CONDITIONS AND/OR THE PREFERENCES OF THE OWNER/TENANT AS CONSTRUCTION PROCEEDS. ALL PIPING SHALL BE INSTALLED CONCEALED IN FINISHED SPACES, UNLESS NOTED OTHERWISE.

B. PROVIDE ALL NECESSARY INCIDENTAL MATERIALS AND ACCESSORIES REQUIRED TO MAKE THE WORK COMPLETE IN ALL RESPECTS, EVEN IF NOT PARTICULARLY SHOWN OR SPECIFIED.

C. REFER TO PLUMBING EQUIPMENT/FIXTURE SCHEDULE ON THE DRAWINGS FOR ALL FIXTURE AND EQUIPMENT SPECIFICATIONS.

D. REFER TO FIXTURE CONNECTION SIZE SCHEDULE FOR ALL FIXTURE ROUGHING SIZE REQUIREMENTS.

E. VERIFY ALL INDICATED CONDITIONS BEFORE STARTING WORK AND REPORT ANY DISCREPANCIES. THE DRAWINGS REFLECT CONDITIONS WHICH CAN BE REASONABLY INTERPRETED FROM THE EXISTING VISIBLE CONDITIONS OR FROM DRAWINGS AND INFORMATION FURNISHED BY THE OWNER.

F. LOCATE ALL FIXTURES AND EQUIPMENT AS PER THE FINAL ARCHITECTURAL DRAWINGS.

1.06 PRODUCTS

A. SANITARY AND VENT PIPING:

1. UNDERGROUND GRAVITY SEWERS & VENT PIPE SHALL BE CAST IRON OR PVC PIPE.
2. SLOPE OF DRAINAGE SYSTEM SHALL BE 1/8" PER FOOT OF RUN FOR PIPE OVER 3" (I.D.) AND 1/4" PER FOOT OF RUN FOR PIPE 3" AND SMALLER (I.D.). VENT PIPING SHALL BE PITCHED TO DRAIN.
3. CAST IRON PIPES SHALL BE APPROVED BY CISPI.

B. DOMESTIC WATER PIPING:

1. ABOVE GRADE WATER PIPING SHALL BE TYPE 'L' HARD-DRAWN COPPER TUBE.
2. FITTINGS IN DOMESTIC WATER PIPING SHALL BE COPPER OR COPPER ALLOY
3. JOINTS SHALL BE MADE WITH LEAD-FREE SOLDER.
4. THE ENTIRE DOMESTIC WATER DISTRIBUTION SYSTEM SHALL BE INSULATED INCLUDING ALL VALVES, FITTINGS, ETC.
5. COMPLY WITH NSF 61 FOR MATERIALS FOR WATER-SERVICE PIPING AND SPECIALTIES FOR DOMESTIC WATER.
6. ALL DOMESTIC WATER PIPING ABOVE GRADE SHALL BE INSULATED WITH FIRE RETARDANT, FACTORY APPLIED JACKET. PROVIDE COLD WATER PIPING WITH FACTORY APPLIED VAPOR BARRIER. INSULATION REQUIREMENT SHOULD COMPLY WITH ASHRAE 90.1 2019 SECTION 7.4.3 BELOW TABLE.

MINIMUM PIPE INSULATION THICKNESS							
FLUID OPERATING TEMPERATURE RANGE AND USAGE (°F)	INSULATION CONDUCTIVITY		NOMINAL PIPE OR TUBE SIZE (INCHES)				
	CONDUCTIVITY BTU.IN./ (H.FT2.°F)	MEAN RATING TEMPERATURE, °F	<1	1 to < 1½	1½ to < 4	4 to < 8	≥8
141-200	0.25-0.29	125	1.5	1.5	2	2	2
105-140	0.21-0.28	100	1.0	1.0	1.5	1.5	1.5
40-60	0.21-0.27	75	0.5	0.5	1.0	1.0	1.0

7. AS PER ASHRAE 90.1 2019 SECTION 7.4.4.2, SYSTEM DESIGNED TO MAINTAIN USAGE TEMPERATURE IN HOT WATER PIPES SUCH AS RE-CIRCULATING HOT WATER SYSTEMS OR HEAT TRACE, SHALL BE EQUIPPED WITH AUTOMATIC TIME SWITCHES OR OTHER CONTROLS THAT CAN BE USED TO SWITCH THE USAGE TEMPERATURE MAINTENANCE SYSTEM DURING EXTENDED PERIOD WHEN HOT WATER IS NOT REQUIRED.
8. AS PER ASHRAE 90.1 2019 SECTION 7.4.4.3, TEMPERATURE CONTROLLING MEANS SHALL BE PROVIDED TO LIMIT THE MAXIMUM TEMPERATURE OF WATER DELIVERED FROM LAVATORY FAUCETS IN PUBLIC FACILITY RESTROOMS TO 110°F.
9. AS PER ASHRAE 90.1 2019 SECTION 7.4.4.4, WHEN USED TO MAINTAIN STORAGE TANK WATER TEMPERATURE, RE-CIRCULATING PUMPS SHALL BE EQUIPPED WITH CONTROLS LIMITING OPERATION TO A PERIOD FROM THE START OF THE HEATING CYCLE TO A MAXIMUM OF FIVE MINUTES AFTER THE END OF THE HEATING CYCLE.
10. SEAL ALL JOINTS BETWEEN SEGMENTS OF INSULATION.
11. PROVIDE SHIELDS BETWEEN HANGERS AND INSULATION.

C. ELECTRIC TANK WATER HEATER

1. ELECTRIC TANK WATER HEATER WITH 10 GALLONS STORAGE CAPACITY SHALL HAVE 150 PSI WORKING PRESSURE AND BE EQUIPPED WITH EXTRUDED HIGH DENSITY ANODE.
2. ALL INTERNAL SURFACES OF THE HEATER EXPOSED TO WATER SHALL BE GLASS-LINED WITH AN ALKALINE BORO SILICATE COMPOSITION THAT HAS BEEN FUSED-TO-STEEL BY FIRING AT A TEMPERATURE RANGE OF 1400°F TO 1600°F.
3. ELECTRIC HEATING ELEMENTS SHALL BE LOW WATT DENSITY GOLDENROD 1" SCREW-IN TYPE.

D. MAINTAIN ALL REQUIRED AND RECOMMENDED CLEARANCES FOR ALL PLUMBING SYSTEM COMPONENTS AND EQUIPMENT.

E. HANGERS AND SUPPORTS:

1. HANGERS SHALL BE STANDARD STEEL, MALLEABLE OR WROUGHT IRON, AS MANUFACTURED BY GRINNELL OR APPROVED EQUAL, SUITABLE FOR THE TYPE OF CONSTRUCTION. PIPING SHALL NOT BE HUNG FROM OTHER PIPE.
2. SECTIONS OF INDIVIDUAL PIPE RUNS SHALL BE SUPPORTED BY CLEVIS HANGERS.
3. ALL EQUIPMENT SHALL BE PROVIDED WITH APPROVED SUPPORTS.
4. PROVIDE SEISMIC RESTRAINTS IN ACCORDANCE WITH ALL APPLICABLE FEDERAL, STATE AND LOCAL CODES AND STANDARDS AND THE REQUIREMENTS OF AUTHORITIES HAVING JURISDICTION.
5. UNLESS OTHERWISE INDICATED OR REQUIRED BY AUTHORITIES HAVING JURISDICTION, THE FOLLOWING SHALL BE PROVIDED WITH SEISMIC RESTRAINTS AS REQUIRED BY THE BOCA NATIONAL BUILDING CODE, SECTION 1610.6.4: ALL EQUIPMENT AND MACHINERY, ALL NEW PIPING 2-1/2" AND LARGER (1-1/4" AND LARGER INBOILER/MECHANICAL ROOMS) WITH HANGERS GREATER THAN 12" IN LENGTH FROM THE TOP OF PIPE TO THE STRUCTURE.
6. SUPPORTS SHALL BE PROVIDED IN STRICT ACCORDANCE WITH THE RECOMMENDATIONS OF THE PIPING MANUFACTURER.

F. VALVES:

1. PROVIDE GATE VALVES, BUTTERFLY OR BALL VALVES FOR SHUT-OFF DUTY ON MAIN AND BRANCH SUPPLY LINES. FOR ALL PIPE RUNS 2" AND SMALLER, PROVIDE BALL FOR ALL PIPE RUNS LARGER THAN 2" AND SMALLER THAN 4", PROVIDE GATE VALVES. PIPING 4" AND LARGER, PROVIDE BUTTERFLY VALVES FOR SHUT-OFF DUTY.
2. ALL FIXTURES WITH THE EXCEPTION O FLUSHOMETER-EQUIPPED WATER CLOSETS AND URINALS SHALL HAVE STOP VALVES TO CONTROL SUPPLY TO THE FIXTURE. WHERE SUPPLIES ARE EXPOSED PROVIDE CHROME-PLATED STOPS WITH CHROME-PLATED ESCUTCHEONS ON PIPING PENETRATIONS.
3. ALL PLUMBING FIXTURES AND EQUIPMENT TO HAVE SHUT-OFF VALVES ON SUPPLY LINES.
4. ALL BRANCH LINES TO HAVE SHUT-OFF VALVES.
5. ALL VALVES SHALL BE ACCESSIBLE. PROVIDE ACCESS DOORS WHERE REQUIRED FOR VALVE ACCESS.
6. PROVIDE GLOBE VALVES FOR THROTTLING/BALANCING OF THE HOT WATER CIRCULATING SYSTEM.

G. SLEEVES AND ESCUTCHEONS:

1. SLEEVES THROUGH STRUCTURAL CONCRETE MEMBERS AND SLEEVES FOR WALLS BELOW GRADE AND FLOORS ON GRADE SHALL BE STANDARD WEIGHT GALVANIZED SCHEDULE 40 STEEL PIPE. SLEEVES THROUGH OTHER THAN STRUCTURAL COMPONENTS OF THE BUILDING SHALL BE 20 GAGE GALVANIZED SHEET METAL WITH LOCK SEAM JOINTS. USG THERMAFIBER SAFING INSULATION SHALL BE INSTALLED BETWEEN PIPE AND SLEEVE.
2. PIPE ESCUTCHEON PLATES SHALL BE INSTALLED WHERE EXPOSED PIPING PASSES THROUGH WALLS, CEILINGS, AND FLOORS AND SHALL BE MINIMUM 20 GAGE STEEL. PROVIDE CHROME PLATED ESCUTCHEON PLATES IN FINISHED AREAS.

H. DRAINAGE ACCESSORIES

1.GENERAL:

a. INSTALL THE WORK OF THIS SECTION IN ACCORDANCE WITH THE MANUFACTURER'S PRINTED INSTALLATION INSTRUCTIONS, UNLESS OTHERWISE SPECIFIED.
b. SECURE EXTERNAL COMPONENTS IN PLACE WITH VANDAL RESISTANT FASTENERS OR DEVICES WHICH CANNOT BE REMOVED WITHOUT SPECIAL TOOLS.

I. INSTALL PIPING TO CONSERVE BUILDING SPACE. DO NOT INTERFERE WITH USE OF BUILDING SPACE AND THE WORK OF OTHER TRADES. ALL PIPING RUN IN CEILING SHALL BE INSTALLED TIGHT TO THE STRUCTURE ABOVE.

J. INSTALL PIPING TO ALLOW FOR EXPANSION AND CONTRACTION WITHOUT STRESSING PIPE, JOINTS OR CONNECTED EQUIPMENT. PROVIDE PIPE ANCHORS, GUIDES AND EXPANSION JOINTS OR LOOPS IN ALL HOT WATER AND HOT WATER CIRCULATING MAIN SUPPLY PIPING AND SEGMENTS OF SUCH PIPE THAT EXCEED 30'-0" IN LENGTH.

K. IN ALL AREAS WITH FINISHED SURFACES, SYSTEM PIPING AND COMPONENTS SHALL BE CONCEALED ABOVE OR WITHIN FINISHED SURFACES.

L. REDUCTIONS IN PIPE SIZES SHALL BE MADE WITH ONE-PIECE REDUCING FITTINGS. BUSHINGS ARE NOT ACCEPTABLE. USE FLANGED FITTINGS AT THE BASE OF RISERS.

M. VENT PENETRATIONS THROUGH THE ROOF SHALL BE FLASHED.

N. IF WATER PRESSURE EXCEEDS 80 PSI, A WATER PRESSURE REDUCING VALVE SHALL BE INSTALLED IN WATER PIPING AT CONNECTION TO MAIN.

O. PROVIDE DIELECTRIC FITTINGS BETWEEN DISSIMILAR METALS.

P. PIPE BACKFLOW PREVENTER DRAINS TO FLOOR DRAIN OR OTHER APPROVED INDIRECT WASTE SOURCE.

Q. PROVIDE ACCESS DOORS/PANELS FOR SERVICE AND ACCESS TO ALL VALVES AND OTHER SYSTEM COMPONENTS ENCLOSED IN WALLS AND CEILINGS. ACCESS DOORS SHALL BE FURNISHED BY THIS CONTRACTOR, INSTALLED BY THE GENERAL CONTRACTOR.

R. ALL FIXTURES REQUIRING VACUUM BREAKERS SHALL BE EQUIPPED WITH INTEGRAL VACUUM BREAKERS.

S. ANY PENETRATIONS THROUGH FIRE RATED PARTITIONS, FLOORS, OR CEILINGS SHALL BE STEEL SLEEVED AND SEALED WITH 3M BRAND UL RATED FIRE BARRIER CAULK OR APPROVED EQUAL.

T. WHEN THE WATER PIPING SYSTEM IS COMPLETE, THOROUGHLY FLUSH ALL DIRT, SEDIMENT, SOLDER, ETC., OUT OF THE SYSTEM, REMOVING ALL STRAINERS, VALVE STEM SEATS, ETC., REQUIRED TO ACCOMPLISH THE FLUSHING.

U. AT ALL INDIRECT WASTE DRAINS, MAINTAIN AIR GAP AS REQUIRED BY CODE.

V. INSTALL SLEEVES FOR ALL PIPES WHICH PASS THROUGH WALLS, FLOORS, AND CEILINGS. WHERE PIPES ARE TO BE INSULATED, THE SLEEVE SHALL BE LARGE ENOUGH TO ACCOMMODATE INSULATION. SLEEVES SHALL BE FLUSH WITH FINISHED SURFACES AT BOTH ENDS. ON FINISHED SURFACES IN EXPOSED AREAS PROVIDE ESCUTCHEONS COMPATIBLE WITH FINISH.

W. PROVIDE WATER HAMMER ARRESTERS ON SUPPLY PIPING TO ALL FLUSHOMETER VALVES AND QUICK-CLOSING VALVES.

1.07 DEMOLITION

A. VISIT THE SITE, EXAMINE THE EXISTING CONDITIONS AND BECOME FAMILIAR WITH THE EXTENT OF THE NECESSARY REMOVAL, RELOCATION, RECONNECTING AND REROUTING OF PLUMBING EQUIPMENT AND PIPING AS NECESSARY FOR THE COMPLETION OF THE PROJECT.

B. REVIEW AND CONFIRM WITH THE ARCHITECT/DESIGNER'S DRAWINGS FOR THE COMPLETE EXTENT OF DEMOLITION AND ALTERATION.

C. ENSURE THAT ALL EXISTING PLUMBING PIPING OR SYSTEMS, IN AREAS OUTSIDE THE AREAS OF THIS WORK, THAT ARE REQUIRED TO REMAIN IN SERVICE, SHALL DO SO.

D. RELOCATE ANY PLUMBING PIPING OR EQUIPMENT THAT IS REQUIRED TO REMAIN IN SERVICE, THAT IS SECURED TO EXISTING WALLS, FLOORS OR CEILINGS TO BE DEMOLISHED.

E. ALL EXISTING PLUMBING EQUIPMENT OR PIPING WHICH IS NO LONGER REQUIRED SHALL BE REMOVED AND DISPOSED OF, OFF SITE.

F. BE RESPONSIBLE AND PAY FOR ANY DAMAGE TO THE BASE BUILDING INCURRED BY WORK OF THIS DIVISION, OR REPAIR TO THE SATISFACTION OF THE CONSULTANT.

G. CARRY OUT THE WORK WITH MINIMUM OF NOISE, DUST AND DISTURBANCE

2. INSTALLATION

2.01 GENERAL

A. ALL WORK WHICH REQUIRES DISRUPTION OF THE ROOFING SHALL BE DONE BY A CONTRACTOR CERTIFIED BY THE ROOFING MANUFACTURER AS REQUIRED TO MAINTAIN ANY EXISTING ROOF WARRANTIES.

B. EXTERIOR INSTALLATIONS TO BE WEATHER PROOF IN ALL RESPECTS.

C. EXTERIOR MATERIALS AND EQUIPMENT SHALL BE PAINTED TO PREVENT CORROSION, COLOR PER ARCHITECT.

D. COORDINATE THE PLUMBING WORK WITH ALL OTHER AFFECTED WORK AND THE CONSTRUCTION SCHEDULE.

E. REAM PIPE AND TUBE ENDS. REMOVE BURRS. BEVEL PLAIN AND FERROUS END PIPE.

F. REMOVE SCALE AND FOREIGN MATERIAL, FROM INSIDE AND OUTSIDE, BEFORE ASSEMBLY.

G. PREPARE PIPING CONNECTIONS TO EQUIPMENT WITH FLANGES AND UNIONS.

H. COORDINATION WITH THE WORK OF OTHER TRADES IS REQUIRED. PROVIDE OFFSETS IN PIPING SYSTEMS OR MINOR DEVIATIONS TO THE INDICATED PIPE ROUTING IN ORDER TO COORDINATE THE PLUMBING WORK WITH THE WORK OF ALL OTHER TRADES AND THE GENERAL BUILDING CONDITIONS.

I. NO DOMESTIC WATER PIPING SHALL BE INSTALLED IN UNHEATED SPACES.

J. PRIOR TO DISCONNECTING AND CONNECTING NEW WORK TO EXISTING SYSTEMS, THE PLUMBING CONTRACTOR SHALL NOTIFY THE PROPERTY MANAGER AND OFFER A PROPOSED SCHEDULE OF WORK. ESB WILL AUTHORIZE CONNECTIONS AND COORDINATE NECESSARY SHUT DOWNS AND DRAIN DOWNS AS REQUIRED. SHUT DOWNS AND DRAIN DOWNS MAY BE PERFORMED BY THE PLUMBING CONTRACTOR ONLY AFTER RECEIVING ESB AUTHORIZATION, AND SHOULD BE PERFORMED UNDER SUPERVISION OF ESB PERSONNEL. THREE (3) DAYS ADVANCE NOTICE TO THE PROPERTY MANAGER IS REQUIRED.

K. THE PLUMBING CONTRACTOR IS ADVISED THAT DUE TO THE NATURE OF THE OPERATIONS AND TENANT REQUIREMENTS, CONNECTIONS TO EXISTING SYSTEMS MAY HAVE TO BE MADE AFTER REGULAR WORKING HOURS. THE PROPERTY MANAGER WILL ADVISE THE PLUMBING CONTRACTOR OF THE TIME CONSTRAINTS UPON RECEIPT AND APPROVAL OF THE PLUMBING CONTRACTOR'S REQUEST FOR SHUT DOWN AND CONNECTION TO EXISTING SYSTEMS.

L. WHEN CONNECTING TO EXISTING STACKS AND RISERS, PROVISION IS TO BE MADE FOR FUTURE CONNECTIONS BY PROVIDING CAPPED AND VALVED OUTLETS ON DOMESTIC WATER RISERS AND PLUGGED OUTLETS ON THE SANITARY AND VENT STACKS.

2.02 ABOVE GRADE

a. INSTALL PLUMBING PIPING IN ACCORDANCE WITH RECOGNIZED INDUSTRY PRACTICES TO ENSURE THAT PIPING COMPLIES WITH REQUIREMENTS AND SERVES INTENDED PURPOSES.

b. ROUTE PIPING IN AN ORDERLY MANNER, PLUMB AND PARALLEL TO BUILDING STRUCTURE. MAINTAIN GRADIENT. SLOPE PIPING AND ARRANGE SYSTEMS TO DRAIN. IN DOMESTIC WATER SYSTEMS, PROVIDE DRAIN VALVES AT MAIN SHUT-OFF VALVES AND ALL LOW POINTS IN PIPING.

c. USE EXISTING CONNECTIONS AT MAINS WHERE AVAILABLE FOR NEW BRANCH PIPING. LOCATE ALL RISERS AND PIPING BEFORE CONSTRUCTION COMMENCES AND TAKE CARE NOT TO DAMAGE SAME. ANY DAMAGE OCCURRING TO THE EXISTING PIPING WILL BE THE SOLE RESPONSIBILITY OF THE CONTRACTOR.

PORZIO ONY Engineers

PROJECT:
REDLINE ATHLETICS - FLEMINGTON NJ

DRAWING TITLE:
PLUMBING SYMBOLS, ABBREVIATIONS & SPECIFICATIONS

SHEET:
P-001

M. DRAINAGE ACCESSORIES

1. GENERAL:

a. INSTALL THE WORK OF THIS SECTION IN ACCORDANCE WITH THE MANUFACTURER'S PRINTED INSTALLATION INSTRUCTIONS, UNLESS OTHERWISE SPECIFIED.

b. SECURE EXTERNAL COMPONENTS IN PLACE WITH VANDAL RESISTANT FASTENERS OR DEVICES WHICH CANNOT BE REMOVED WITHOUT SPECIAL TOOLS.

N. DEVICES:

a. CLEANOUT & CLEANOUT PLUG

- THREADED PIPE FITTING OR CAST IRON FERRULE WITH GAS TIGHT CLEANOUT PLUG
- PLUG SHOULD BE CAST BRASS OR BRONZE, WITH THREADED END, AND RAISED OR COUNTERSUNK HEAD.
- LUBRICATE THREADS OF CLEANOUT PLUG WITH ANTI-SEIZE LUBRICANT BEFORE FINAL INSTALLATION.

b. CLEANOUT WALL PLATE

- IT SHOULD BE ROUND, STAINLESS STEEL OR POLISHED CHROME PLATED BRONZE COVER PLATE WITH STAINLESS STEEL VANDAL RESISTANT FASTENER TO SECURE TO CLEANOUT PLUG.

c. CLEANOUT DECK PLATE

- IT SHOULD BE STANDARD DUTY FLOOR CLEANOUT FITTING WITH COATED CAST IRON BODY; ROUND, POLISHED NICKEL BRONZE SCORIATED TOP SECURED TO CLEANOUT PLUG WITH STAINLESS STEEL VANDAL RESISTANT FASTENER; THREADED HEIGHT ADJUSTMENT, CAST IRON HEAD, GAS TIGHT CLEANOUT PLUG, AND CONNECTION TO MATCH PIPING OPTION SELECTED.
- GRILLE FREE AREA SHOULD BE AT LEAST EQUAL TO CROSS-SECTION AREA OF PIPE TO WHICH CONNECTION MADE AND MADE OF POLISHED NICKEL BRONZE, WITH REMOVABLE GRATE, EITHER PERFORATED OR BAR TYPE. GRATE ATTACHED TO GRILLE BODY WITH VANDAL RESISTANT FASTENER.
- MAINTAIN MINIMUM 10'-0" CLEARANCE BETWEEN ALL PLUMBING V.T.R.S AND ALL OUTDOOR AIR INTAKES. OFFSET VENT STACKS AND STACK VENTS IF AND AS REQUIRED BELOW ROOF TO MAINTAIN SUCH CLEARANCE WHETHER OR NOT SUCH OFFSET IS INDICATED ON THE DRAWINGS. PROVIDE ALL REQUIRED SEISMIC SUPPORTS.

2.03 LEAK DETECTION

A. VISIT THE SITE, EXAMINE THE EXISTING CONDITIONS AND BECOME FAMILIAR WITH THE EXTENT OF THE NECESSARY REMOVAL, RELOCATION, RECONNECTING AND REROUTING OF PLUMBING EQUIPMENT AND PIPING AS NECESSARY FOR THE COMPLETION OF THE PROJECT.

B. FURNISH AND INSTALL A FLOODMASTER RS-094-1 WATER HEATER LEAK DETECTION AND AUTOMATIC SHUT- OFF KIT, INCLUDING FULL-PORT SHUT-OFF VALVE, ACTUATOR, WATER SENSING PUCK, PLUG FOR A STANDARD 120 V AC OUTLET, RELAYS FOR CONNECTION TO BMS, THE KIT SHALL INCLUDE ALL SYSTEM COMPONENTS FOR A TYPICAL INSTALLATION. CONTACT RELIANCE DETECTION TECHNOLOGIES 888-771-4929.

3. TESTING

A. AT THE COMPLETION OF THE PLUMBING WORK, COMPLETELY TEST THE ENTIRE INSTALLATION OF ALL SYSTEMS FOR PROPER OPERATION AND COMPLIANCE WITH APPLICABLE CODES AND LOCAL REQUIREMENTS. CORRECT ALL DEFICIENCIES FOUND.

B. TESTING OF THE INSTALLED SYSTEMS SHALL BE MADE BY THE CONTRACTOR IN THE PRESENCE OF A REPRESENTATIVE OF THE OWNER.

C. THE CONTRACTOR SHALL NOT COVER UP OR PERMANENTLY CONCEAL PIPING, DEVICES OR ANY PORTION OF NEWLY CONSTRUCTED PLUMBING SYSTEM(S) UNTIL SUCH SYSTEM, OR PORTION OF THE SYSTEM, HAS BEEN TESTED IN THE PRESENCE OF A REPRESENTATIVE OF THE OWNER AND INSPECTED BY THE LOCAL INSPECTOR AND APPROVED IN WRITING, EXCEPT PIPING PASSING THROUGH FLOORS, WALLS, PARTITIONS, OR BEAMS, FOR DISTANCES EQUAL TO THE THICKNESS OF SUCH FLOOR, WALL, PARTITION OR BEAM.

D. THIS CONTRACTOR SHALL NOTIFY THE VARIOUS DEPARTMENTS, BUREAUS AND INDIVIDUALS AT LEAST TWO WEEKS IN ADVANCE OF THE TIME THAT THE TESTS ARE TO BE CONDUCTED.

E. ALL DEFECTIVE PARTS SHALL BE REPLACED OR CORRECTED BY THIS CONTRACTOR AND AN EXTRA TEST OR TESTS SHALL BE MADE UNTIL THE OPERATION IS SATISFACTORY. ALL ARRANGEMENTS AND EXPENSES NECESSARY TO CONDUCT ALL TESTS REQUIRED BY THESE SPECIFICATIONS AND THE VARIOUS AGENCIES HAVING JURISDICTION OVER THE WORK INSTALLED UNDER THIS CONTRACT SHALL BE MADE BY THIS CONTRACTOR. NO EXTRA COMPENSATION WILL BE ALLOWED FOR THESE TESTS, THE COST THEREOF BEING INCLUDED IN THE LUMP SUM BID FOR THIS CONTRACT.

F. WHERE ANY EVIDENCE OF STOPPAGE IS FOUND IN PIPING OR EQUIPMENT, THIS CONTRACTOR SHALL DISCONNECT, CLEAN, REPAIR AND RECONNECT ALL OBSTRUCTED PIPING OR EQUIPMENT AND SHALL ALSO PAY FOR ALL NECESSARY CUTTING AND REPAIRS TO ADJOINING WORK.

G. ALL PIPING AND EQUIPMENT SHALL BE THOROUGHLY CLEANED INSIDE AND OUT, OF DIRT, CUTTINGS, OILS AND OTHER FOREIGN SUBSTANCES AND SHALL BE LEFT CLEAN.

H. ALL REQUIRED TESTS SHALL BE WITNESSED BY LOCAL AUTHORITIES AND THE OWNER'S REPRESENTATIVE.

I. ALL EQUIPMENT WILL BE FACTORY TESTED.

J. CONTRACTOR SHALL IDENTIFY TO THE OWNER'S REPRESENTATIVE ANY LEAKS OR DAMAGE THAT OCCURS AS A RESULT OF SYSTEM TESTING. CONTRACTOR SHALL TAKE NECESSARY PRECAUTIONS TO LIMIT ANY POTENTIAL DAMAGE. CORRECTIVE ACTION REQUIRED AS A RESULT OF TESTING SHALL BE PERFORMED IMMEDIATELY AND AT THE CONTRACTOR'S EXPENSE.

K. REPORT IN WRITING TO AUTHORITIES HAVING JURISDICTION, THE ARCHITECT AND THE OWNER THE RESULTS OF ALL TESTING.

L. TESTING REQUIREMENTS

a. TEST ALL DOMESTIC WATER PIPING AS PER 2021 NATIONAL STANDARD PLUMBING CODE.
b. TESTS SHALL BE WITNESSED BY THE BUILDING ENGINEER.
c. THE PLUMBING CONTRACTOR WILL BE HELD RESPONSIBLE FOR ALL DAMAGE DUE TO TEST FAILURES AND LEAKAGE IN THE TEST AREA AND ADJACENT TENANT OR ESB SPACES.

M. THOROUGHLY FLUSH PIPING SYSTEM WITH FRESH WATER IMMEDIATELY PRIOR TO FINAL ACCEPTANCE.

N. INSPECTION & TESTING SHALL BE AS PER 2021 NATIONAL STANDARD PLUMBING CODE.

O. PRESS JOINERY SYSTEM:

a. FITTINGS ½" - 4":

1. WHERE APPROVED BY THE LOCAL JURISDICTION, THE NIBCO PRESS SYSTEM MAY BE USED AT THE CONTRACTOR'S OPTION FOR THE FOLLOWING BUILDING SERVICES PIPING -20°F TO +250°F UP TO 200 PSI:
- HOT AND COLD DOMESTIC WATER; FITTINGS AND VALVES SHALL BE NSF-61 APPROVED.
- POTABLE WATER; FITTINGS AND VALVES SHALL BE NSF-61 APPROVED.
- HOT WATER HEATING SERVICE

ALL LEAD FREE WROT COPPER PRESS FITTINGS SHALL BE MADE FROM COMMERCIALLY PURE COPPER MILL PRODUCTS PER ASTM B 75 ALLOY C12200. THESE FITTINGS SHALL BE THIRD-PARTY CERTIFIED TO NSF/ANSI 61 ANNEX G AND COMPLY WITH NEW JERSEY STATE HEALTH AND SAFETY CODE, NSPC 2021 AND VERMONT ACT 193. NIBCO LEAD FREE CAST DEZINCIFICATION-RESISTANT (DZR) FITTINGS SHALL BE MADE FROM A HIGH QUALITY LEAD FREE PERFORMANCE BRONZE ALLOY PER ASTM B 584 ALLOY C87850. THE PRESS FITTINGS CONNECTIONS SHALL BE COMPATIBLE WITH SEAMLESS K, L OR M COPPER TUBE MADE TO ASTM B 88. FITTINGS SHALL HAVE A MAXIMUM NON-SHOCK WORKING PRESSURE OF 200 PSI BETWEEN THE TEMPERATURES OF -20°F AND +250°F. ELASTOMERIC SEALS WITH LEAK DETECTION DESIGN SHALL BE MADE OF EPDM MATERIAL, AND THE FITTINGS SHALL BE MANUFACTURED WITH AN INBOARD BEAD DESIGN. NIBCO PRESS FITTINGS MEET ALL PERFORMANCE REQUIREMENTS OF ASME B16.22 AND B16.18ALL FITTINGS SHALL BE INSTALLED IN ACCORDANCE WITH THE MANUFACTURER'S INSTALLATION INSTRUCTIONS AND ACCORDING TO LOCAL PLUMBING AND MECHANICAL CODES. THE PRESS-TO-CONNECT JOINT SHALL BE MADE WITH PRESSING TOOLS AND JAW SETS RECOMMENDED AND AUTHORIZED BY NIBCO. ALL FITTINGS, VALVES AND TOOLS SHALL BE PROVIDED BY SAME MANUFACTURER; NIBCO.

b. VALVES 2" AND SMALLER: BALL VALVES: (ON/OFF, ISOLATION OR THROTTLING)

1. BALL VALVES (STAINLESS STEEL BALL AND STEM) WITH MALE OR FEMALE PRESS-TO-CONNECT ENDS SHALL BE RATED AT 200 PSI CWP TO +250°F MAXIMUM. NIBCO LEAD FREE VALVES SHALL BE MANUFACTURED IN ACCORDANCE WITH MSS SP-110 AND CONSTRUCTED OF DEZINCIFICATION-RESISTANT (DZR) BRONZE BODIES AND END PIECES AND SHALL BE MADE FROM A HIGH QUALITY LEAD FREE PERFORMANCE BRONZE ALLOY PER ASTM B 584 ALLOY C87850. NO BRASS CONTAINING MORE THAN 15% ZINC SHALL BE APPROVED. VALVE SHALL HAVE REINFORCED TEFLON SEATS, BLOW-OUT PROOF STEM, SOLID STAINLESS STEEL BALL AND STEM. NO HOLLOW CHROME PLATED BALLS ACCEPTED. ALL VALVES SHALL BE FULL PORT. ALL ELASTOMERIC SEALS SHALL HAVE LEAK DETECTION DESIGN.
- WHERE PIPING IS TO BE INSULATED, BALL VALVES SHALL BE EQUIPPED WITH 2" EXTENDED HANDLES OF NON-THERMAL CONDUCTIVE MATERIAL. HANDLE TO HAVE EXTENDED SLEEVE INCORPORATING AN INSULATION PLUG TO PROVIDE A VAPOR BARRIER AND ALLOW VALVE OPERATION WITHOUT DISTURBING THE INSULATION, AND A MEMORY STOP, WHICH CAN BE SET AFTER INSTALLATION.
- ACCEPTABLE VALVES: (NSF-61, NON-INSULATED LINES): NIBCO PC585-66-LF, -HC, -LL.
- ACCEPTABLE VALVES: (NSF-61, INSULATED LINES): NIBCO PC585-66-LF-NS, -HC, -LL

c. CHECK VALVES: (BACKFLOW PREVENTION)

1. VALVES WITH PRESS-TO-CONNECT ENDS SHALL BE RATED TO 200 PSI CWP AT +250°F MAXIMUM. NIBCO LEAD FREE VALVES SHALL BE MANUFACTURED IN ACCORDANCE WITH MSS SP-80 AND CONSTRUCTED OF DEZINCIFICATION-RESISTANT (DZR) BRONZE BODY & CAP SHALL BE MADE FROM A HIGH QUALITY LEAD FREE PERFORMANCE BRONZE ALLOY PER ASTM B 584 ALLOY C87850. DISC SHALL BE TFE TEFLON. ALL ELASTOMERIC SEALS SHALL HAVE LEAK DETECTION DESIGN. ACCEPTABLE CHECK VALVES: NIBCO PS413-Y-LF : Y PATTERN, SWING TYPE CHECK VALVE; NIBCO PS480-Y-LF : IN-LINE SPRING LOADED SILENT CHECK VALVE

d. BUTTERFLY VALVES 2-1/2" - 4", (ON/OFF, ISOLATION OR THROTTLING)

1. BUTTERFLY VALVES WITH FEMALE LEAD FREE PRESS-TO-CONNECT ENDS SHALL BE RATED AT 200 PSI. CWP TO +250°F MAXIMUM. VALVES SHALL BE MANUFACTURED IN ACCORDANCE WITH MSS SP-67 AND CONSTRUCTED OF A DUCTILE-IRON BODY, FOR BUBBLE-TIGHT SHUTOFF, EXTENDED-NECK FOR INSULATION, DISC AND LINING SUITABLE FOR POTABLE WATER, VALVES SHALL BE SUITABLE FOR BI-DIRECTIONAL DEAD END SERVICE AT FULL RATED PRESSURE, ONE-PIECE TYPE 416 STAINLESS-STEEL STEM, COPPER BUSHING, FASTENERS AND PINS SHALL NOT BE USED TO ATTACH STEM TO DISC, NO PINS OR FASTENERS IN WATERWAY, ALUMINUM-BRONZE DISC, AND MOLDED-IN EPDM SEAT (LINER). ALL ELASTOMERIC SEALS SHALL HAVE LEAK DETECTION DESIGN.
- ACCEPTABLE VALVES: NIBCO PFD2000 SERIES (NSF-61)
- GD4765N-LF (NSF-61)

4. WARRANTY

A. EQUIPMENT, MATERIALS AND WORKMANSHIP FURNISHED UNDER THIS CONTRACT SHALL BE GUARANTEED BY THE CONTRACTOR FOR A PERIOD OF ONE YEAR FROM THE DATE OF FINAL ACCEPTANCE OF THE WORK BY THE OWNER. THE CONTRACTOR SHALL KEEP THE WORK IN GOOD REPAIR FOR ONE YEAR AFTER THE DATE OF FINAL APPROVAL. THE CONTRACTOR SHALL, AT HIS OWN EXPENSE, PROMPTLY CORRECT AND REPAIR ANY AND ALL BREAKS, FAILURES OR WEAR DUE TO FAULTY MATERIALS, WORKMANSHIP OR EQUIPMENT. ALL SETTLEMENTS OF SURFACES THAT MAY OCCUR WITHIN THAT PERIOD SHALL ALSO BE PROMPTLY REPAIRED.

ELECTRIC TANK TYPE WATER HEATER SCHEDULE

TAG No.	QUANTITY	TYPE	STORAGE (GALLONS)	RECOVERY (GPH)	TEMP RISE	ELECTRICAL REQUIREMENTS	MANUFACTURER & MODEL NO	REMARKS
WH-1	1	ELECTRIC, TANK TYPE	10	25	80°F	208V/1PH/60HZ 5KW	A.O.SMITH DEL-10	- DIMENSIONS 18.25"(HT) X 18"(DIA) - WEIGHT 54 LBS

EXPANSION TANK SCHEDULE

ITEM	QUANITITY	SERVICE	GALLONS	MAKE	REMARKS
EXPANSION TANK (ET-1)	1	HOT WATER	2	AMTROL ST-5C-DD	-DIMENSIONS- 14"(H) x 8"(DIA.) -SHIPPING WEIGHT- 10 LBS

PLUMBING FIXTURE SCHEDULE

MARK	FIXTURE	MANUFACTURER & MODEL	SAN.	VENT	C.W.	H.W.	REMARKS
WC	WATER CLOSET -TANK	AMERICAN STANDARD "CADET"	4"	2"	3/4"	-	LL TO INSTALL THE FIXTURE.
LAV	LAVATORY WALL-HUNG	AMERICAN STANDARD "LUCRENE"	2"	1-1/2"	1/2"	1/2"	LL TO INSTALL THE FIXTURE.
MS	MOP SINK	FIAT MSB2424	3"	2"	3/4"	3/4"	LL TO INSTALL THE FIXTURE.
DF	DRINKING FOUNTAIN	ELKAY LZS8WSLK	2"	1-1/2"	1/2"	-	LL TO INSTALL THE FIXTURE.
MV	THERMOSTATIC MIXING VAVLE POINT OF USE	WATTS LFMMV OR SIMILAR	-	-	1/2"	1/2"	-
FCO	FLOOR CLEAN OUT	JAY R. SMITH SERIES 4020 OR SIMILAR	AS NOTED	-	-	-	ADJUSTABLE ROUND OR SQUARE TOP
WHA	WATER HAMMER ARRESTOR	WATTS LF15M2 OR SIMILAR	-	-	1/2"	1/2"	-

Property of NY Engineers

PROJECT:
REDLINE ATHLETICS - FLEMINGTON NJ

DRAWING TITLE:
PLUMBING SPECIFICATIONS & SCHEDULES

SHEET:
P-002

GENERAL NOTES:

1. CW/HW PIPING TO BE PROVIDED WITH INSULATION AS PER ASHRAE 90.1 2019.
2. PROVIDE BRANCH PRV IF PRESSURE EXCEEDS 80 PSI.
3. PROVIDE WATER HAMMER ARRESTOR & SHUT-OFF VALVES AS REQUIRED PER CODE WITH ACCESS PANEL.
4. REFER RISER DIAGRAMS FOR ALL PIPE SIZES.
5. WATER HEATER DRAIN SPILLS TO THE MOP SINK.
6. CONTRACTOR SHALL CONFIRM EXISTING CONDITIONS PRIOR TO BID.
7. COORDINATE ALL MECHANICAL CONSTRUCTION WITH OTHER TRADES TO AVOID CONFLICTS.
8. CONFIRM LOCATIONS OF ALL EXISTING UTILITIES AND ADJUST ROUTING OF TENANT SYSTEMS AS REQUIRED.
9. EXISTING PLUMBING SERVICES (COLD WATER, HOT WATER, WASTE AND VENT) WHICH ARE NOT TO BE REUSED SHALL BE REMOVED BACK TO ACTIVE MAINS AND CAPPED. THERE SHALL BE NO "DEAD ENDS" LEFT IN PIPING SYSTEM.
10. WATER, SOIL AND WASTE PIPES SUBJECT TO FREEZING TEMPERATURE SHALL BE PROTECTED BY HEAT TRACING OR INSULATION OR BOTH.
11. VERIFY GAS SERVICE PRESSURE. IF HIGHER THAN 14" W.C., PROVIDE VENTLESS PRESSURE REGULATOR AT EACH APPLIANCE, SET OUTLET PRESSURE PER APPLIANCE MANUFACTURER'S INSTRUCTIONS.
12. GAS PIPING TO BE SCHEDULE 40 STEEL PIPE W/125 CAST IRON SCREWED FITTINGS.
13. GAS SYSTEM TO BE INSTALLED BY QUALIFIED LICENSED CONTRACTOR.
14. VERIFY ALL EQUIPMENT BTU'S PRIOR TO INSTALLATION. (6)
15. WATER HEATER IS LANDLORDS SCOPE OF WORK.

KEY NOTES: (#)

1. EXTEND AND CONNECT 3/4" CW TO EXISTING VALVED AND CAPPED CW STUB. CONTRACTOR TO FIELD VARIFY EXACT SIZE AND LOCATION.
2. PROVIDE AN ASSE 1070 THERMOSTATIC MIXING VALVE AT ALL LAVATORY. SET AT 110°F MAXIMUM.
3. 3/4" RPZ & WATER METER STACKED ABOVE MOP SINK.
4. EXISTING EQUIPMENT TO REMAIN WITH EXISTING GAS PIPING. CONTRACTOR TO FIELD VERIFY THE CONDITION OF EXISTING PIPING AND REPLACE IF REQUIRED.

WATER SUPPLY FIXTURE UNITS

SR. NO.	FIXTURE	QUANTITY	WSFU	TOTAL WSFU
1	LAVATORY	2	1	2
2	WATER CLOSET	2	2.5	5
3	MOP SINK	1	3	3
4	DRINKING FOUNTAIN	1	0.5	0.5
TOTAL				10.5

- AS PER 2021 NATIONAL STANDARD PLUMBING CODE TABLE 10.14.2B TOTAL GPM = 8.5 GPM (6)
- AS PER TABLE B.7.3.C. 3/4" DOMESTIC WATER LINE SIZED @8 PSI PER 100 FEET PRESSURE DROP CAN SUPPLY APPROX 12 GPM.

GAS LOAD AND SIZING SUMMARY:

1. LOAD SUMMARY

GUH-1(E)	=100 MBH
GUH-2(E)	=100 MBH
GUH-3(E)	=100 MBH
TOTAL	= 300 MBH


2. PIPE SIZING SUMMARY:

- 6" W.C. INLET PRESSURE
- 0.5" W.C. PRESSURE DROP
- 0.6 SPECIFIC GRAVITY
- 225 FT TOTAL EQUIV. LENGTH
- IFGC 2021 TABLE 402.4(2) SCHEDULE 40 METALLIC PIPE IS USED.


3. CONTRACTOR TO VERIFY PRESSURE AND PIPING LENGTHS ON SITE AND ADJUST PIPE SIZES IN ACCORDANCE WITH IFGC 2021 CHAPTER 4.

NATURAL GAS PIPING SYSTEM

PROVIDE A COMPLETE GAS PIPING SYSTEM TO SERVE GAS EQUIPMENT FURNISHED BY OTHERS, AS NOTED ON THE DRAWINGS. PROVIDE EITHER THREADED STEEL OR MALLEABLE IRON PIPE WITH MALLEABLE FITTINGS OR WELDED STEEL. PROVIDE ALL UNIONS, SHUT-OFF VALVES AND DIRT LEGS REQUIRED BY NFPA-54 AND GOVERNING LOCAL CODES AND AT EACH GAS APPLIANCE CONNECTION. PROVIDE ALL TESTS, METERS, INSPECTIONS, HANGERS AND EQUIPMENT CONNECTIONS REQUIRED FOR A COMPLETE AND OPERATING SYSTEM.

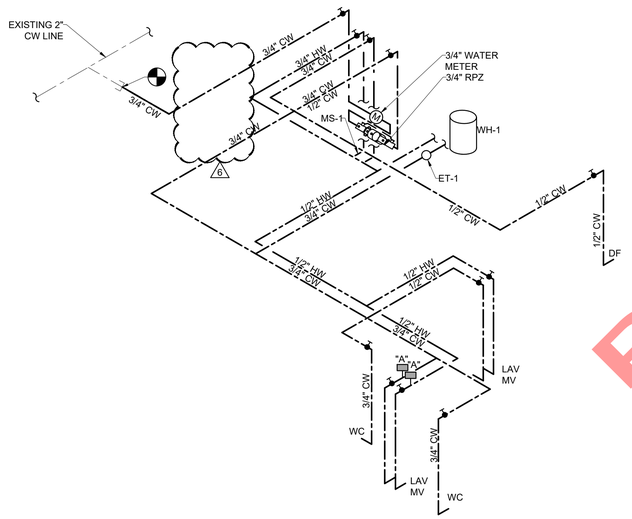

2 PLUMBING WATER SUPPLY RISER DIAGRAM
N.T.S.

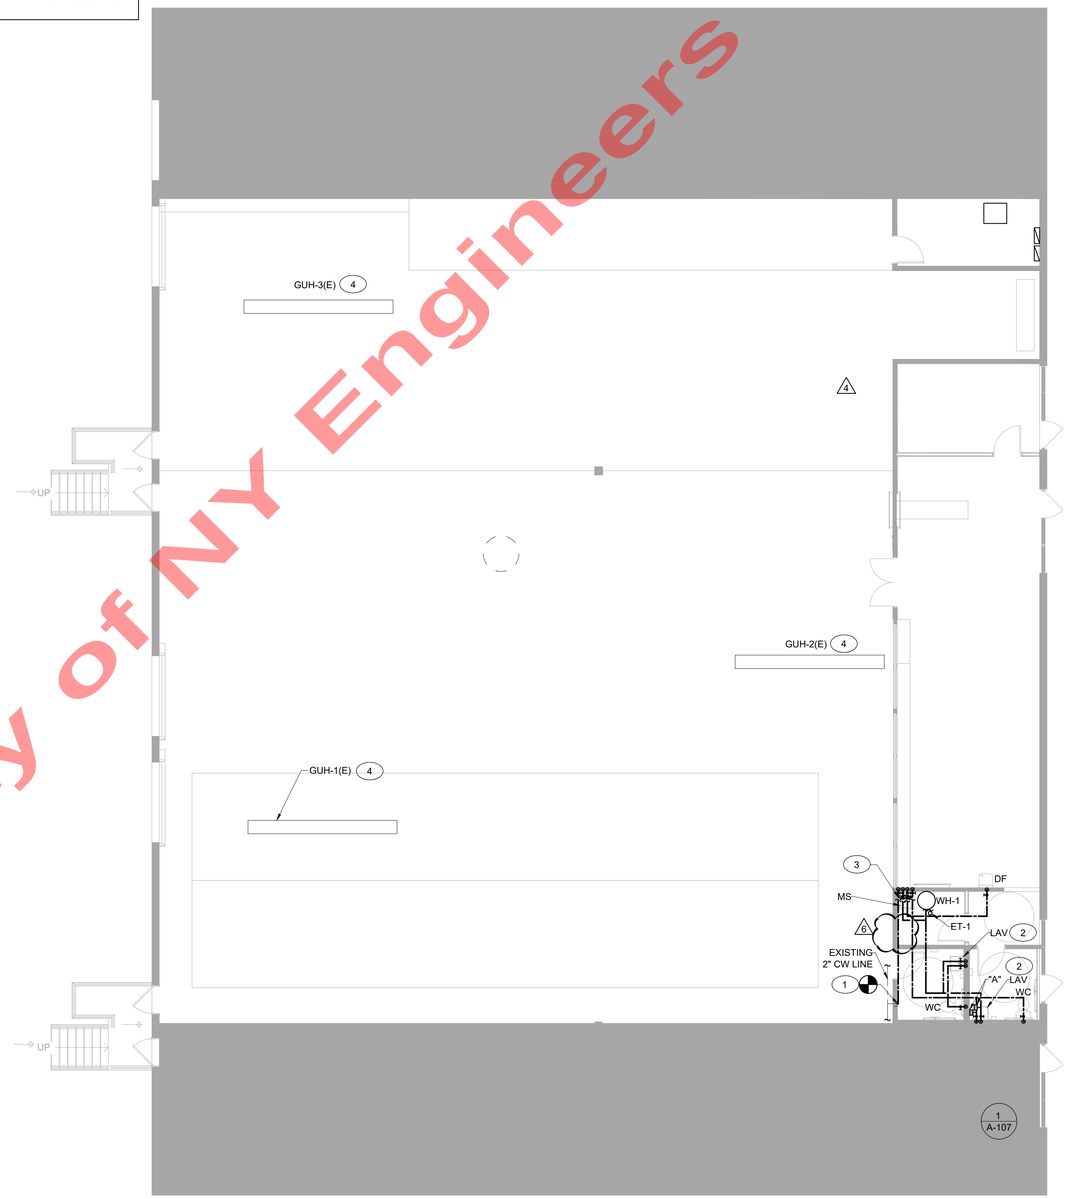

1 PLUMBING WATER & GAS SUPPLY FLOOR PLAN
SCALE: 1/8" = 1'-0"

Property of NY Engineers

PROJECT:
REDLINE ATHLETICS - FLEMINGTON NJ

DRAWING TITLE:
PLUMBING WATER & GAS SUPPLY FLOOR PLAN & WATER SUPPLY RISER

SHEET:
P-101

SANITARY GENERAL NOTES:

1. CONTRACTOR TO FIELD VERIFY FEASIBILITY OF SLAB PENETRATION AS PER STRUCTURAL REQUIREMENT.
2. REFER RISER DIAGRAM FOR ALL PIPE SIZES.
3. THE VENT SHALL RISE 6 INCHES VERTICALLY ABOVE THE FLOOD RIM LEVEL OF THE HIGHEST TRAP OR TRAPPED FIXTURE BEING VENTED.
4. CONTRACTOR SHALL CONFIRM EXISTING CONDITIONS PRIOR TO BID.
5. COORDINATE ALL MECHANICAL CONSTRUCTION WITH OTHER TRADES TO AVOID CONFLICTS.
6. CONFIRM LOCATIONS OF ALL EXISTING UTILITIES AND ADJUST ROUTING OF TENANT SYSTEMS AS REQUIRED.
7. RPZ DRAIN INDIRECTLY SPILLS TO MOP SINK.
8. EXISTING PLUMBING SERVICES (COLD WATER, HOT WATER, WASTE AND VENT) WHICH ARE NOT TO BE REUSED SHALL BE REMOVED BACK TO ACTIVE MAINS AND CAPPED. THERE SHALL BE NO "DEAD ENDS" LEFT IN PIPING SYSTEM.
9. THE AIR GAP BETWEEN THE INDIRECT WASTE PIPE AND THE FLOOD LEVEL RIM OF THE WASTE RECEPTOR MUST NOT BE LESS THAN TWICE OF THE EFFECTIVE OPENING OF THE INDIRECT WASTE PIPE.


SANITARY AND VENT KEY NOTES: (#)

1. CONNECT NEW 4" SANITARY WASTE PIPING TO EXISTING SANITARY WASTE LINE IN SPACE. CONTRACTOR TO FIELD VERIFY EXACT SIZE, INVERT ELEVATION AND LOCATION OF EXISTING PIPE ON SITE.
2. NEW 3" VENT THROUGH ROOF. CONTRACTOR TO MAINTAIN 10 FEET OF DISTANCE FROM ANY OUTSIDE AIR INTAKE.
3. CONDENSATE DRAIN: NEW INDIRECT CONDENSATE DRAIN FROM AC-1, AC-2, AC-3, DH-1 AND DH-2 TO THE NEAREST PLUMBING FIXTURE (MOP SINK/LAV). CONDENSATE PIPING SHALL MAINTAIN A SLOPE OF NOT LESS THAN 1%. CONDENSATE SHALL NOT DISCHARGE INTO A STREET, ALLEY OR OTHER AREAS SO AS TO CAUSE A NUISANCE.
4. CONNECT NEW 2" SANITARY WASTE PIPING TO EXISTING SANITARY WASTE LINE IN SPACE. CONTRACTOR TO FIELD VERIFY EXACT SIZE, INVERT ELEVATION AND LOCATION OF EXISTING PIPE ON SITE.

DRAINAGE FIXTURE UNITS

SR. NO.	FIXTURE	QUANTITY	DFU	TOTAL DFU
1	LAVATORY	2	1	2
2	WATER CLOSET	2	4	8
3	MOP SINK	1	2	2
4	DRINKING FOUNTAIN	1	0.5	0.5
5				
TOTAL				12.5

-DFU VALUES AS PER 2021 NATIONAL STANDARD PLUMBING CODE CHAPTER 11. TABLE NO 11.4.1

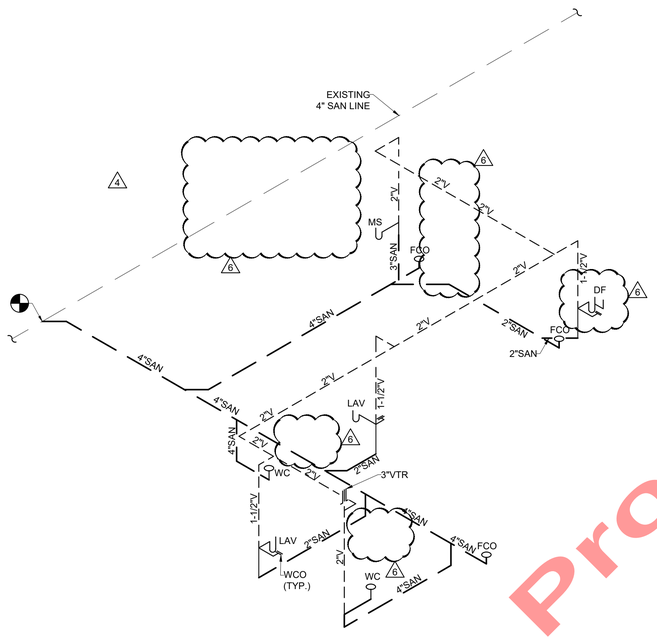

2 PLUMBING DRAINAGE RISER
N.T.S.



1 PLUMBING DRAINAGE FLOOR PLAN
SCALE: 1/8" = 1'-0"


Property of NY Engineers


PROJECT:
REDLINE ATHLETICS - FLEMINGTON NJ

DRAWING TITLE:
PLUMBING DRAINAGE FLOOR PLAN & RISER

SHEET:
P-102

Property of NY Engineers

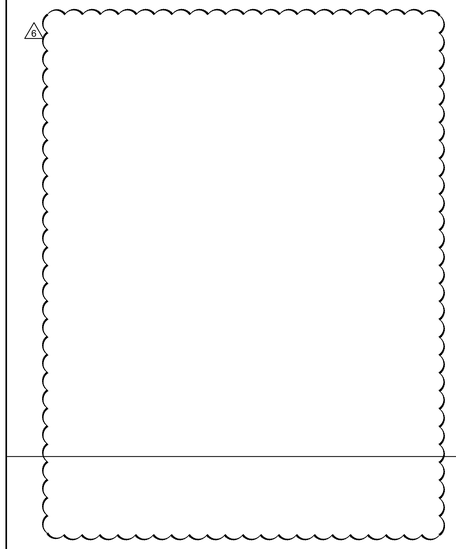

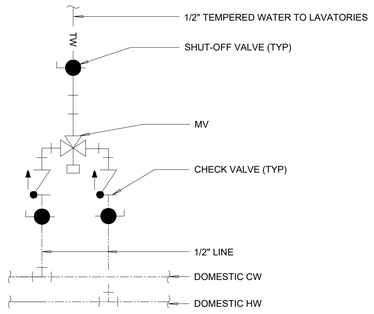



CONCEALED VALVES AND FITTINGS

- WRAP WITH 1-INCH THICK, 1-POUND DENSITY TO REQUIRED PIPE INSULATION THICKNESS
- SECURE WITH WIRE OR TAPE.
- VAPOR SEAL COLD WATER, CHILLED WATER AND STORM WATER PIPING.

CONCEALED VALVES AND FITTINGS

- PREMOLDED FIBER GLASS OR RADIAL MITERED PIPE INSULATION
- SKIM COAT OF INSULATION CEMENT
- COAT OF MASTIC
- WRAP WITH FIBER GLASS REINFORCING CLOTH.
- FINISH COAT OF MASTIC
- OVERLAP 2-INCHES ON PIPE INSULATION.

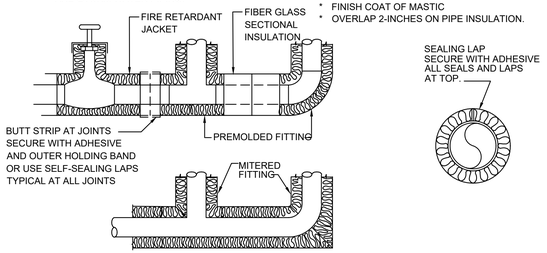

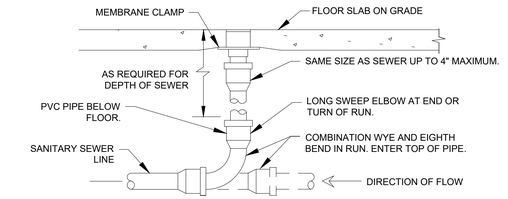


COMMENTS:


1. LOCATE AT BUILDING EXIT, AT ENDS OF RUNS, AT TURNS OF PIPE GREATER THAN 45 DEGREES, AT 50' INTERVALS ON STRAIGHT RUNS, AND/OR WHERE SHOWN ON PLANS. PROVIDE BACKFILL PER ARCHITECTURAL SPECIFICATIONS. LOCATE CLEANOUTS WHERE THERE IS 18" CLEAR AROUND. CONSULT LOCAL CODES FOR OTHER FCO REQUIREMENTS.
2. ROUND SECURED GASKETED NICKEL BRONZE ADJUSTABLE TOP WITH "CO" CAST IN COVER. PROVIDE CLEANOUT TOP WITH VARIATIONS SUITABLE FOR FLOOR COVERING (CARPET MARKER, RECESSED FOR TILE, SCORIATED FOR UNFINISHED FLOORS). PROVIDE PLASTIC PLUG BODY. USE TEFLON JOINT COMPOUND ON PLUG THREADS. CLEAN THE TOP OF EXPOSED FCO AFTER INSTALLATION.

2 THERMOSTATIC MIXING VALVE DETAIL
N.T.S.

3 INSULATION FOR EXPOSED AND CONCEALED LOCATIONS
N.T.S.

4 FLOOR CLEANOUT DETAIL
N.T.S.

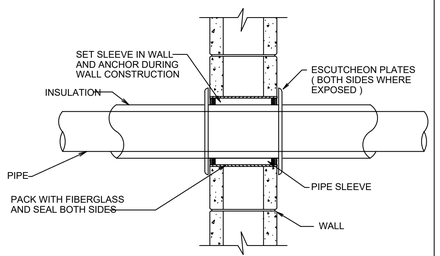

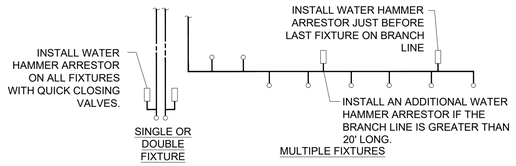


PDI SIZE	PIPE SIZE	FIXTURE UNIT LOAD
A	1/2"	1-11
B	3/4"	12-32
C	1"	33-60
D	1-1/4"	61-113
E	1-1/2"	114-154
F	2"	154-330


WATER SUPPLY FIXTURE UNIT (WSFU)		
FIXTURE	COLD	HOT
VALVE WATER CLOSET	5	--
URINAL	4	--
LAVATORY/SINK	1.5	1.5
JANITOR'S SINK	3	3

COMMENTS:

1. WATER HAMMER ARRESTERS SHALL BE HAVE PISTON AND 0-RING CONSTRUCTION WITH PDI #WH-201, ASSE # 1010 AND ANSI # A112.26.1M CERTIFICATION. INSTALL IN HORIZONTAL OR VERTICAL POSITION, BUT NEVER UPSIDE DOWN. SIZE THE UNITS AS SHOWN PER THE TABLES SHOWN ABOVE.

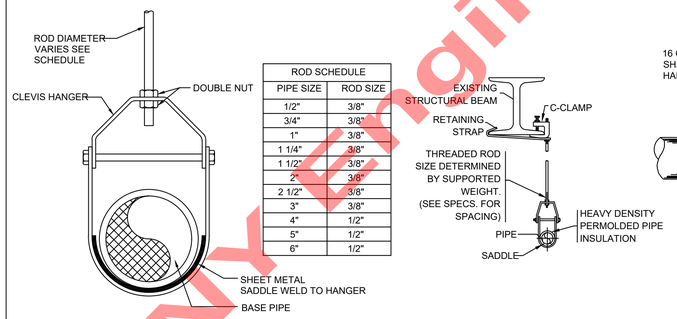


ROD SCHEDULE	
PIPE SIZE	ROD SIZE
1/2"	3/8"
3/4"	3/8"
1"	3/8"
1 1/4"	3/8"
1 1/2"	3/8"
2"	3/8"
2 1/2"	3/8"
3"	3/8"
4"	1/2"
5"	1/2"
6"	1/2"

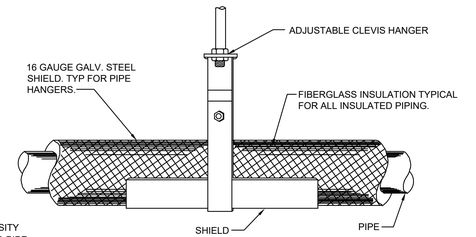


5 PIPE SLEEVE THRU WALL SECTION
N.T.S.

6 WATER HAMMER ARRESTOR DETAIL
N.T.S.

7 HANGER DETAIL
N.T.S.

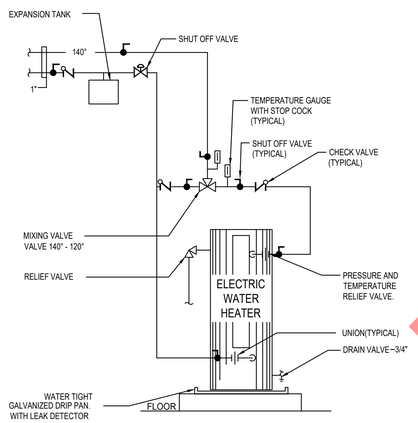

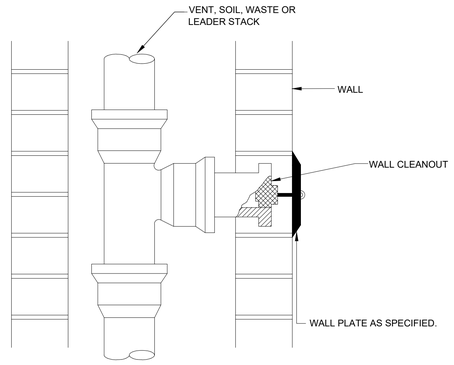

8 ELECTRIC TANK WATER HEATER
N.T.S.

9 WALL CLEANOUT DETAIL
N.T.S.

PROJECT:
REDLINE ATHLETICS - FLEMINGTON NJ

DRAWING TITLE:
PLUMBING DETAILS

SHEET:
P-201

SWITCHES AND CONTROLS

S_a	20A SPST SWITCH U.O.N. "a" DENOTES SWITCH'S TAG
S_{OS}	WALL OCCUPANCY SENSOR SWITCH
S_{MO}	MANUAL OVERRIDE SWITCH
S^2_a	TWO WAY MANUAL SWITCH U.O.N. "a" DENOTES SWITCH'S TAG

WIRING SYSTEMS

----------	EXISTING
————	NEW

ANNOTATION

+24"	INDICATES MOUNTING HEIGHT CENTER LINE TO FINISHED FLOOR.
(#)	KEYED NOTE REFERENCE

POWER DISTRIBUTION

	DISTRIBUTION PANELBOARD, SURFACE OR FLUSH MOUNTED.
TC	TIME CLOCK

ELECTRICAL DRAWING LIST

E-001	ELECTRICAL SYMBOL LIST, ABBREVIATIONS & GENERAL NOTES
E-002	ELECTRICAL SPECIFICATIONS (1 OF 2)
E-003	ELECTRICAL SPECIFICATIONS (2 OF 2)
E-101	LIGHTING PLAN
E-201	ELECTRICAL POWER PLAN
E-301	ELECTRICAL DETAILS
E-401	ELECTRICAL PANEL SCHEDULES & RISER DIAGRAM

POWER AND TELECOMMUNICATION

J	ELECTRICAL JUNCTION BOX
	DUPLEX RECEPTACLE, +18" AFF OR AS NOTED.
	QUAD RECEPTACLE
GFI	GFI DUPLEX RECEPTACLE
FL	FLOOR MOUNTED QUAD RECEPTACLE
CL	CEILING MOUNTED QUAD RECEPTACLE
IG	ISOLATED GROUNDING TYPE QUAD RECEPTACLE
IG	ISOLATED GROUNDING TYPE DUPLEX RECEPTACLE
▽	DATA OUTLET
▼	TELEPHONE/DATA OUTLET

MOTORS AND CONTROLS

M	MOTOR AS NOTED WITH LIQUID TIGHT FLEXIBLE CONNECTION WITH JUNCTION BOX AND MOTOR SWITCH.
A	30A NON FUSED DISCONNECT SWITCH, POLES AS NOTED.
B	60A NON FUSED DISCONNECT SWITCH, POLES AS NOTED.
C	100A NON FUSED DISCONNECT SWITCH, POLES AS NOTED.
D	200A NON FUSED DISCONNECT SWITCH, POLES AS NOTED.
S_M	MANUAL MOTOR SWITCH

ELECTRICAL ABBREVIATIONS

A	AMPERES
A/C, AC	AIR CONDITIONING UNIT
AF	AMPERE FRAME/AMP FUSE
AFF	ABOVE FINISHED FLOOR
AS	AMP SWITCH
AIC	AMPS INTERRUPTING CAPACITY
AUTO	AUTOMATIC
AWG	AMERICAN WIRE GAUGE
C	CONDUIT
C/B,CB	CIRCUIT BREAKER
CKT	CIRCUIT
CLG	CEILING
COMM	COMMUNICATION
CT	CURRENT TRANSFORMER
CU	COPPER
°C	DEGREE CELSIUS
°F	DEGREE FAHRENHEIT
DIA	DIAMETER
DISC	DISCONNECT
DN	DOWN
DWG	DRAWING
JB	JUNCTION BOX
KCMIL	ONE THOUSAND CIRCULAR MILS
KV	KILOVOLT
KVA	KILOVOLT-AMPERES
KW	KILOWATTS
LP	LIGHTING PANEL
LTG	LIGHTING
MAX	MAXIMUM
MC	MOTOR CONTROLLER
MCB	MAIN CIRCUIT BREAKER
MER	MECHANICAL EQUIPMENT ROOM
MIN	MINIMUM
MLO	MAIN LUGS ONLY
MTD	MOUNTED
N	NEUTRAL
NE	NEW DEVICE TO REPLACE EXISTING
NIC	NOT IN CONTRACT
NL	NIGHT LIGHT
NTS	NOT TO SCALE
OC	ON CENTER
P	POLES
PB	PULLBOX
PC	PERSONAL COMPUTER
Ø	PHASE
PNL	PANEL
W	WATT
W	WIRE
WH	WALL HEATER
E	EXISTING
TC	TIME CLOCK
EA	EACH
EC	EMPTY CONDUIT/ ELECTRICAL CONTRACTOR
EF	EXHAUST FAN
EM	EMERGENCY
EMT	ELECTRICAL METALLIC TUBING
EQUIP	EQUIPMENT
ER	EXISTING TO BE RELOCATED
ETR	EXISTING TO REMAIN
EWF	ELECTRIFIED WORKSTATION FURNITURE
EWH	ELECTRIC WATER HEATER
FA	FIRE ALARM
FBO	FURNISHED BY OTHERS, INSTALLED & WIRED BY EC
FDR	FEEDER
FIBO	FURNISHED & INSTALLED BY OTHERS, WIRED BY EC
FIXT	FIXTURE
FL	FLOOR
FLUOR	FLUORESCENT
G	GROUND
GFI	GROUND FAULT INTERRUPTER
GP	GENERAL PURPOSE
HC	HUNG CEILING
HP	HORSEPOWER
HWH	HOW WATER HEATER
HZ	HERTZ
IC	INTERRUPTING CAPACITY
PP	POWER PANEL
PVC	POLYVINYL CHLORIDE
PWR	POWER
R	REMOVE
RE	RELOCATED EXISTING
REC	RECEPTACLE
RR	REMOVE & RELOCATE
SECT	SECTION
SPDT	SINGLE POLE DOUBLE THROW
SPST	SINGLE POLE SINGLE THROW
SPEC	SPECIFICATION
SW	SWITCH
SWBD	SWITCHBOARD
SYM	SYMMETRICAL
SYS	SYSTEMS
TELE	TELEPHONE
TEMP	TEMPERATURE
TXF	TOILET EXHAUST FAN
TYP	TYPICAL
UON	UNLESS OTHERWISE NOTED
V	VOLT/VOLTAGE
VA	VOLT AMPERE
VFD	VARIABLE FREQUENCY DRIVE
WP	WEATHER PROOF
XFMR	TRANSFORMER
IG	ISOLATED GROUND
TR	TAMPER RESISTANCE

GENERAL NOTES

(APPLY TO ALL "E" DRAWINGS)

1. ALL WORK SHALL BE PERFORMED IN STRICT ACCORDANCE WITH THE 2020 NATIONAL ELECTRICAL CODE WITH NEW JERSEY AMENDMENTS , LOCAL JURISDICTION REQUIREMENTS, AND ALL GOVERNING LOCAL CODES, LAWS, AND REGULATIONS.
2. CONTRACTOR SHALL VISIT THE SITE AND BECOME FAMILIAR WITH ALL EXISTING CONDITIONS THAT MAY AFFECT THE WORK. NO ADDITIONAL COMPENSATION WILL BE CONSIDERED FOR FAILURE TO DO SO.
3. CONTRACTOR SHALL OBTAIN AND PAY FOR ALL PERMITS, TEST REPORTS, AND CERTIFICATIONS FOR TEMPORARY AND FINAL CERTIFICATE OF OCCUPANCY.
4. FIRE STOP ALL PENETRATIONS OF FIRE RATED CONSTRUCTION IN A CODE APPROVED MANNER IN ORDER TO MAINTAIN FIRE RATING. ALL PENETRATIONS SHALL BE SLEEVED AND SEALED WATERTIGHT.
5. SECURE ALL SUPPORTS TO BUILDING STRUCTURE UTILIZING TOGGLE BOLTS (HOLLOW MASONRY), EXPANSION SHIELDS OR INSERTS (CONCRETE AND BRICK), MACHINE SCREWS (METAL), BEAM CLAMPS (FRAMEWORK), WOOD SCREWS (WOOD) OR PAN THRU STRAPS (METAL DECK). NAILS, RAWL PLUGS AND WOOD PLUGS ARE NOT PERMITTED. WHERE REQUIRED BY STRUCTURE, PROVIDE THRU BOLTS AND FISH PLATES. SUPPORT HORIZONTAL RUNS OF METALLIC RACEWAYS NOT MORE THAN 10 FT APART. SUPPORT RACEWAY RISERS AT EACH FLOOR LEVEL. RUN EXPOSED RACEWAYS PARALLEL WITH OR AT RIGHT ANGLES TO WALLS.
6. LEAVE WIRES WITH SUFFICIENT SLACK TO PERMIT MAKING FINAL CONNECTIONS. RACEWAYS OVER 10 FT LONG IN WHICH WIRING IS NOT INSTALLED. FURNISH FISH WIRE.
7. VERIFY LOCATIONS OF OUTLETS AND SWITCHES IN FINISHED ROOMS WITH ARCHITECTURAL DRAWINGS OF INTERIOR DETAILS AND FINISH. IN CENTERING OUTLETS AND LOCATING BOXES AND OUTLETS, ALLOW FOR OVERHEAD PIPES, DUCTS AND MECHANICAL EQUIPMENT, EQUIPMENT, VARIATIONS IN FIREPROOFING AND PLASTERING, WINDOW AND DOOR TRIM, PANELING, HUNG CEILINGS AND THE LIKE. CORRECT ANY INACCURACY RESULTING FROM FAILURE TO DO SO WITHOUT EXPENSE TO OWNER.
8. CONTRACTOR SHALL PROVIDE A WARRANTY ON ALL MATERIALS, EQUIPMENT, AND WORKMANSHIP FOR A PERIOD OF ONE YEAR FROM THE DATE OF FINAL ACCEPTANCE.
9. ALL UNUSED MATERIALS AND DEBRIS SHALL BE LEGALLY REMOVED AND DISPOSED OF AWAY FROM THE PREMISES ON A DAILY BASIS.
10. CONTRACTOR SHALL PATCH, PAINT, AND RESTORE EXISTING SURFACES DAMAGED DURING THE COURSE OF THIS CONSTRUCTION TO PRE-EXISTING CONDITIONS OR BETTER.
11. MINIMUM SIZE OF CONDUIT SHALL BE ¾", AND TYPE SHALL BE ELECTRICAL METALLIC TUBING (EMT), UNLESS OTHERWISE NOTED. PROVIDE NYLON DRAG LINE AND CONDUIT CAP FOR ALL EMPTY CONDUITS.
12. CONNECT CONDUIT TO MOTOR CONDUIT TERMINAL BOXES WITH FLEXIBLE CONDUIT (MINIMUM 18 IN. LENGTH AND 50% SLACK). DO NOT TERMINATE IN OR FASTEN RACEWAYS TO MOTOR FOUNDATION.
13. PULL AND JUNCTION BOXES WHERE INDICATED ON THE DRAWINGS, SHALL BE CONSIDERED SHOWN AT THEIR APPROXIMATE LOCATION. THE CONTRACTOR SHALL LOCATE THEM AS FIELD CONDITIONS DICTATE. ADDITIONAL PULL AND JUNCTION BOXES NOT SHOWN ON DRAWINGS SHALL BE PROVDED WHERE REQUIRED BY APPLICABLE CODE PROVISIONS OR WHERE CALLED FOR BY FIELD CONDITIONS. PULL AND JUNCTION BOXES SHALL BE SURFACE TYPE IN UNFINISHED AREAS AND INSTALLED CANCEALED IN FINISHED AREAS, AND ALL COVERS TO PULL & JUNCTION BOXES SHALL BE READILY ACCESSIBLE.
14. SUPPORT PANEL, JUNCTION AND PULLBOXES INDEPENDENTLY TO BUILDING STRUCTURE WITH NO WEIGHT BEARING ON RACEWAYS.
15. FOR EXACT LOCATION AND MOUNTING HEIGHT OF LIGHTING FIXTURES AND SWITCH/RECEPTACLE OUTLETS, REFER TO ARCHITECTURAL REFLECTED CEILING AND POWER PLANS.
16. ALL ELECTRICAL ACCESSORIES AND EQUIPMENT INSTALLED OUTSIDE OR EXPOSED TO WEATHER SHALL HAVE NEMA 3R ENCLOSURES AND SHALL BE TIGHTLY GASKETED FOR A COMPLETE RAINTIGHT INSTALLATION. ALL BUILDING EXTERIOR MOUNTED RECEPTACLES SHALL BE GFCI RATED AND MOUNTED IN WEATHERPROOF ENCLOSURE.
17. ALL ACCESS PANEL LOCATIONS SHALL BE REVIEWED BY ARCHITECT PRIOR TO INSTALLATION.
18. ELECTRICAL CONTRACTOR SHALL COORDINATE THE LOCATION AND INSTALLATION OF NEW WORK WITH THE GENERAL CONTRACTOR AND OTHER ASSOCIATED TRADES IN A TIMELY MANNER. THE CONTRACTOR IS RESPONSIBLE FOR FIELD VERIFYING ALL DIMENSIONS AND CONDITIONS PRIOR TO CONSTRUCTION. REFER TO ALL GENERAL, MECHANICAL, AND ELECTRICAL, DRAWINGS AND SPECIFICATIONS FOR THIS PROJECT.
19. ALL CONDUITS AND EQUIPMENT TO BE CONCEALED IN FINISHED SPACES UNLESS OTHERWISE NOTED. CONDUITS SHALL BE ENCASED IN THE CONCRETE FLOOR SLAB.
20. ALL EQUIPMENT AND MATERIALS INSTALLED IN PLENUM CEILINGS SHALL BE APPROVED FOR THAT APPLICATION.
21. OUTLET BOXES AND JUNCTION BOXES ON OPPOSITE SIDES OF FIRE-RATED WALLS SHALL BE SEPARATED BY A HORIZONTAL DISTANCE OF NOT LESS THAN 24 INCHES, UNLESS FIRE-RATED BOXES OR PUTTY PADS ARE UTILIZED.
22. COORDINATE ALL FLOOR PENETRATIONS WITH THE STRUCTURAL AND ARCHITECTURAL DRAWINGS. CONFIRM PENETRATION LOCATIONS WITH THE ENGINEER AND OWNER BEFORE INSTALLATION.
23. COORDINATE THE MOUNTING HEIGHT AND LOCATION OF RACEWAYS, COMMUNICATIONS OUTLETS, AND RECEPTACLES WITH THE ARCHITECTURAL CASEWORK DRAWINGS AND DETAILS. COORDINATE LOCATIONS OF LIGHT FIXTURES, SWITCHES, AND RELATED DEVICES WITH THE ARCHITECTURAL DRAWINGS AND DETAILS.
24. REFER TO ARCHITECTURAL PLANS FOR FINAL LOACTIONS OF ALL LUMINARIES AND SWITCHES, AND FOR ALL FINISHED CEILING HEIGHTS.
25. REFER TO ARCHITECTURAL PLANS FOR FINAL LOCATIONS OF ALL ELECTRICAL DEVICES, AND FOR FINAL CEILING AND WALL HEIGHTS AND LAYOUTS.
26. LIGHTING FIXTURES PROVIDED WITH EMERGENCY BATTERY PACKS AND INDICATED WITH SWITCH CONTROL SHALL BE WIRED WITH BATTERY CHARGING/SENSING CIRCUIT WIRED AHEAD OF SWITCH CONTROL.
27. NUMBER(S) SHOWN AT RECEPTACLES, JUNCTION BOXES AND EQUIPMENT INDICATES CIRCUIT NUMBERS IN PANELBOARD. PROVIDE WIRE AND CONDUIT TO INTERCONNECT EQUIPMENT AND DEVICES WITH SAME CIRCUIT NUMBERS AND RUN TO PANELBOARD.

Property of NY Engineers

PROJECT:
REDLINE ATHLETICS - FLEMINGTON NJ

DRAWING TITLE:
ELECTRICAL SYMBOL LIST, ABBREVIATIONS & GENERAL NOTES

SHEET:
E-001

ELECTRICAL SPECIFICATION

1. GENERAL:

A. THE "GENERAL CONDITIONS OF THE CONTRACT FOR CONSTRUCTION," AIA DOCUMENT, LATEST EDITION, AND THESE SPECIFICATIONS AS APPLICABLE ARE PART OF THIS CONTRACT.

B. DRAWING ARE DIAGRAMMATIC AND INDICATE GENERAL ARRANGEMENT OF SYSTEMS AND WORK. CONDUIT ROUTING IS SHOWN DIAGRAMMATICALLY AND DOES NOT SHOW ALL OFFSETS, DROPS AND RISES OF RUNS. THE CONTRACTOR SHALL ALLOW IN HIS PRICE FOR ROUTING OF CONDUIT TO AVOID OBSTRUCTIONS. COORDINATION WITH EXISTING SERVICES, INCLUDING THOSE OF OTHER TRADES, IS REQUIRED, MAINTAIN HEADROOM AND SPACE CONDITIONS.

C. BIDDERS, BEFORE SUBMITTING PROPOSALS, SHALL VISIT AND CAREFULLY EXAMINE THE AREA AFFECTED BY THIS WORK TO FAMILIARIZE THEMSELVES WITH THE EXISTING CONDITIONS AND THE DIFFICULTIES THAT WILL ATTEND THE EXECUTION OF THIS WORK. SUBMISSION OF A PROPOSAL WILL BE CONSTRUED AS EVIDENCE THAT SUCH AN EXAMINATION HAS BEEN MADE, AND LATER CLAIMS WILL NOT BE RECOGNIZED FOR EXTRA LABOR, EQUIPMENT, OR MATERIALS, REQUIRED BECAUSE OF DIFFICULTIES ENCOUNTERED WHICH COULD HAVE BEEN FORESEEN HAD SUCH AN EXAMINATION BEEN MADE.

D. INSTALL WORK SO AS TO BE READILY ACCESSIBLE FOR OPERATION, MAINTANANCE AND REPAIR, MINOR DEVIATIONS FROM DRAWING MAY BE MADE TO ACCOMPLISH THIS, BUT CHANGES WHICH INVOLVE EXTRA COST SHALL NOT BE MADE WITHOUT APPROVAL.

E. REMOVAL AND RELOCATION OF CERTAIN EXISTING WORK MAY BE NECESSARY FOR THE PERFORMANCE OF THE GENERAL WORK. ALL EXISTING CONDITIONS CANNOT BE COMPLETELY DETAILED ON THE DRAWINGS. THE CONTRACTOR SHALL SURVEY THE SITE AND INCLUDE ALL CHANGES AND CHARGES IN MAKING UP THE WORK PROPOSAL.

F. CONNECTIONS TO EXISTING WORK: INSTALL NEW WORK AND CONNECT TO EXISTING WORK WITH MINIMUM INTERFERENCE TO EXISTING FACILITIES. TEMPORARY SHUTDOWNS OF EXISTING SERVICES SHALL BE PERFORMED AT NO ADDITIONAL CHARGES. AT TIMES NOT TO INTERFERE WITH NORMAL OPERATION OF EXISTING FACILITIES AND ONLY WITH WRITTEN CONSENT OF OWNER. ALARM AND EMERGENCY SYSTEMS SHALL NOT BE INTERRUPTED. MAINTAIN CONTINUOUS OPERATION OF EXISTING FACILITIES AS REQUIRED WITH NECESSARY TEMPORARY CONNECTIONS BETWEEN NEW AND EXISTING WORK. CONNECT NEW WORK TO EXISTING WORK IN NEAT AND ACCEPTABLE MANNER. RESTORE EXISTING DISTURBED WORK TO ORIGINAL CONDITION, INCLUDING MAINTENANCE OF WIRING CONTINUITY AS REQUIRED.

G. DISCONNECT, REMOVE AND/OR RELOCATE EXISTING MATERIAL, EQUIPMENT AND OTHER WORK AS NOTED OR REQUIRED FOR PROPER INSTALLATION OF NEW WORK.

H. THE CONTRACTOR SHALL KEEP ALL EQUIPMENT AND MATERIALS, AND ALL PARTS OF THE BUILDING EXTERIOR SPACES AND ADJACENT STREETS, SIDEWALKS AND PAVEMENTS, FREE FROM MATERIAL AND DEBRIS RESULTING FROM THE EXECUTION OF THIS WORK. EXCESS MATERIALS WILL NOT BE PERMITTED TO ACCUMULATE EITHER ON THE INTERIOR OR THE EXTERIOR.

I. SEAL OPENINGS THROUGH PARTITIONS, WALLS AND FLOORS WITH MINERAL WOOL OR OTHER NONCOMBUSTIBLE MATERIAL, UNLESS OTHERWISE NOTED.

J. PROVIDE ALL NECESSARY FLASHING AND COUNTER FLASHING TO MAINTAIN THE WATERPROOFING INTEGRITY OF THE BUILDING AS REQUIRED BY THE INSTALLATION OR REMOVAL OF CONDUIT AND EQUIPMENT, PROVIDE EQUIPMENT CURBS AS REQUIRED.

K. ALL EXISTING MATERIAL, EQUIPMENT AND CONSTRUCTION DEBRIS TO BE REMOVED UNDER THIS CONTRACT SHALL BECOME THE PROPERTY OF THE CONTRACTOR WITH THE EXCEPTION OF SPECIFIC EQUIPMENT ND APPARATUS REQUESTED BY THE BUILDING REPRESENTATIVE, ARCHITECT OR AS NOTED TO BE RELOCATED ON THE DRAWINGS. REMOVED EQUIPMENT SHALL BE PROPERLY DISPOSED OF BY THIS CONTRACTOR.

L. THE CONTRACTOR'S PROPOSAL FOR ALL WORK SHALL BE PREDICATED ON THE PERFORMANCE OF THE WORK DURING REGULAR WORKING HOURS. WHEN SO DIRECTED, HOWEVER, THE CONTRACTOR SHALL INSTALL WORK DURING OVERTIME HOURS AND THE ADDITIONAL COST TO BE CHARGED THEREFORE SHALL BE ONLY THE "PREMIUM" PORTION OF THE WAGES PAID.

M. UNLESS OTHERWISE SPECIFICALLY NOTED OR SPECIFIED, INCLUDE ALL CUTTING AND PATCHING OF EXISTING FLOORS, WALLS, PARTITIONS AND OTHER MATERIALS IN THE EXISTING BUILDING. THE CONTRACTOR SHALL RESTORE THESE AREAS TO ORIGINAL CONDITION.

N. ALL MATERIAL AND EQUIPMENT SHALL BE NEW UNLESS OTHERWISE NOTED AND SHALL BE IN ACCORDANCE WITH BUILDING STANDARDS.

O. INSURANCE: PROVIDE IN ACCORDANCE WITH OWNER/BUILDING REQUIREMENTS AND SHALL INCLUDE A HOLD HARMLESS CLAUSE FOR OWNER AND ENGINEER.

P. THE FINAL ACCEPTANCE SHALL BE MADE AFTER THE CONTRACTOR HAS ADJUSTED HIS EQUIPMENT, TESTED THE VARIOUS SYSTEMS, DEMONSTRATED THAT IT FULFILLS THE REQUIREMENTS OF THE DRAWINGS AND SPECIFICATIONS AND HAS FURNISHED ALL THE REQUIRED CERTIFICATED OF INSPECTION AND APPROVAL.

2. 2. GENERAL PROVISIONS FOR ELECTRICAL WORK:

A. DEFINITIONS:

1) "PROVIDE": TO FURNISH, INSTALL AND CONNECT UP COMPLETE AND READY FOR SAFE AND REGULAR OPERATION THE PARTICULAR WORK REFERRED TO UNLESS SPECIFICALLY OTHERWISE NOTED.

2) "INSTALL": TO ERECT, MOUNT AND CONNECT COMPLETE WITH RELATED ACCESSORIES.

3) "FURNISH" OR "SUPPLY": TO PURCHASE, PROCURE, ACQUIRE. AND DELIVER COMPLETE WITH RELATED ACCESSORIES.

4) "WORK": LABOR, MATERIALS, EQUIPMENT, APPARATUS, CONTROLS, ACCESSORIES AND OTHER ITEMS REQUIRED FOR PROPER AND COMPLETE INSTALLATION.

5) "WIRING": RACEWAY. FITTINGS, WIRE, BOXES, AND RELATED ITEMS.

6) "CONCEALED": EMBEDDED IN MASONRY OR OTHER CONSTRUCTION, INSTALLED IN FURRED SPACES, WITHIN DOUBLE PARTITIONS OR HUNG CEILINGS, IN TRENCHES, IN CRAWL SPACES, OR IN ENCLOSURES

7) "EXPOSED": NOT INSTALLED UNDERGROUND OR "CONCEALED" AS DEFINED ABOVE.

8) "SIMILAR" OR "EQUAL": EQUAL IN MATERIALS, WEIGHT, SIZE, DESIGN AND EFFICIENCY OF SPECIFIED PRODUCT.

B. TEMPORARY LIGHT AND POWER: PROVIDE TEMPORARY LIGHT AND POWER SYSTEMS AT EARLIEST POSSIBLE DATE WITHIN THE CONSTRUCTION AREAS FOR THE REQUIREMENTS OF ALL TRADES AS HEREIN DESCRIBED. EXTEND SYSTEMS TO NEW CONSTRUCTION AS SOON AS PHYSICALLY POSSIBLE. MAINTAIN SYSTEM DURING WORKING OWNER. PROVIDE ALL REQUIRED MAINTENANCE, INCLUDING LAMPS AND SOCKETS.

C. QUALITY ASSURANCE

1) QUALITY OF MATERIALS: ALL EQUIPMENT SHALL BE NEW SPECIFICATION GRADE, FREE FROM DEFECTS AND LISTED BY APPROVED TESTING AGENCY AND BEARING THEIR LABEL MATERIALS AND EQUIPMENT OF SIMILAR APPLICATION SHALL BE OF SAME MANUFACTURER, EXCEPT AS NOTED.

2) GUARANTEE: ALL MATERIALS AND WORKMANSHIP SHALL BE GUARANTEED AS DEFINED IN PARAGRAPH 2.C.

3) CURRENT CHARACTERISTICS:

a. DISTRIBUTION: 120/208 VOLT, 3 PHASE, 4 WIRE, 60 HERTZ WITH GROUNDED NEUTRAL.

4) HEIGHTS OF OUTLETS:

a. FROM FINISHED FLOOR TO CENTERLINE OF OUTLETS FOR:

- RECEPTACLES AND TELEPHONES: 1 FT-6 IN.
- WALL SWITCHES: 4 FT-0 IN.
- WALL FIXTURES: 7 FT-0 IN.
- MOTOR CONTROLLERS: 5 FT-0 IN.
- CLOCKS: 7 FT 6 IN

b. EXCEPTIONS: AT JUNCTION OF DIFFERENT WALL FINISH MATERIALS, ON MOLDING OR BREAK IN WALL SURFACE, IN VIOLATION OF CODE, OR AS NOTED OR DIRECTED.

D. PRODUCT DELIVERY, STORAGE AND HANDLING

1) MOVING OF EQUIPMENT: WHERE NECESSARY, SHIP IN CARTED SECTIONS OF SIZE TO PERMIT PASSING THROUGH AVAILABLE SPACES.

2) ACCESSIBILITY: FOR OPERATION, MAINTENANCE AND REPAIR. MINOR DEVIATIONS SHALL BE PERMITTED, CHANGES OF MAGNITUDE OR INVOLVING EXTRA COST ARE NOT PERMISSIBLE WITHOUT REVIEW. GROUP CONCEALED ELECTRICAL EQUIPMENT REQUIRING ACCESS WITH EQUIPMENT FREELY ACCESSIBLE THROUGH ACCESS DOORS.

E. MATERIALS

1) NAMEPLATES: PROVIDE BLACK LAMICOID SHEET WITH 3/4 IN. WHITE LETTERING, FASTENED WITH EPOXY CEMENT FOR EACH DISCONNECT SWITCH, CIRCUIT BREAKER, PANEL, CABINET, TRANSFORMER, ENCLOSURE, MOTOR CONTROLLER AND THE LIKE. NAMPLATES SHALL DESCRIBE THE NAME AND NUMBER OF EACH COMPONENT.

2) CABLE TAGS: TAG EACH CONDUCTOR PASSING THROUGH SPLICE OR PULLBOX WITH A WHITE LINEN TAG, INDICATING POINT OF ORIGIN AND TERMINATION OF THE CIRCUIT.

3) INSERTS AND SUPPORTS:

a. INSERTS: STEEL, SLOTTED TYPE, FACTORY PAINTED.

- SINGLE ROD: SIMILAR TO GRINNELL FIG. 281.
- MULTI-ROD: SIMILAR TO FEE AND MASON SERIES 9000 WITH END CAPS AND CLOSURE STRIPS.
- CLIP FORM NAILS FLUSH WITH INSERTS.
- MAXIMUM LOADING 75 PERCENT OF RATING.

b. SUPPORTS FROM BUILDING CONSTRUCTION: INSERTS, BEAM CLAMPS, STEEL FISHPLATES (IN CONCRETE FILL ONLY), CANTILEVER BRACKETS OR OTHER MEANS. SUBMIT FOR REVIEW.

c. GROUPED LINES AND SERVICES: TRAPEZE HANGERS OF BOLTED ANGLES OR CHANNELS.

d. WHERE BUILDING CONSTRUCTION IS INADEQUATE: PROVIDE ADDITIONAL FRAMING. SUBMIT FOR REVIEW.

F. PAINT SHALL BE THE BEST GRADE FOR ITS PURPOSE. DELIVER INORIGINAL SEALED CONTAINERS AND APPLY IN ACCORDANCE WITH MANUFACTURER'S INSTRUCTIONS. COLORS SHALL BE AS SELECTED BY ARCHITECT OR ENGINEER. UTILIZE GALVANIZED IRON PRIMER ON PANEL AND PULL BOXES, AFTER FABRICATION. UTILIZE HOT DIPPED GALVANIZED OR DIPPED IN ZINC BASED PRIMER FOR: OUTLET BOXES, JUNCTION BOXES, CONDUIT HANGERS, RODS, INSERTS AND SUPPORTS. ZINC BASED PRIMER WITH FINISH TO MATCH BRUSH AND CLEAN WORK PRIOR TO CONCEALING, PAINTING AND ACCEPTANCE. PAINTED EXPOSED WORK SOILED OR DAMAGED; CLEAN AND REPAIR TO MATCH ADJOINING WORK BEFORE FINAL ACCEPTANCE. REMOVE DEBRIS FROM INSIDE AND OUTSIDE OF MATERIAL AND EQUIPMENT.

G. FINAL LOCATIONS AND MOUNTING ORIENTATIONS OF ALL SWITCHES, RECEPTACLES AND LIGHT FIXTURES SHALL BE VERIFIED WITH ARCHITECT.

H. ALL ACCESS DOOR LOCATIONS SHALL BE REVIEWED BY ARCHITECT PRIOR TO INSTALLATION.

3. SCOPE OF WORK:

A. SCOPE OF WORK SHALL CONSIST OF PROVIDING LABOR, MATERIALS, EQUIPMENT, SERVICES AND FEES NECESSARY FOR COMPLETE AND SAFE INSTALLATION IN CONFORMING WITH THE NATIONAL ELECTRICAL CODE 2020 WITH LOCAL ADOPTIONS, AND ALL OTHER APPLICABLE INDUSTRY, NATIONAL AND LOCAL CODES AND AUTHORITIES HAVING JURISDICTION, AS INDICATED ON DRAWINGS AND HEREIN SPECIFIED.

B. ALL DRAWINGS, PLANS, DETAILS, SPECIFICATIONS AND SPECIFICATION ADDENDA ARE MADE PART OF THIS CONTRACT AND SHALL APPLY TO ALL WORK UNDER THE CONTRACT UNLESS OTHERWISE AMENDED, MODIFIED, SUPPLIED OR SPECIFIED HEREIN.

C. THE CONTRACTOR SHALL FURNISH A WRITTEN GUARANTEE TO REPLACE OR REPAIR PROMPTLY AND ASSUME RESPONSIBILITY FOR ALL EXPENSES INCURRED FOR ANY WORKMANSHIP AND EQUIPMENT IN WHICH DEFECTS DEVELOP WITHIN ONE YEAR FROM THE DATE OF FINAL CERTIFICATE FOR PAYMENT AND/OR FROM DATE OR ACTUAL USE OF EQUIPMENT OR OCCUPANCY OF SPACES BY OWNER INCLUDED UNDER THE VARIOUS PARTS OF THE WORK, WHICHEVER, DATE IS EARLIER, THIS WORK SHALL BE DONE AS DIRECTED BY THE OWNER. THIS GUARANTEE SHALL ALSO PROVIDED THAT WHERE DEFECTS OCCUR, THE CONTRACTOR WILL ASSUME RESPONSIBILITY OF OTHER TRADES AFFECTED BY DEFECTS, REPAIRS OR REPLACEMENTS IN EQUIPMENT SUPPLIED BY THE CONTRACTOR.

D. THE CONTRACTOR SHALL GIVE NECESSARY NOTICE, FILE DRAWINGS AND SPECIFICATIONS WITH ALL DEPARTMENTS HAVING JURISDICTION, WORK AND PAY ALL FEES THEREFORE. THE CONTRACTOR SHALL ARRANGE FOR INSPECTION AND TESTS OF ANY OR ALL PARTS OF THE WORK IF SO REQUIRED BY AUTHORITIES AND PAY ALL CHARGES FOR SAME. THE CONTRACTOR SHALL PAY ALL COSTS FOR, AND FURNISH TO THE OWNER BEFORE FINAL BILLING, ALL CERTIFICATES NECESSARY AS EVIDENCE THAT THE WORK INSTALLED CONFORMS WITH ALL REGULATIONS WHERE THEY APPLY TO THIS WORK.

E. CONTRACTOR SHALL PERFORM ALL CONTROLLED INSPECTIONS IN ACCORDANCE WITH THE BUILDING CODE. SECURE ALL REQUIRED PERMITS AND APPROVALS AND TRANSMIT SAME TO OWNER. CONTRACTOR SHALL BE RESPONSIBLE FOR ALL FEES.

F. AREAS WITH NO ELECTRICAL WORK SHALL REMAIN AS IS. CONTRACTOR SHALL MAINTAIN CONTINUITY OF ALL ELECTRICAL SYSTEMS TO ALL AREAS NOT COVERED BY THIS RENOVATION AND SHALL PROVIDE 48 HOUR NOTICE TO LANDLORD OF ANY PLANNED POWER INTERRUPTIONS OR SIGNAL SYSTEM OUTAGES.

4. SHOP DRAWINGS

A. PRIOR TO THE INSTALLATION OF ANY WORK AND PROCUREMENT OF EQUIPMENT, CONTRACTOR SHALL PROVIDE COMPLETE SETS OF COORDINATED SHOP DRAWINGS OF ALL NEW AND EXISTING EQUIPMENT,INDICATING CAPACITY, DIMENSIONS AND SEQUENCE OF OPERATION FOR WRITTEN APPROVAL BY THE ARCHITECT AND ENGINEER.

B. INDICATE ON EACH SHOP DRAWINGS SUBMITTED:

1) PROJECT NAME AND LOCATION

2) NAME OF ARCHITECT AND ENGINEER

3) ITEM IDENTIFICATION

4) APPROVAL STAMP OF PRIME CONTRACTOR

C. SUBMISSIONS:

1) SUBMISSIONS 11 IN. X 17 IN. OR SMALLER: IF THE SUBMISSION IS A CATALOG CUT, THEN THE CONTRACTOR SHALL SUBMIT ONE ORIGINAL AND TWO COPIES. OTHERWISE, HE SHALL SUBMIT THREE COPIES. THE ARCHITECT WILL FORWARD THE ORIGINAL AND ONE COPY (TWO COPIES WHEN NO ORIGINAL IS RECEIVED) TO THE ENGINEER. ALL CATALOG CUTS SHALL BE COMPLETE.

2) SUBMISSIONS LARGER THAN 11 IN. X 17 IN.: SUBMIT TWO PRINTS AND ONE PAPER SEPIA TO THE ARCHITECT. THE ARCHITECT WILL FORWARD ONE PRINT AND THE PAPER SEPIA TO THE ENGINEER.

D. SUBMIT SHOP DRAWINGS FOR THE FOLLOWING:

1) SAFETY/DISCONNECT SWITCHES

2) FUSES

3) CIRCUIT BREAKERS

4) PANELBOARDS/LOADCENTER (INCLUDING DIMENSIONS, SCHEDULES, AND CATALOG CUTS).

5) RACEWAYS

6) WIRE AND CABLE

7) WALL SWITCHES

8) INSERTION RECEPTACLES

9) MOMENTARY CONTACT SWITCHES

10) TIME SWITCHES

11) LIGHTING FIXTURES.

12) TRANSFORMER.

E. ASSIST AND PROVIDE ALL NECESSARY INFORMATION, DIAGRAMS, SKETCHES, ETC. TO THE HVAC CONTRACTOR, FOR THE PREPARATION OF COORDINATED SHOP DRAWINGS INDICATING ROUTING OF FEEDERS, CONTROL CONDUITS, RECESSED FIXTURES AND ADJACENT NEARBY PIPING AND DUCTWORK WHERE APPLICABLE, CERTIFIED BY ALL TRADES THAT COORDINATION HAS BEEN ESTABLISHED. SUBMIT FOUR(4) BOOKBOUND OPERATING AND SERVICE MANUALS WHICH SHALL INCLUDE COPIES OF ALL SHOP DRAWING. PROVIDE SHOP DRAWINGS FOR PANELS, FIXTURES, WIRING DEVICES, CONDUIT, CABLE, DISCONNECT SWITCH, RELAYS, CONTRACTORS, AND OTHER SYSTEMS AS DIRECTED BY THE ENGINEER.

5. AS-BUILT DRAWINGS AND EQUIPMENT OPERATIONAL INSTRUCTIONS

A. UPON COMPLETION AND ACCEPTANCE OF WORK, CONTRACTOR SHALL FURNISH WRITTEN INSTRUCTIONS AND EQUIPMENT MANUALS AND DEMONSTRATE TO THE OWNER THE PROPER OPERATION AND MAINTENANCE OF ALL EQUIPMENT AND APPARATUS FURNISHED UNDER THIS CONTRACT.

B. THESE INSTRUCTIONS SHALL BE TYPED ON 8-1/2 IN. X 11 IN. PAPER A BOUND IN THREE RING BINDERS WITH CLEAR ACETATE COVERS. CONTRACTOR SHALL GIVE THREE COPIES OF THE INSTRUCTIONS TO THE OWNER AND ONE COPY TO THE ENGINEER.

C. THE INSTRUCTION BOOKLET SHALL BEAR THE NAME, ADDRESS AND TELEPHONE NUMBER OF THE PROJECT, ARCHITECT AND ENGINEER.

D. REPRODUCIBLE "AS-BUILT" DRAWINGS SHALL BE PROVIDED INDICATING THE AS INSTALLED CONDITIONS OF THE WORK. "AS-BUILT" DRAWINGS SHALL BE PROVIDED TO THE ARCHITECT AFTER COMPLETION OF THE INSTALLATION.

6. LOW-VOLTAGE DISTRIBUTION EQUIPMENT:

A. PROVIDE COMPLETE EQUIPMENT INCLUDING: SWITCHES, FUSES, CIRCUIT BREAKERS, PANELS AND TRANSFORMERS.

B. ALL EQUIPMENT SHALL CONFORM TO NEMA, ANSI AND IEEE STANDARDS.

C. DISCONNECT SWITCHES SHALL BE FUSED OR NONFUSED AS NOTED. VOLTAGE SHALL BE AS REQUIRED. SWITCHES SHALL BE HEAVY DUTY, EXCEPT AS NOTED, AND HORSEPOWER RATED FOR MOTOR LOADS. TOGGLE TYPE SWITCHES SHALL BE NONFUSED, LOAD BREAK, HAVING MAXIMUM RATINGS OF 20 AMP AT 600 VOLTS AND 30 AMP AT 240 VOLTS. TWO-POLE SWITCHES SHALL BE SIMILAR TO HART AND HEGEMAN NO. 6808F. THREE-POLE SWITCHES SHALL BE SIMILAR TO HART AND HEGEMAN NO. 7810F. KNIFE-BLADE TYPE SWITCHES SHALL BE LOAD BREAK, QUICK-MAKE- QUICK-BREAK, UL CLASS R UP TO 600 AMP. MAXIMUM RATING EXCEPT AS NOTED SHALL BE 800 AMP. ARC QUENCHERS SHALL BE PROVIDED. SWITCHES SHALL BE SIMILAR TO GENERAL ELECTRIC QMR. ALL SWITCH ENCLOSURES SHALL BE DEAD FRONT, NEMA TYPE 1, EXCEPT AS NOTED.

7. FUSES:

A. CIRCUITS 0 TO 600 AMPERES SHALL BE PROTECTED BY FUSES SIMILAR TO CURRENT LIMITING BUSSMAN LOW-PEAK DUAL-ELEMENT TIME-DELAY LPN-RK (AMP)SP (250V) /LPS-RK (AMP)SP (600V) OR LPJ (AMP)SP (600V) (UL CLASS RK1 OR CLASS J), AND BE LISTED BY UL WITH AN INTERRUPTING RATING OF 300,000 AMPERES RMS SYMMETRICAL.

B. MOTOR CIRCUITS - ALL INDIVIDUAL MOTOR CIRCUITS WITH FULLLOAD AMPERE RATINGS (FLA) OF 480 AMPERES OR LESS SHALL BE PROTECTED BY FUSES SIMILAR TO CURRENT LIMITING BUSSMANN LOW-PEAK DUAL-ELEMENT TIME-DELAY LPN-RK (AMP)SP (250V) /LPS-RK (AMP)SP (600V) OR LPJ (AMP) SP (600V) (UL CLASS RK1 OR CLASS J), AND BE LISTED BY UL WITH AN INTERRUPTING RATING OF 300,000 AMPERES RMS SYMMETRICAL.

C. ALL FUSES SHALL BE PROVIDED BY SAME MANUFACTURER.

D. PROVIDE 1 SPACE MATCHING FUSE FOR EACH SET OF 3.

E. CIRCUIT BREAKERS: MOLDED CASE BREAKERS SHALL BE THERMAL-MAGNETIC, QUICK-MAKE-QUICK-BREAK, BOLT-ON TYPE, MANUALLY OPERATED WITH INSULATED TRIP-FREE HANDLE. MULTI-POLE TYPE BREAKERS SHALL CONTAIN INTERNAL TRIP BAR. TERMINALS SHALL BE SUITABLE FOR COPPER OR ALUMINUM CABLE. FURNISH AUXILIARY DEVICES WHERE REQUIRED FOR SHUNT-TRIPPING, OPEN AND CLOSE MOTOR OPERATOR AND ALARM INDICATION. ENCLOSURES SHALL BE DEAD FRONT, NEMA TYPE 1, EXCEPT AS NOTED. FRAMES, IC AND INTERCHANGEABLE TRIPS SHALL BE AS FOLLOWS, UNLESS OTHERWISE NOTED:

1) 120 VOLTS, 100-AMP FRAME: 10,000 AMPS, 1 POLE.

2) 120/240 VOLTS, 225-AMP FRAME: 22,000 AMPS MINIMUM.

8. DISTRIBUTION PANELBOARDS, CIRCUIT BREAKER TYPE:

A. THREE PHASE, 4 OR 5 WIRE, COPPER BUS BARS, WITH 2, 3, OR 4 WIRE BRANCHES, AS NOTED. CAPACITY OF PANEL AND CIRCUITS, AS NOTED BELOW. PANELBOARD TO HAVE GROUND BUS SAME SIZE AS PHASE BUSES.

B. CABINETS: CODE GAUGE GALVANIZED SHEET STEEL PRIMED AND PAINTED WITH TRIM AND DOOR, TYPE AS NOTED, LAP AND RIVET CORNERS OR FORM AS APPROVED.

C. TRIM: ONE PIECE FULL FINISH PRIMED AND PAINTED SHEET STEEL. TRIM SHALL BE MOUNTED WITH A CONTINUOUS PIANO HINGE CONFIGURED IN SUCH A MANNER THAT IT SHALL BE POSSIBLE TO GAIN FULL ACCESS TO CIRCUIT BREAKERS AND WIRING GUTTERS WITHOUT REMOVING THE TRIM. PROVIDE A MULTI-PIN CYLINDER LOCK (YALE, CORBIN OR EQUAL) TO LATCH THE TRIM. KEYS SHALL BE MILLED.

D. HARDWARE: MULTI-PIN, CYLINDER LOCKS WITH MILLED KEYS. ALL PANELS SHALL BE KEYED ALIKE. DOOR OVER 48″ HIGH SHALL BE EQUIPPED WITH A CHROME PLATED VAULT HANDLE, BUILT-IN LOCK AND 3-POINT CATCH FASTENING DOOR AT TOP, BOTTOM AND CENTER.

E. HINGES: CONCEALED, CONTINUOUS PIANO HINGE AS DESCRIBED ABOVE.

F. DIRECTORY HOLDER: MEAL FRAME WITH NONBREAKABLE TRANSPARENT COVER AND DIRECTORY CARD. ENTRIES TO BE TYPEWRITTEN BY ELECTRICAL CONTRACTOR. PROVIDE AN ENGRAVED LAMINATED NAMEPLATE ADJACENT TO EACH BRANCH BREAKER. MOUNT WITH SELF TAPPING MACHINE SCREWS.

G. FURNISH MULTI-CABLE LUGS WHERE REQUIRED. DOUBLE LUGGING NOT PERMITTED. SECURE LUGS TO BUS BY STUD BOLTS.

H. PANELBOARD CONSTRUCTION FOR BOLTED TYPE BREAKERS. MINIMUM SHORT CIRCUIT RATING 25,000 AMPERES, RMS SYMMETRICAL FOR ALL 120/208V APPLICATIONS. INDIVIDUAL CIRCUIT BREAKERS SHALL HAVE MINIMUM 100A FRAME, TRIPS SIZED AS SHOW ON THE PLANS.

I. MINIMUM GUTTER SPACES: PANELS WITH 225 AMPERE MAINS, 5-¾″ MINIMUM, 400 AMPERES AND OVER, MINIMUM GUTTERS 8″. FOR PANELS WITH THROUGH FEEDERS, INCREASE GUTTER WIDTH BY 2″ MINIMUM AND PROVIDE A SHEET STEEL BARRIER BETWEEN THE PANEL GUTTER AND THE THROUGH FEEDER PORTION OF THE BACK BOX. BRANCH CIRCUIT BREAKERS SHALL BE MECHANICALLY INTERLOCKED WHEN SHOWN ON DRAWINGS.

J. DISTRIBUTION AND SUB-DISTRIBUTION PANELBOARDS SHALL BE A MINIMUM OF 30" WIDE AND 10" DEEP.

K. PANELBOARD SHALL HAVE MAIN CIRCUIT BREAKER OR MAIN LUGS AS INDICATED ON THE DRAWINGS. QUANTITY, POLES AND TRIP RATINGS OF BRANCH CIRCUIT BREAKERS TO BE AS INDICATED ON DRAWINGS.

L. PANELBOARD SHALL HAVE ENGRAVED WHITE CORE, BLACK LAMACOID NAMEPLATE SCREWED ONTO PANE TRIM WITH DESIGNATION LISTED (PANELBOARD NAME, VOLTAGE, RATING OR MAINS IN AMPS).

9. DISTRIBUTION PANELBOARDS, SWITCH AND FUSE:

A. THREE PHASE, 3 OR 4 WIRE WITH COPPER BUS BARS. ALL THROUGH BUS SHALL BE INSULATED.

B. NEMA CLASS 1 CONSTRUCTION TO ACCOMMODATE FUSIBLE, INDIVIDUALLY ENCLOSED SWITCHES, FRONT REMOVABLE, SWITCH AND DOOR INTERLOCKS. COVERS TO BE PAD-LOCKABLE.

C. PANELBOARD SHALL BE CONSTRUCTED OF CODE-GAUGE STEEL, GRAY FINISH OVER RUST INHIBITOR, FOR SURFACE MOUNTING. BOX AND PANEL FRAME SHALL BE FLANGED AND REINFORCED FOR RIGID SUPPORT OF INTERIOR AND ACCURATE ALIGNMENT OF INTERIOR WITH FRONT. TRIMS TO BE FASTENED TO BACK BOX WITH SCREWS.

D. ALL BRANCH SWITCHES SHALL HAVE INDIVIDUAL ENGRAVED LAMICOID NAMEPLATES (BLACK WITH WHITE CORE).

E. DISTRIBUTION PANELBOARD CONSTRUCTION MINIMUM SHORT CIRCUIT RATING 25,000 AMPERES, REMS SYMMETRICAL FOR ALL 120/208V APPLICATIONS. APPLICATIONS.

F. DISCONNECTS

1) DISCONNECT SWITCHES SHALL CONFORM TO NEMA AND UL STANDARDS, AND SHALL BE HORSEPOWER RATED.

2) SWITCHING MECHANISM SHALL BE QUICK-MAKE, QUICK-BREAK, SINGLE THROW WITH EXTERNAL OPERATING HANDLE MECHANICALLY INTERLOCKED WITH ENCLOSURE COVER TO PROVIDE ACCESS TO INTERIOR WHEN DISCONNECT IS IN OFF POSITION ONLY. PROVIDE MEANS TO LOCK OPERATING HANDLE IN THE OPEN AND CLOSED POSITION. DESIGNATE ON THE ENCLOSURE THE OPEN AND CLOSED POSITION OF THE OPERATING HANDLE.

3) SWITCHES SHALL BE OF THE DOUBLE STATIONARY CONTACT TYPE.

4) SWITCHES SHALL BE EQUIPPED WITH REJECTION TYPE FUSE HOLDERS, FUSIBLE AS SHOWN ON THE DRAWINGS; PROVIDE COMPLETE WITH FUSES AS SCHEDULED.

Property of NYC Engineers

PROJECT:
REDLINE ATHLETICS - FLEMINGTON NJ

DRAWING TITLE:
ELECTRICAL SPECIFICATIONS (1 OF 2)

SHEET:
E-002

ELECTRICAL SPECIFICATION (CONT.)

G. INSTALLATION

1) DISTRIBUTION PANELBOARD SHALL BE MOUNTED TO STRUCTURAL STEEL CHANNEL (KINDORF) WHICH SHALL BE BOLTED TO THE WALL USING EXPANSION ANCHORS FOR LARGE PANELS.

H. IDENTIFICATION

1) PROVIDE NAMEPLATE AT EACH SWITCH IDENTIFYING THE LOAD SERVED.

2) NAMEPLATES SHALL BE MOUNTED ON THE FRONT COVER SECURED WITH SELF-TAPPING SCREWS OR NUTS AND BOLTS. NAMEPLATES SHALL BE LAMINATED PHENOLIC, BLACK WITH A MINIMUM OF ¼" HIGH WHITE LETTERING.

I. DISTRIBUTION AND SUB-DISTRIBUTION PANELBOARDS SHALL BE A MINIMUM OF 30" WIDE AND 10" DEEP.

J. POWER PANELBOARDS SHALL BE SIMILAR TO GENERAL ELECTRIC TYPE "OMR", AS MANUFACTURED BY ATLAS SWITCH COMPANY, ELECTRIC SWITCHBOARD COMPANY OR APPROVED EQUAL.

K. PANELBOARD SHALL HAVE MAIN CIRCUIT BREAKER OR MAIN LUGS AS INDICATED ON THE DRAWINGS. QUANTITY, POLES AND TRIP RATINGS OF BRANCH CIRCUIT BREAKERS TO BE AS INDICATED ON DRAWINGS.

L. PANELBOARD SHALL HAVE ENGRAVED WHITE CORE, BLACK LAMACOID NAMEPLATE SCREWED ONTO PANE TRIM WITH DESIGNATION LISTED (PANELBOARD NAME, VOLTAGE, RATING OR MAINS IN AMPS).

M. MATERIALS

1) RACEWAYS:

a. RIGID STEEL CONDUIT: FULL-WEIGHT PIPE, GALVANIZED, THREADED.

b. ELECTROMETALLIC TUBING (EMT): THIN WALL PIPE, GALVANIZED, THREADLESS.

c. FLEXIBLE STEEL CONDUIT: CONTINUOUS SINGLE STRIP, GALVANIZED.

d. WIREWAYS: WIRE SHALL BE AS NOTED, MINIMUM NO. 16 GAUGE STEEL WITH GROUND CONTINUITY. FINISH SHALL BE BAKED ENAMEL. COVERS SHALL BE SCREW-ON.

e. SURFACE METAL RACEWAY: SIZE AS NOTED. BASE 0.04 IN., COVER 0.25 IN. MATERIAL SHALL BE STEEL. FINISH SHALL BE BAKED ENAMEL. COVERS SHALL BE SCREW-ON.

2) FITTINGS AND ACCESSORIES:

a. RIGID STEEL: NONSPLIT, THREADED, STEEL OR MALLEABLE IRON. ZINC DIE CAST NOT PERMITTED.

b. ELECTROMETALLIC TUBING: COMPRESSION TYPE. GALVANIZED RIGID STEEL ELBOWS, 2 IN. OR LARGER.

c. FLEXIBLE METALLIC CONDUIT: ANGLE WEDGE TYPE WITH INSULATED THROAT.

d. BUSHINGS: METALLIC INSULATED TYPE.

3) BOXES:

a. OUTLET BOXES: EXCEPT AS OTHERWISE REQUIRED BY CONSTRUCTION, DEVICES OR WIRING, BOXES SHALL BE STAMPED STEEL, 4 IN. SQUARE OR OCTAGON FOR FIXTURES. BOXES ABOVE CEILING SHALL BE 1-1/2 IN. DEEP. BOXES IN CEILING OR SLAB SHALL BE 3 IN. DEEP. BOXES IN WALL FOR FIXTURES SHALL BE 2-3/4 IN. DEEP. BOXES IN WALL FOR RECEPTACLES AND SWITCHES SHALL BE 1-1/2 IN. DEEP. FURNISH WITH RAISED COVERS AND FIXTURE STUDS WHERE REQUIRED. WITHOUT FIXTURE OR DEVICE: FURNISH BLANK COVER. OFFSET BACK-TO-BACK OUTLETS WITH MINIMUM 6 IN. SEPARATION.

b. JUNCTION AND PULL BOXES: GALVANIZED SHEET STEEL WITH SCREW-ON COVERS, EXCEPT AS NOTED. FURNISH WITH INSULATED SUPPORTS FOR CABLES. LOCATIONS SHALL BE AS NOTED OR REQUIRED AND ACCESSIBLE. PROVIDE BARRIERS IN NEW AND RENOVATED BOXES BETWEEN 120/208 VOLT AND 265/460 VOLT WIRING AND BETWEEN EMERGENCY AND NORMAL WIRING. FLOOR BOXES SHALL BE SUITABLE FOR CONDUIT AND DEVICES NOTED. RAISED OUTLETS SHALL BE HUBBELL #B2414 SERIES WITH ABOVE FLOOR FITTING. TELEPHONE: BUSHED HOLE. POWER: DUPLEX RECEPTACLE OR OTHER AS NOTED. INCREASE SIZE TO SUIT AS NECESSARY. FLUSH OUTLETS SHALL BE HUBBELL #B2414 SERIES WITH FLUSH FLOOR FITTING FOR TELEPHONE AND FLUSH DUAL FLAP COVER WITH DUPLEX RECEPTACLE FOR POWER AS NOTED. INCREASE SIZE TO SUIT AS NECESSARY.

N. PROVIDE RACEWAYS ONLY AS HEREIN SPECIFIED, EXCEPT AS NOTED. RACEWAYS SHALL BE RUN CONCEALED, EXCEPT AS NOTED.

PROVIDE RACEWAY SUPPORT UTILIZING CEILING TRAPEZE, STRAP HANGERS, OR WALL BRACKETS. PROVIDE U-BOLTS AT EACH FLOOR LEVEL OF RISER RACEWAYS AND CONNECTED TO ACCEPTABLE SUPPORTS. PROVIDE RISER CLAMPS AT EACH FLOOR LEVEL OF RISER RACEWAYS AND RESTING ON SLAB. FOR THROUGH-THE-FLOOR SYSTEMS, UTILIZE AN ASSEMBLY SIMILAR TO HUBBELL FIRE RATED POKE-THROUGH-FLOOR BOX SYSTEM. FOR ABOVE FLOOR FITTINGS TELEPHONE SHALL BE BUSHED HOLE AND POWER SHALL BE DUPLEX RECEPTACLE OR OTHER AS NOTED. PROVIDE SEPARATION BARRIER BETWEEN POWER AND TELEPHONE COMPARTMENTS. PROVIDE JUNCTION BOX ON UNDERSIDE OF FLOOR. PACK FITTING TO RESTORE FIRE RATING OF FLOOR.

SECURE ALL RACEWAYS TO SUPPORTS WITH PIPE STRAPS OR U-BOLTS. SPACING OF SUPPORTS SHALL BE A MINIMUM OF 10 FT ON CENTER FOR METALLIC RACEWAY AND AS REQUIRED FOR NONMETALLIC RACEWAY. SPACING SHALL BE 5 FT ON CENTER FOR WIREWAYS AND PER CODE AND AS NOTED FOR OTHERS. MOUNT SUPPORTS TO STRUCTURE MASONRY WITH TOGGLE BOLTS ON HOLLOW MASONRY, EXPANSION SHIELDS OR INSERTS IN CONCRETE AND BRICK, MACHINE SCREWS ON METAL, BEAM CLAMPS ON FRAMEWORK, WOOD SCREWS ON WOOD, AND PAN THROUGH STRAPS IN METAL DECK. NAILS, RAWL PLUGS OR WOOD PLUGS SHALL NOT BE PERMITTED. WHERE REQUIRED BY STRUCTURE, FURNISH THROUGH BOLTS AND FISHPLATES.

EXPOSED RACEWAYS SHALL BE RUN PARALLEL WITH OR AT RIGHT ANGLES TO WALLS. PROVIDE CLEARANCE WITH WATER, STEAM OR OTHER PIPING (MINIMUM 3 IN. SEPARATION FROM STEAM AND HOT WATER PIPES, EXCEPT 1 IN. FROM PIPE COVER AT CROSSINGS AND 18 IN. FOR PARALLEL RUNS). FOR HUNG CEILING OUTLETS, RUN IN HUNG CEILING AND CONNECT TO CEILING SUPPORT CHANNELS. IN MASONRY AND POURED CONCRETE, RUN VERTICALLY ONLY.

EMPTY RACEWAYS OVER 10 FT LONG: PROVIDE FISH OR PULL WIRE, GALVANIZED OR NYLON ROPE.

RIGID STEEL CONDUIT SHALL BE PERMITTED FOR FEEDERS AND BRANCH CIRCUITS. PAINT MALE THREADS OF FIELD-THREADED CONDUIT WITH GRAPHITE-BASE PIPE COMPOUND AND BUTT CONDUIT ENDS. TOUCH UP MARRED SURFACES AND FIELD-CUT THREADS, CRC-COLD GALVANIZED. EMT SHALL BE PERMITTED FOR BRANCH CIRCUITS ONLY, IN DRY LOCATIONS, DRY WALLS, HUNG CEILINGS, HOLLOW BLOCK WALLS AND FURRED SPACES. EMT SHALL NOT BE PERMITTED IN RAISED FLOORS. FLEXIBLE STEEL CONDUIT SHALL BE UTILIZED FOR SHORT CONNECTIONS WHERE RIGID CONDUIT IS IMPRACTICAL. FROM OUTLET BOX TO RECESSED LIGHTING FIXTURE: PROVIDE MINIMUM 4 FT AND MAXIMUM 6 FT LENGTHS. FOR FINAL CONNECTION TO MOTOR TERMINAL BOX, TRANSFORMER AND OTHER VIBRATING EQUIPMENT: PROVIDE WITH POLYVINYL SHEATHING AND GROUND CONDUCTOR, MINIMUM LENGTH: 18 IN. WITH SLACK. CONNECT GROUND CONDUCTOR TO ENCLOSURE OR RACEWAY AT EACH END. FOR EXPANSION JOINT CROSSINGS, CROSS AT RIGHT ANGLES AND ANCHOR ENDS.

CUT CONDUIT ENDS SQUARE. REAM SMOOTH. PAINT MALE THREADS OF FIELD THREADED RACEWAYS WITH GRAPHITE BASE PIPE COMPOUND. DRAW UP TIGHT WITH RACEWAY COUPLING.

ALL COUPLINGS SHALL BE COMPRESSION TYPE. NO SET SCREW FITTINGS.

EXPANSION FITTINGS SHALL BE INSTALLED AT RIGHT ANGLES WITH CLIP JOINT CENTERED IN EXPANSION JOINT. PROVIDE A LENGTH OF RUN IN ACCORDANCE MANUFACTURER'S RECOMMENDATIONS. PRESET FITTINGS SHALL ALLOW FOR TEMPERATURE VARIATION.

RACEWAYS PASSING THROUGH FIRE-RATED CONSTRUCTION: SEAL OPENING WITH FIRE SEALANT.

O. PROVIDE CABLE SUPPORTS IN ACCORDANCE WITH NATIONAL ELECTRIC CODE ARTICLE 300.19. CABLE SUPPORTS SHALL UTILIZE A ONE-PIECE PLUG WITH POZI-GRIP WEDGING PLUG AS MANUFACTURED BY OZ-GEDNEY. TYPE SF SHALL BE USED FOR ARMORED CABLE.

INSTALL CABLE SUPPORTS AT THE TOP OF A VERTICAL RISE AND PROVIDE INTERMEDIATE ADDITIONAL SUPPORTS AS REQUIRED TO LIMIT SUPPORTED CONDUCTOR LENGTHS TO NOT GREATER THAN THOSE SPECIFIED IN TABLE 300.19(A).

P. ERECT WALL AND SWITCH OUTLETS IN ADVANCE OF FURRING AND FIREPROOFING. OUTLET BOXES SHALL BE SET SQUARE AND TRUE WITH BUILDING FINISH. SECURE TO BUILDING STRUCTURE BY ADJUSTABLE STRAP IRON OR GROUT IN WITH MASONRY. VERIFY OUTLET LOCATIONS IN FINISHED SPACES WITH ARCHITECTURAL DRAWINGS OF INTERIOR DETAILS AND FINISHES. PROVIDE BARRIER BETWEEN SWITCHES CONNECTED TO DIFFERENT PHASES FOR VOLTAGES EXCEEDING 150 VOLTS TO GROUND.

Q. PANEL, JUNCTION AND PULL BOXES SHALL BE LOCATED CLEAR OF OTHER TRADES. CONCEAL JUNCTION AND PULL BOXES IN FINISHED WHERE NECESSARY, REROUTE RACEWAYS OR MAKE OTHER ARRANGEMENTS FOR CONCEALMENT. BOXES SHALL BE ACCESSIBLE. SUPPORT BOXES FROM BUILDING STRUCTURE, INDEPENDENT OF CONDUIT. PROVIDE FLOOR-TO-CEILING CHANNELS FOR MOUNTING ON DRYWALL AND LIGHTWEIGHT CONSTRUCTION. OUTLET BOXES FOR FIXTURES RECESSED IN HUNG CEILINGS SHALL BE ACCESSIBLE THROUGH OPENING CREATED BY REMOVAL OF FIXTURE. SECURE TO BLACK IRON SUPPORT. MOTOR TERMINAL BOXES: COORDINATE WITH MOTOR BRANCH CIRCUIT CONDUIT AND WIRING; ADD BOX VOLUME WHERE REQUIRED.

R. FIRE SEALANTS: PROVIDE FOR RACEWAYS AND WIRE PASSING THROUGH FLOOR SLOTS, SLEEVES OR OPENINGS IN FIRE-PARTITIONS ROOMS.

S. PERFORM CONTINUITY TESTS OF RESISTANCE OF FEEDER CONDUITS FROM SERVICE TO POINT OF FINAL DISTRIBUTION USING 1 CONDUCTOR RETURN. MAXIMUM RESISTANCE SHALL BE 25 OHMS.

10. WIRE AND CABLE:

A. PROVIDE WIRE AND CABLE COMPLETE WITH ACCESSORIES. SIZE REFERENCE SHALL BE AWG EXCEPT AS NOTED.

B. CONDUCTORS SHALL BE COPPER, ASTM STANDARD SOLID (NO. 10 AND SMALLER) OR STRANDED (NO. 8 AND LARGER). GENERAL USE CABLING SHALL BE NO. 12 MINIMUM. AT 120 VOLTS AND OVER 100 FT CIRCUIT LENGTH PROVIDE NO. 10 MINIMUM. AT 265 VOLTS AND OVER 200 FT CIRCUIT LENGTH PROVIDE NO. 10 MINIMUM.

C. CONTROL AND ALARM CABLING, EXCEPT AS NOTED, SHALL BE NO. 14 MINIMUM. AT 120 VOLTS AND OVER 200 FT CIRCUIT LENGTH PROVIDE NO. 12 MINIMUM. OTHER VOLTAGES AND PHASES: ADJUST CABLE SIZING AS REQUIRED TO MAINTAIN VOLTAGE DROP. INCREASE RACEWAY SIZES FOR LARGER WIRE AS REQUIRED.

D. INSULATION SHALL BE RUBBER AND THERMOPLASTIC MEETING ASTM AND IPCEA STANDARDS. TYPE THW OR THWN SHALL BE UTILIZED FOR FEEDERS AND BRANCH CIRCUITS EXCEPT AS NOTED. TYPE SFF-2 SHALL BE UTILIZED FOR BRANCH CIRCUITS LOCATED IN WIRING CHANNELS OF CONTINUOUS FLUORESCENT FIXTURES AND IN AMBIENT TEMPERATURES OVER 90 DEG C.FOR UNGROUNDED ISOLATED BRANCH CIRCUITS PROVIDE CROSS-LINKED POLYETHYLENE INSULATION (TYPE XHHW).

E. ARMORED CABLE (BX) SHALL BE UTILIZED FOR BRANCH CIRCUITS IN DRY HOLLOW LOCATIONS, HUNG CEILINGS, AND BLOCK WALLS. WHEN USED IN LIEU OF WIRING IN CONDUIT, STATE IN PROPOSAL THAT PRICE IS BASED UPON THE USE OF HOSPITAL GRADE 'BX'.

F. COLOR CODING SHALL BE AS FOLLOWS:

120/208 VOLT SYSTEM:	277/480 VOLT SYSTEM:
BLACK FOR A PHASE	BROWN FOR A PHASE
RED FOR B PHASE	ORANGE FOR C PHASE
BLUE FOR C PHASE	YELLOW FOR C PHASE

1) NEUTRAL WIRE SHALL TILIZE WHITE OUTER COVERING THROUGHOUT. EQUIPMENT GROUND WIRE SHALL UTILIZE GREEN OUTER COVERING THROUGHOUT.

G. WHERE COLOR-CODED CABLE IS NOT AVAILABLE, CERTIFY IN WRITING AND REQUEST PERMISSION TO OVERLAP CONDUCTORS WITH 6 IN. OF COLOR TAPING IN ACCESSIBLE LOCATIONS.

H. TERMINATIONS, SPLICES AND TAPS UNDER 600 VOLTS: COPPER CONDUCTORS NO. 10 AND SMALLER SHALL UTILIZE COMPRESSION-TYPE OF TWIST-ON SPRING-LOADED CONNECTORS AND CLEAR NYLON-INSULATED COVERING. COPPER CONDUCTORS NO. 8 AND LARGER SHALL UTILIZE MECHANICAL BOLTED PRESSURE OR HYDRAULIC COMPRESSION TYPE USING MANUFACTURER'S RECOMMENDED TOOLING. CABLE UGS AND CONNECTORS SHALL UTILIZE COMPRESSION TYPE OF SAME METAL AS CONDUCTOR. PROVIDE TO MATCH CABLE, WITH MARKING INDICATING SIZE AND TYPE. COPPER LUG CONNECTIONS TO BUS BARS: USE ANTISEIZE COMPOUND ON TANG.

I. NOT MORE THAN 3 LIGHTING OR CONVENIENCE OUTLET CIRCUITS SHALL BE INSTALLED IN ONE CONDUIT UNLESS OTHERWISE INDICATED. PULL NO THERMOPLASTIC WIRES AT TEMPERATURES LOWER THAN 32 DEG F. PROVIDE SEPARATE RACEWAYS FOR CONDUCTORS OF 120/208 AND 265/460 VOLT SYSTEMS, EXCEPT 460 VOLT MOTOR BRANCH CIRCUIT WIRING AND RELATED 120 VOLT CONTROL WIRING. THERMOPLASTIC WIRES SHALL NOT BE INSTALLED IN COMPUTER AREA RAISED FLOORS.

J. LEAVE WIRES WITH SUFFICIENT SLACK TO PERMIT MAKING FINAL CONNECTIONS.

K. PERFORM CONTINUITY AND INSULATION TESTS. MEGGER TEST 100 PERCENT OF FEEDERS, 10 PERCENT OF BRANCH CIRCUITS AND ALL MOTOR BRANCH CIRCUITS OVER 25 HP.

PERFORM TESTS PRIOR TO CONNECTING EQUIPMENT AND IN PRESENCE OF AUTHORIZED REPRESENTATIVES. SUBMIT WRITTEN REPORT OF RESULTS. CORRECT OR REPLACE CABLE TESTING BELOW MANUFACTURER'S STANDARDS.

11. WIRING DEVICES:

A. WIRING DEVICES SHALL BE SPECIFICATION GRADE UNLESS OTHERWISE SPECIFIED. ALL DEVICES SHALL BE FLUSH MOUNTED, UNLESS OTHERWISE NOTED. PROVIDE COMPLETE MATERIAL AND ACCESSORIES AS NOTED.

B. LOCAL WALL SWITCHES SHALL BE ROCKER TYPE, QUIET OPERATING, RATED 20 AMP, 120/277 VOLT, AC. SIMILAR TO LEVITON DECORA SERIES A5621 (SINGLE POLE), A5623 (3-WAY) AND A5624 (4-WAY).

C. STRAIGHT BLADE RECEPTACLES SHALL BE RESIDENTIAL GRADE DUPLEX CONVENIENCE 125 VOLTS, 2 POLE, 3 WIRE, U GROUND SLOT, DECORA SERIES BY LEVITON. GROUNDED, EXCEPT AS NOTED.

1) SINGLE GANG, RECESSED, DUPLEX RECEPTACLE: TAMPER RESISTANT, 2-POLE, 3-WIRE GROUNDING, 15A, 125V, NEMA 5-20R; LEVITON 689 SERIES (COLOR AS SPECIFIED BY ARCHITECT).
2) USB CHARGER/ DUPLEX TAMPER-RESISTANT RECEPTACLE: TAMPER RESISTANT,

D. DEVICE PLATES: SEE ARCHITECT FOR TYPE. FOR RECEPTACLES WITH OTHER THAN 120 VOLT, INSCRIBED VOLTAGE AVAILABLE.

E. COLORS: COORDINATE COLORS WITH ARCHITECT.

F. MOUNTING ORIENTATION OF RECEPTACLES (HORIZONTAL OR VERTICAL): COORDINATE WITH ARCHITECT.

12. LIGHTING FIXTURES:

A. FIXTURES TO BE AS SPECIFIED BY ARCHITECT AND SHALL BE COMPLETELY FACTORY ASSEMBLED, WIRED AND EQUIPPED WITH ALL NECESSARY SOCKETS, BALLASTS, SUPPORTING HARDWARE AND ACCESSORIES. REFER TO DRAWINGS FOR INDIVIDUAL FIXTURE DESCRIPTIONS.

B. FIXTURE CATALOG NUMBERS USED TO ILLUSTRATE EQUIPMENT TYPE DO NOT NECESSARILY DENOTE REQUIRED MOUNTING EQUIPMENT OR ACCESSORIES. PROVIDE ACCESSORIES TO SUIT.

C. BALLAST: CLASS P, HIGH POWER FACTOR, LOWEST AVAILABLE NEMA RATED NOISE LEVEL, ET1 AND CBM APPROVED. ENERGY SAVING TYPE. TRIGGER START FOR 24-INCH LAMPS AND RAPID START FOR 48-INCH. TWO LAMP BALLASTS; NO THREE LAMP BALLASTS. BALLASTS SHALL BE ADVANCE MAGNETEK, UNIVERSAL OR EQUAL.

D. LED DRIVERS SHALL BE ELECTRONIC TYPE, LABELED AS COMPLIANT WITH RADIO FREQUENCY INTERFERENCE (RFI) REQUIREMENTS OF FCC TITLE 47, PART 15 AND COMPLY WITH NEMA SSL 1 "ELECTRONIC DRIVERS SHALL HAVE A SOUND RATING OF "A", HAVE A MINIMUM EFFICIENCY OF 85% AND BE RATED FOR A THD OF LESS THAN 20% AT ALL INPUT VOLTAGES.

E. DIMMABLE LED DRIVERS SHALL BE CAPABLE OF DIMMING WITHOUT LED STROBING OR FLICKER ACROSS THEIR FULL DIMMING RANGE. PROVIDE TYPE OF LED DRIVER AS PER LIGHTING FIXTURE SCHEDULE, DIMMABLE LED DRIVERS SHALL BE 0-10V WHERE NOT INDICATED.

F. CONTINUOUS ROW, TWO LAMP STRIP FIXTURES SHALL BE STAGGERED TYPE.

G. EXIT SIGNS SHALL BE PRECISION DIE-CAST ALUMINUM HOUSING WITH LASER-FORMED ACRYLIC LEGEND. EXIT SIGNS SHALL COMPLY WITH UL 924 AND BE MEA APPROVED. AC POWERED WITH PREMIUM LONG-LIFE NICKEL CADMIUM BATTERY WITH STANDARD UL LISTED 3-HOUR RUN TIME. PROVIDE WITH INTEGRAL AUTOMATIC CHARGER IN A SELF CONTAINED POWER PACK. LED INDICATOR WITH PUSH TO TEST SWITCH.

13. TELEPHONE CONDUIT SYSTEM:

A. PROVIDE COMPLETE SYSTEM OF: RACEWAYS AND ACCESSORIES, OUTLET BOXES, SLEEVES AND FISHWIRES.

B. EQUIPMENT SHALL CONFORM TO REQUIREMENTS OF TELEPHONE COMPANY.

C. OUTLETS SHALL BE:

1) WALL: 4 IN. SQUARE WITH BUSHED COVER PLATE.

D. PROVIDE FISHWIRES, IN RACEWAYS OVER 10 FT LONG.

E. CONDUIT SHALL BE 3/4 IN. MINIMUM. FURNISH EMPTY CONDUIT FROM OUTLET BOX TO BUSHED END THRU WALL 6" BELOW THE PLASTER CEILING.

F. FACE RACEWAYS IN ROOMS SHALL HUBBELL HBL500, HBL750 OR HBL2000 SERIES OR AS ACCEPTABLE.

14. GROUNDING AND BONDING:

A. PROVIDE GROUNDING SYSTEM IN ACCORDANCE WITH 2020 NATIONAL ELECTRIC CODE (NEC) WITH NEW JERSEY ADOPTIONS, AND THESE SPECIFICATIONS. THE WIRING SYSTEM SHALL BE INSTALLED AS REQUIRED TO PROVIDE A CONTINUOUSLY GROUNDED SYSTEM. WHERE FLEXIBLE CONDUIT IS USED FOR PART OF A CONDUIT RUN, EXCEPT LIGHTING BRANCH CIRCUITS, AN INSULATED GROUNDING CONDUCTOR SHALL BE PROVIDED IN THE CONDUIT AND CONNECTED TO GROUNDING BUSHINGS AT EACH END OF THE RUN.

B. USE EXOTHERMIC WELDING PROCESS FOR INACCESSIBLE CONNECTIONS.

C. EXTEND EXISTING SYSTEM GROUND TO INCLUDE ALL THE ELECTRICAL EQUIPMENT IN THE SCOPE OF WORK.

D. WHERE FLEXIBLE METALLIC CONDUIT IS USED AN INTERNAL BONDING CONDUCTOR SHALL BE INSTALLED.

E. IN ADDITION, FURNISH A SEPARATE INSULATED GREEN EQUIPMENT GROUND CONDUCTOR WHERE INDICATED ON DRAWINGS AND FOR THE FOLLOWING BRANCH CIRCUITS:
1) CIRCUITS SERVING ANY WALL BOX DIMMER.

2) CIRCUITS SERVING ANY ISOLATED GROUND RECEPTACLES. TERMINATE GROUND DIRECTLY AT AN EQUIPMENT GROUNDING CONDUCTOR TERMINAL OF THE SOURCE AT THE SOURCE , OR AS OTHER WISE NOTED ON DRAWINGS.

3) CIRCUITS SERVING ANY DUPLEX OR SIMPLEX COMPUTER RECEPTACLES

4) ANY CIRCUIT SERVED VIA AN ISOLATION TRANSFORMER OR COMPUTER POWER DISTRIBUTION UNIT.

15. PANELBOARDS:

A. PANELBOARDS SHALL BE OF THE DEAD FRONT TYPE MANUFACTURED IN CODE GAUGE AND SIZE BOXES FOR MOUNTING AS INDICATED ON PLANS COMPLETE WITH TRIM, DOORS AND LOCKS. ALL LOCKS SHALL BE KEYED ALIKE.

B. CIRCUIT BREAKERS SHALL BE OF THE BOLT-ON THERMAL MAGNETIC MOLDED CASE TYPE, AND SHALL HAVE THE TRIP RATINGS AND NUMBER OF POLES SHOWN IN SCHEDULES ON THE CONTRACT DRAWINGS. FOR BLANK (SPACE) COMPARTMENTS, PROVIDE FULL RATED BUS. MINIMUM GUTTER SPACES SHALL BE 5-3/4". SIDES, TOP AND BOTTOM, INCREASE FOR THROUGH FEEDERS. PROVIDE 25% COPPER GROUND BUS AND 100% COPPER NEUTRAL BUS AND INCREASE NEUTRAL BUS INDICATED.

C. LOCKING TABS SHALL BE PROVIDED ON ALL CIRCUIT BREAKERS SERVING EMERGENCY LIGHTING, FIRE ALARM SYSTEM, SECURITY SYSTEMS AND OTHER EMERGENCY OR CRITICAL EQUIPMENT AND AS NOTED ON THE CONTRACT DRAWINGS. A TOTAL OF 5 SPARE LOCKING TABS SHALL BE FURNISHED TO THE OWNER.

D. BUSES SHALL BE HARD DRAWN COPPER OF 98 PERCENT CONDUCTIVITY AND SHALL HAVE CROSS SECTIONAL AREAS LARGE ENOUGH TO LIMIT THE TEMPERATURE RISE, WHEN CARRYING FULL LOAD, TO 35 DEGREES C. ABOVE AN AMBIENT INSIDE THE ENCLOSURE OF 55 DEGREES C. AS DEFINED IN IEEE STANDARD RULES. MAIN BUS CAPACITY SHALL BE AS SHOWN ON THE CONTRACT DRAWINGS.

E. ENCLOSURES SHALL BE SURFACE OR FLUSH AS INDICATED. TRIMS SHALL BE SECURED TO PANEL WITH MACHINE SCREWS. COVERS SHALL BE HINGED DOOR-IN-DOOR CONSTRUCTION WITH CYLINDER LOCKS AND CATCHES. LOCKS MUST BE COMPATIBLE WITH BUILDING STANDARD KEY SYSTEM AND WHEN NONE EXISTS, THEY SHALL BE SIMILAR TO A YALE NO. 911 KEY.

F. DISTRIBUTION AND SUB-DISTRIBUTION PANELBOARD SHALL BE A MINIMUM OF 30" WIDE AND 10" DEEP.

G. ALL STANDARD PANELBOARDS SHALL BE A MINIMUM OF 20" WIDE AND 5 3/4" DEEP.

H. FURNISH ALL PANELBOARDS WITH FEED-THRU LUGS UNLESS OTHERWISE INDICATED ON THE DRAWINGS.

I. ALL NEW PANELBOARDS SHALL BE PROVIDED WITH AN ENGRAVED WHITE CORE LAMACOID NAMEPLATE, WITH 3/4 IN. WHITE LETTERING ON A BLACK BACKGROUND, WITH DESIGNATION LISTED (PANELBOARD NAME), FASTENED WITH EPOXY CEMENT OR OVAL HEAD CHROME PLATED MACHINE SCREWS.

J. THE CIRCUIT DIRECTORY SHALL BE TYPEWRITTEN AND PROVIDED INSIDE EACH PANEL DOOR TO INDICATE EQUIPMENT AND/OR AREA SERVED. DIRECTORY HOLDER SHALL BE METAL FRAME WITH CLEAR PLASTIC, TRANSPARENT COVER. THE TYPEWRITTEN LIST INDICATING CIRCUIT NUMBERS, OUTLETS SUPPLIED AND THEIR LOCATIONS SHALL BE PROVIDED.

K. TIE-BARS SHALL NOT BE USED TO CREATE MULTI-POLE CIRCUITS. MAXIMUM 42 CIRCUITS ALLOWED.

L. ONLY ONE WIRE SHALL BE INSTALLED UNDER EACH CIRCUIT BREAKER LUG.

M. SHORT CIRCUIT RATING OF PANELBOARDS SHALL NOT BE LESS THAN AS INDICATED ON THE CONTRACT DRAWINGS OR SPECIFIED HEREIN. WHERE NOT INDICATED OR SPECIFIED THE MINIMUM SHORT CIRCUIT RATING SHALL BE EQUAL TO THE INTERRUPTING CAPACITY OF THE LOWEST RATED CIRCUIT BREAKER IN THE PANELBOARD, BUT IN NO CASE LESS THAN 10,000 AMPERES R.M.S. SYMMETRICAL FOR 208Y/120 VOLT SYSTEM AND 14,000 AMPERES R.M.S. SYMMETRICAL FOR 480Y/277 VOLT SYSTEM. SERIES RATED PANELBOARDS SHALL BE USED TO ACHIEVE REQUIRED SHORT CIRCUIT RATINGS.

N. FOR ALL EXISTING PANELBOARDS, CONTRACTOR SHALL PROVIDE NEW CIRCUIT BREAKERS TO REPLACE EXISTING AS REQUIRED AS INDICATED ON DRAWINGS.

16. INTERCOM CONDUIT SYSTEM:

A. PROVIDE COMPLETE SYSTEM OF: RACEWAYS AND ACCESSORIES, OUTLET BOXES, SLEEVES AND FISHWIRES.

B. EQUIPMENT SHALL CONFORM TO REQUIREMENTS OF INTERCOM MANUFACTURER.

C. OUTLETS SHALL BE:

1)WALL: 4 IN. SQUARE WITH SINGLE GANG COVER PLATE.

D. PROVIDE FISHWIRES, IN RACEWAYS OVER 10 FT LONG.

E. CONDUIT SHALL BE 3/4 IN. MINIMUM. FURNISH EMPTY CONDUIT FROM EACH APARTMENT TO MAIN INTERCOM CONTROLLER AT ENTRANCE.

Property of NY Engineers

PROJECT:
REDLINE ATHLETICS - FLEMINGTON NJ

DRAWING TITLE:
ELECTRICAL SPECIFICATIONS (2 OF 2)

SHEET:
E-003

GENERAL NOTES:

1. VERIFY ALL LUMINAIRE COLORS, TRIMS, LENGTHS, ETC. WITH THE ARCHITECT PRIOR TO PLACING FINAL PURCHASE ORDERS. SUBMISSION PF SHOP DRAWINGS WILL BE INTERPRETED AS HAVING BEEN COORDINATED WITH THE ARCHITECTURAL DRAWINGS .
2. PROVIDE ALL LENGTHS, FEEDS, ACCESSORIES, CONNECTORS, WIRING, POWER SUPPLIES, DRIVERS ETC. FOR A COMPLETE INSTALLATION. THE E.C. SHALL VERIFY THE COMPLETE BILL OF MATERIAL WITH MANUFACTURER'S REPRESENTATIVE AND ENSURE ALL EQUIPMENT ARE INCLUDED IN BID PRICE. COORDINATE INSTALLATION WITH ARCHITECTURAL DETAILS.
3. VERIFY FINAL LUMINAIRE LOCATIONS WITH OTHER CEILING MOUNTED EQUIPMENTS SUCH AS DIFFUSER WITH ARCHITECTURAL REFLECTED CEILING PLANS.
4. VERIFY EXACT MOUNTING HEIGHT AND LOCATIONS OF ALL WALL MOUNTED LUMINAIRE WITH ARCHITECTURAL PLANS AND ELEVATIONS PRIOR TO ROUGH-IN
5. ANY PROPOSED ALTERNATE LUMINAIRES SHALL BE APPROVED BY THE ARCHITECT PRIOR TO FINAL BID PRICING.
6. EXIT SIGNS SHALL BE DUAL VOLTAGE WITH RED FACE LETTERING.
7. E.C. TO CONFIRM THE FINAL SELECTION OF LIGHTING FIXTURE WITH OWNER/ARCHITECT/MANUFACTURER PRIOR TO PROCUREMENT.
8. PLACEMENT OF LIGHT FIXTURES SHALL BE SET AS DIMENSIONED & AS SCHEDULED.
9. E.C. TO ENSURE THAT THE LIGHT FIXTURES ARE SCHEDULED WITHOUT EXCEPTIONS. E.C.. MUST OBTAIN APPROVAL FOR ANY ALTERNATE MAKES AND MODEL NUMBERS OF FIXTURES.
10. ALL NIGHT LAMPS AND EXIST LIGHTS SHALL BE CONNECTED TO NEAREST LIGHTING CIRCUIT IN THE AREA AHEAD OF ALL LIGHTING CONTROL MEANS IN ORDER TO BE ENERGIZED AT ALL TIME.
11. CONTRACTOR SHALL CALL FOR INSPECTION OF ALL UNDERGROUND WORK.
12. SWITCH HEIGHT SHALL BE A MAXIMUM OF 48" A.F.F. TO TOP OF DEVICE, UNLESS OTHERWISE NOTED.
13. ALL OUTDOOR CABINETS AND DISCONNECTS TO BE OFF WALL OR SURFACE A MINIMUM OF 1/4".
14. NEUTRALS SHALL NOT BE SHARED.
15. TIME SWITCHES SHALL FUNCTION ON A SCHEDULED BASIS USING TIME-OF-DAY WITH AN INDEPENDENT PROGRAM SCHEDULE THAT CONTROLS THE INTERIOR LIGHTING.
16. THE LOW VOLTAGE CONTRACTOR SHALL PROVIDE REQUIRED LOW VOLTAGE WIRING FOR SPEAKERS, RECEIVERS, INTERNET AT POS ON SHELF AND VOICE/FAX.
17. E.C. SHALL COORDINATE THE EXACT POWER REQUIREMENT & LOCATION FOR FUTURE BARN FARM FANS WITH EQUIPMENT MANUFACTURER/ARCHITECT IN FIELD PRIOR TO BID. MAKE POWER PROVISION ACCORDINGLY. BASE BID ACCORDINGLY.

KEY NOTES: (#)

1. WIRE ALL EXIT AND NIGHT LIGHTS TO THE NEAREST CIRCUIT AHEAD OF ALL CONTROLS & SWITCHING FOR CONTINUOUS OPERATION.
2. CONNECT CCTV TO THE SECURITY PANEL. G.C. TO COORDINATE LOCATION OF CAMERAS AND SPEAKERS WITH LV PLANS. CONTRACTOR TO PROVIDE REQUIRED CONDUIT, WIRING, AND TERMINATIONS PER MANUFACTURER REQUIREMENTS
3. PROPOSED TIMECLOCK LOCATION. E.C. TO COORDINATE FINAL LOCATION AND DEVICE TIME SETTINGS WITH OWNER. TIMECLOCK SHALL BE DIGITAL , 24 HOUR, 7 DAY TYPE WITH HOLIDAY OVERRIDE, BATTERY BACK-UP AND MANUAL CONTROL. TIME CLOCK SHALL INCORPORATE AUTOMATIC HOLIDAY SHUT OFF FEATURE AND HAVE PROGRAM BACK-UP WHICH PREVENT LOSS OF PROGRAM AND TIME SETTING FOR AT LEAST 10 HOURS IF POWER IS INTERRUPTED.
4. FIELD VERIFY THE EXACT LOCATION AND MOUNTING HEIGHT OF EXIT SIGN WITH THE OWNER BEFORE INSTALLATION.
5. PROPOSED LOCATION OF LIGHTING SWITCH BANK. THE LIGHT SWITCH HEIGHT INCLUDING TOP OF COVER PLATE TO BE BELOW 4' A.F.F. COORDINATE SWITCHES WITH CHAIR RAILS, TRANSITION BETWEEN TILED AND UNTILED SURFACES, COUNTER/BACKSPLASES ETC.
6. MANUAL OVERRIDE SWITCH. E.C. TO COORDINATE THE LOCATION WITH ARCHITECT/OWNER. AS PER IECC C405.2.2.1(5.3).
7. WALL MOUNTED OCCUPANCY SENSOR LUTRON LEVITON# OSSMT-MDW OR EQUAL. E.C. TO COORDINATE EXACT LOCATION OF OCCUPANCY SENSOR WITH ARCHITECT/OWNER PRIOR TO ROUGH-IN.
8. EXTERNAL SIGNAGE & SHOW WINDOW CONTROL BY PHOTOCELL AND TIME CLOCK. E.C. TO COORDINATE WITH ARCHITECT FOR EXACT LOCATION OF TIME CLOCK.
9. JUNCTION BOX WITH TOGGLE DISCONNECT PER NEC FOR CONNECTION TO BUILDING SIGNAGE. VERIFY EXACT LOCATION AND CONNECT TO SIGN PER MANUFACTURE'S INSTRUCTION. THE CONTRACTOR SHALL PROPERLY SIZE THE JUNCTION BOX BASED ON THE QUANTITY OF CONNECTIONS REQUIRED. VERIFY LOCATION WITH ARCHITECTURAL DRAWINGS AND SIGN VENDOR PRIOR TO INSTALLING. ALL SIGNS SHALL BE CONTROLLED VIA TIME CLOCK.


ELECTRONIC TIME SWITCH NOTES:

A. INTERMATIC TIMER BOX SHALL BE LOCATED AS CLOSE TO PANELBOARD AS PRACTICAL. PROVIDE WIRING FROM LOW VOLTAGE SWITCH TO RELAY CABINET REQUIRED FOR EACH RELAY AS REQUIRED.

B. PROGRAM LIGHTING SCHEDULE AND HOURS OF OPERATION WITH OWNER.

C. PROVIDE LOW VOLTAGE OVERRIDE SWITCH AS INDICATED ON DRAWINGS ITERMATIC ET2125C SERIES OR EQUIVALENT. LOW-VOLTAGE OVERRIDE SWITCH CONTROLS SHALL INITIATE AN OVERRIDE OF A MAXIMUM TIME OF NO MORE THAN TWO (2) HOURS.

D. PROVIDE TWO (2) HOUR TRAINING ON PROGRAMMING OF SYSTEM & SYSTEM OPERATION.

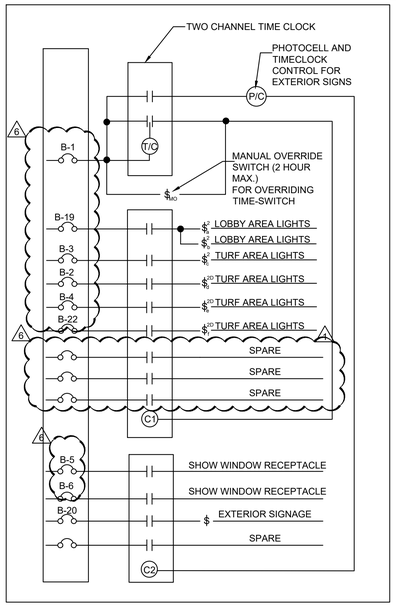


2 TIME CLOCK WIRING DIAGRAM
N.T.S.

LIGHT FIXTURE SCHEDULE - D3 TYP.

TAG	COUNT	DESCRIPTION	MANUFACTURER	MODEL NUMBER	FINISH	COLOR TEMPERATURE	LAMP	COMMENTS
EL-1	8	EXIT SIGN, SINGLE FACE	SURE LITES	APCH7R	RED ON WHITE			
EL-2	3	EXIT SIGN, DOUBLE FACE	SURE LITES	APC7R	RED ON WHITE			
L1	2	RECESSED LED, 5"	HALO	5001P	WHITE	2700K	120V, 14W	FOR RESTROOMS ONLY
L1-EM	2	RECESSED LED, 5" (EMERGENCY)	HALO	5001P	WHITE	2700K	120V, 14W	FOR RESTROOMS ONLY
L2	8	2'X2' TROFFER	LITHONIA LIGHTING	2VTS2 ADSM	WHITE	2700K	T-12, 40W	LOBBY, EMPLOYEE ROOM, JANITOR'S CLOSET, STORAGE AND OFFICE
L2-EM	10	2'X2' TROFFER	LITHONIA LIGHTING	2VTS2 ADSM	WHITE	2700K	T-12, 40W	LOBBY, EMPLOYEE ROOM, JANITOR'S CLOSET, STORAGE AND OFFICE
L4	12	LED Round High Bay	Acuity Brands, Inc. /EQUIVALENT	REBL ALO16 UVOLT SWW3 80CRI DWH M2 EMERGENCY	BLACK	3500K	LED, 200W	TRAINING AREA
L4-EM	13	LED Round High Bay	Acuity Brands, Inc. /EQUIVALENT	REBL ALO16 UVOLT SWW3 80CRI DWH M2 EMERGENCY	BLACK	3500K	LED, 200W	TRAINING AREA
SDCO	7	The Signature Series model SIGA-PD Intelligent Photoelectric Smoke Detector is an intelligent device that uses an optical sensing chamber to detect smoke	UTC Climate, Controls & Security	SIGA-PD w/ SIGA-SB base				

LIGHT FIXTURE LEGEND

ACT DROP IN, 2x2	EMERGENCY
RECESSED CAN	EMERGENCY
PENDANT	
EXIT SIGN	
LED Gym High Bay Lights	L4 L4-EM

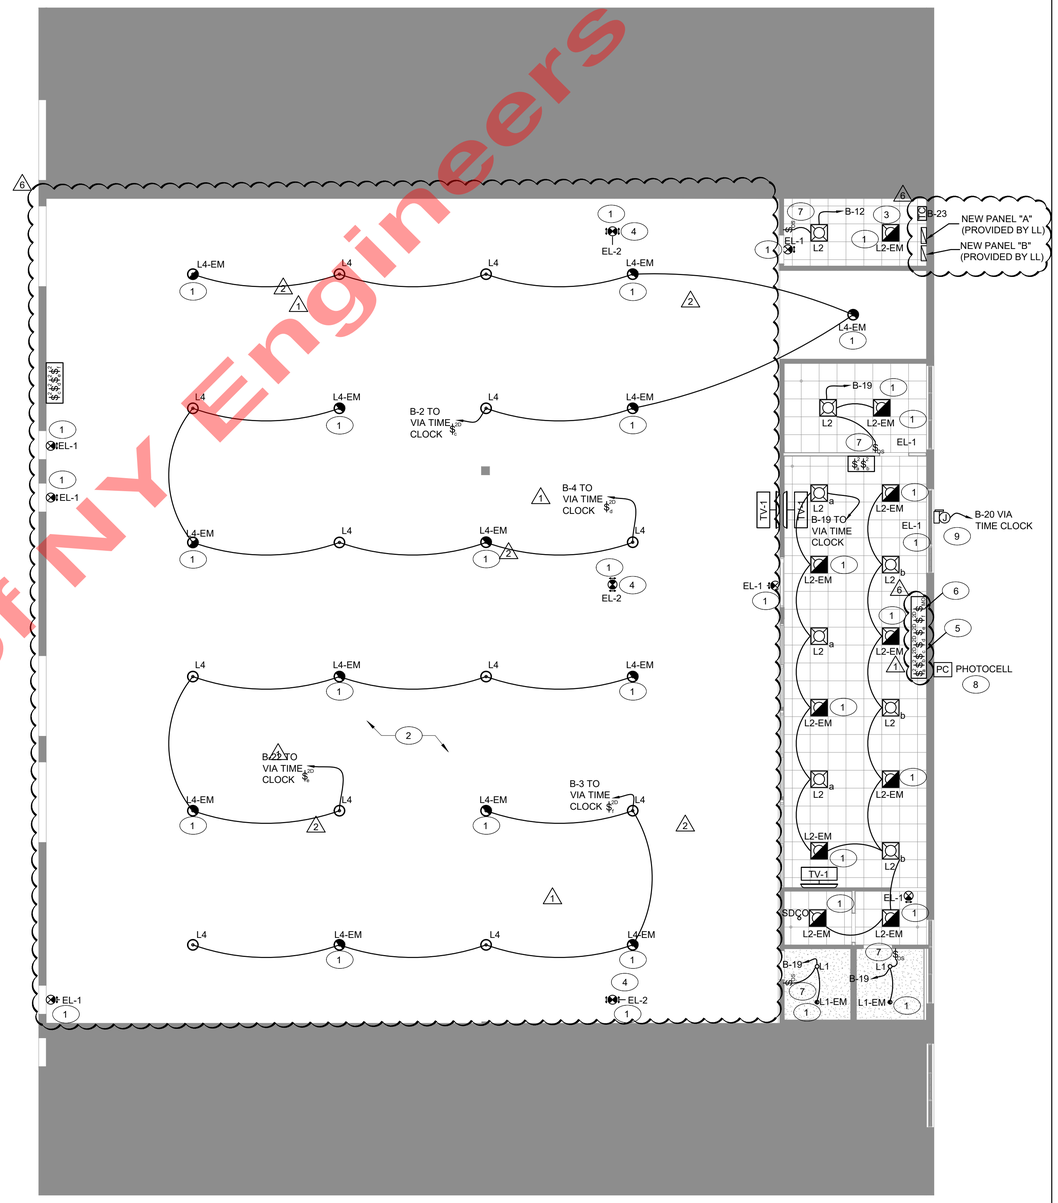

1 LIGHTING PLAN
SCALE: 1/8" = 1'-0"

Property of NY Engineers

PROJECT:
REDLINE ATHLETICS - FLEMINGTON NJ

DRAWING TITLE:
LIGHTING PLAN


SHEET:
E-101

GENERAL NOTES:

1. ALL 208 VOLT AND 120 VOLT, SINGLE PHASE RECEPTACLES 50A OR LESS, AND 208V, 3 PHASE RECEPTACLES 100A OR LESS INSTALLED OUTDOORS, IN BATHROOMS, KITCHENS AND ON ROOFTOP AREAS SHALL HAVE GROUND-FAULT CIRCUIT INTERRUPTER PROTECTION.
2. PROVIDE 1"C FROM TELEPHONE BACKBOARD TO CASH REGISTER FOR EXTENSION OF TWO (2) CAT 5 DATA LINES.
3. COORDINATE EXACT LOCATION OF HVAC EQUIPMENTS ON ABOVE CEILING WITH MECHANICAL CONTRACTOR.
4. E.C. SHALL COORDINATE DISCONNECT AND FUSE REQUIREMENT FOR MECHANICAL UNIT WITH MECHANICAL CONTRACTOR AND EQUIPMENT MANUFACTURER FOR FINAL SELECTION PRIOR TO ROUGH-IN. E.C. COORDINATE LOCATION OF DISCONNECT SWITCH WITH MANUFACTURER AND MECHANICAL CONTRACTOR PRIOR TO ROUGH-IN. LOCATE AS REQUIRED TO MAINTAIN NEC CLEARANCES.
5. THE LOW VOLTAGE CONTRACTOR SHALL PROVIDE REQUIRED LOW VOLTAGE WIRING FOR SPEAKERS, RECEIVERS, INTERNET AT POS ON SHELF AND VOICE/FAX.
6. MAIN FEEDERS FROM SERVICE DISCONNECT TO PANEL AND FROM MAIN PANEL TO SUB PANEL SHALL BE STANDARD METAL CONDUIT.
7. CONDUITS BELOW SLAB SHALL BE PVC CONDUITS. ENCLOSED CONDUIT SCAN EITHER BE METAL CONDUITS OR FLEXIBLE CONDUITS. ANY EXPOSED CONDUITS SHALL BE METAL CONDUITS ONLY.
8. EXPOSED CONDUITS WITHIN FOOD PREP AREA MUST HAVE SMOOTH SURFACE FOR CLEANING PER HEALTH DEPARTMENT REQUIREMENTS AND SHALL BE STANDARD METAL CONDUITS.
9. CONDUITS BELOW SLAB SHALL BE PVC CONDUITS. ENCLOSED CONDUIT SCAN EITHER BE METAL CONDUITS OR FLEXIBLE CONDUITS. ANY EXPOSED CONDUITS SHALL BE METAL CONDUITS ONLY.
10. COORDINATE EXACT LOCATION OF HVAC EQUIPMENTS ON ROOF WITH MECHANICAL CONTRACTOR.
11. PROVIDE SINGLE GANG JUNCTION BOX FOR EACH TELEPHONE AND /OR DATA OUTLET WITH 3/4" C. STUBBED-UP TO 6" WALL ABOVE PARTITION OR, LAY-IN CEILING. PROVIDE BLANK COVER PLATE ON EACH OUTLET.

KEY NOTES: (#)

1. FIELD VERIFY ALL LOCATIONS OF ALL DATA AND POWER OUTLETS.
2. SHOW WINDOW RECEPTACLES SHALL BE SPACED AT NOT MORE THAN 12'-0" O.C. AND INSTALLED WITHIN 18" ABOVE TOP OF WINDOWS PER NEC 210.62.
3. PROVIDE SMOKE DETECTORS AS SHOWN IN ACCORDANCE WITH IBC 2018 915.5. SMOKE DETECTORS SHALL COMPLY WITH NFPA 72 AND SHALL BE UL 268 LISTED. COMBINATION CARBON MONOXIDE/SMOKE DETECTORS SHALL BE UL 2075 AND UL 268 LISTED. PROVIDE CO DETECTORS BY UTC CLIMATE CONTROLS OR APPROVED EQUIVALENT.
4. TELEPHONE/DATA OUTLET. 2"x4" JUNCTION BOX AND 1" CONDUIT 2" ABOVE GRID. JACK AND WIRING BY OTHERS.
5. PROVIDE A 2"X4" JUNCTION BOX WITH CONDUIT AND PULL STRING ADJACENT TO THE TV OUTLETS. LOW VOLTAGE CONTRACTOR SHALL PROVIDE CABLE & CONNECT TO MAIN. CONDUITS SHALL BE EXTENDED TWO INCHES ABOVE GRID.
6. ALL RECEPTACLES IN LOBBY AREA SHALL BE TAMPER RESISTANT ELECTRICAL RECEPTACLE OUTLETS PER NEC 406.12.
7. PROVIDE SECURITY PANEL AS SHOWN, CONNECT NEW DEVICES TO THE SECURITY PANEL AND PROGRAM AS REQUIRED. UTILIZE CIRCUITS SHOWN IN PANEL. PROVIDE ADDITIONAL CIRCUITS AS NEEDED.
8. RUN AT LEAST 2"C CONDUIT FROM TELEPHONE COMPANY POINT OF SERVICE TO TELEPHONE BACKBOARD IF REQUIRED. FIELD VERIFY LOCATION.
9. CONTRACTOR TO PROVIDE AND INSTALL A COMMERCIAL-GRADE REMOTE WI-FI ENABLED SMART DOOR LOCK, COMPLETE WITH ALL REQUIRED POWER SUPPLIES, CONTROLLERS, AND ACCESSORIES FOR FULL OPERATION. LOCK SHALL INTEGRATE WITH OWNER'S SMARTPHONE/CLOUD APPLICATION FOR REMOTE MONITORING AND CONTROL. PROVIDE MANUAL KEY OVERRIDE AND ENSURE LOCK IS UL LISTED AND COMPLIANT WITH LOCAL BUILDING/FIRE CODE EGRESS REQUIREMENTS. COORDINATE INSTALLATION WITH SECURITY SYSTEM VENDOR.
10. NOT USED.
11. ELECTRICAL CONTRACTOR SHALL COORDINATE DISCONNECT, FUSE/MANUAL MOTOR SWITCH REQUIREMENT FOR MECHANICAL UNIT WITH MECHANICAL CONTRACTOR AND EQUIPMENT MANUFACTURER FOR FINAL SELECTION PRIOR TO ROUGH-IN. E.C. COORDINATE LOCATION OF DISCONNECT SWITCH/JUNCTION BOX WITH MANUFACTURER AND MECHANICAL CONTRACTOR PRIOR TO ROUGH-IN. LOCATE AS REQUIRED TO MAINTAIN NEC CLEARANCES.
12. EF-1(N) AND EF-2(N) SHALL BE INTERLOCKED WITH ROOM LIGHT. E.C. SHALL COORDINATE WITH MECHANICAL CONTRACTOR FOR MORE DETAILS. MAKE POWER PROVISION ACCORDINGLY. BASE BID ACCORDINGLY.
13. DISCONNECT FOR WATER HEATER. E.C. TO COORDINATE WITH PLUMBING CONTRACTOR FOR EXACT LOCATION AND ELECTRICAL POWER SUPPLY REQUIREMENT IN FIELD.
14. EXISTING MECHANICAL EQUIPMENTS SHALL REMAIN. E.C. SHALL RECONNECT THE EXISTING MECHANICAL EQUIPMENT TO THE NEW CIRCUIT AS SHOWN IN PLAN. THE E.C. SHALL VERIFY AVAILABILITY/OPERABILITY OF THE EXISTING JUNCTION BOX FOR EXISTING MECHANICAL EQUIPMENTS IN THE FIELD . PROVIDE NEW IN CASE OF UNAVAILABILITY / UNOPERABILITY . E.C. SHALL ALSO VERIFY EXACT ELECTRICAL REQUIREMENT FOR NEW JUNCTION BOX OF EXISTING MECHANICAL EQUIPMENTS AS PER THE MANUFACTURER'S CUT-SHEET. INFORM ENGINEER ON RECORD FOR ANY DISCREPANCY PRIOR TO BID. REPLACE IF FOUND IN OPERABLE. BASE BID ACCORDINGLY.
15. JUNCTION BOX FOR MOTORIZED/FIRE SMOKE DAMPER. E.C. TO FIELD VERIFY EXACT LOCATION OF MOTORIZED/FIRE SMOKE DAMPER WITH MECHANICAL CONTRACTOR PRIOR TO ROUGH-IN.
16. E.C. SHALL PROVIDE A DEDICATED 120V, 1Ø, 20A CIRCUIT TO THE SPALDING 120V KEY-OPERATED CONTROL SWITCH AND EXTEND TO THE MOTORIZED BATTING CAGE MOTOR. COORDINATE FINAL LOCATIONS AND REQUIREMENTS WITH THE OWNER AND EQUIPMENT SUPPLIER. E.C. SHALL ALSO COORDINATE WITH MANUFACTURER FOR ALL REQUIRED EQUIPMENT FOR THE INSTALLATION OF THE MOTORIZED BATTING CAGE MOTOR.
17. INDOOR UNIT POWERED BY OUTDOOR UNIT. E.C. TO COORDINATE THE EXACT LOCATION OF MECHANICAL EQUIPMENTS WITH MECHANICAL CONTRACTOR. INFORM ENGINEERS FOR ANY DISCREPANCY FOUND.
18. E.C. SHALL COORDINATE THE EXACT ELECTRICAL REQUIREMENT/LOCATION FOR THE EQUIPMENT WITH EQUIPMENT MANUFACTURER/ ARCHITECT PRIOR TO BID. MAKE POWER PROVISION ACCORDINGLY. BASE BID ACCORDINGLY.
19. E.C. SHALL COORDINATE THE EXACT POWER REQUIREMENT & LOCATION/QUANTITIES FOR FUTURE BARN FARM FANS WITH EQUIPMENT MANUFACTURER/ARCHITECT IN FIELD PRIOR TO BID. MAKE POWER PROVISION ACCORDINGLY. MOUNT THE OUTLET ACCORDINGLY. BASE BID ACCORDINGLY.
20. E.C. SHALL COORDINATE THE EXACT POWER REQUIREMENT & LOCATION/QUANTITIES FOR PORTABLE DEHUMIDIFIERS WITH EQUIPMENT MANUFACTURER/ARCHITECT IN FIELD PRIOR TO BID. MAKE POWER PROVISION ACCORDINGLY. MOUNT THE OUTLET ACCORDINGLY. BASE BID ACCORDINGLY.
21. LANDLORD'S OFFICE ELECTRICIAN SHALL COORDINATE AND TIE INTO THE TIMECLOCK PROVIDED UNDER TENANT ELECTRICAL SCOPE. VERIFY FINAL CONTROL REQUIREMENTS AND INTERCONNECTIONS IN FIELD PRIOR TO INSTALLATION.
22. RECEPTACLES SERVING THE WAREHOUSE AREA LOCATED ON OFFICE WALLS SHALL BE PROVIDED UNDER TENANT GENERAL CONTRACTOR (GC) SCOPE. COORDINATE EXACT LOCATIONS AND INSTALLATION REQUIREMENTS WITH TENANT PRIOR TO ROUGH-IN.

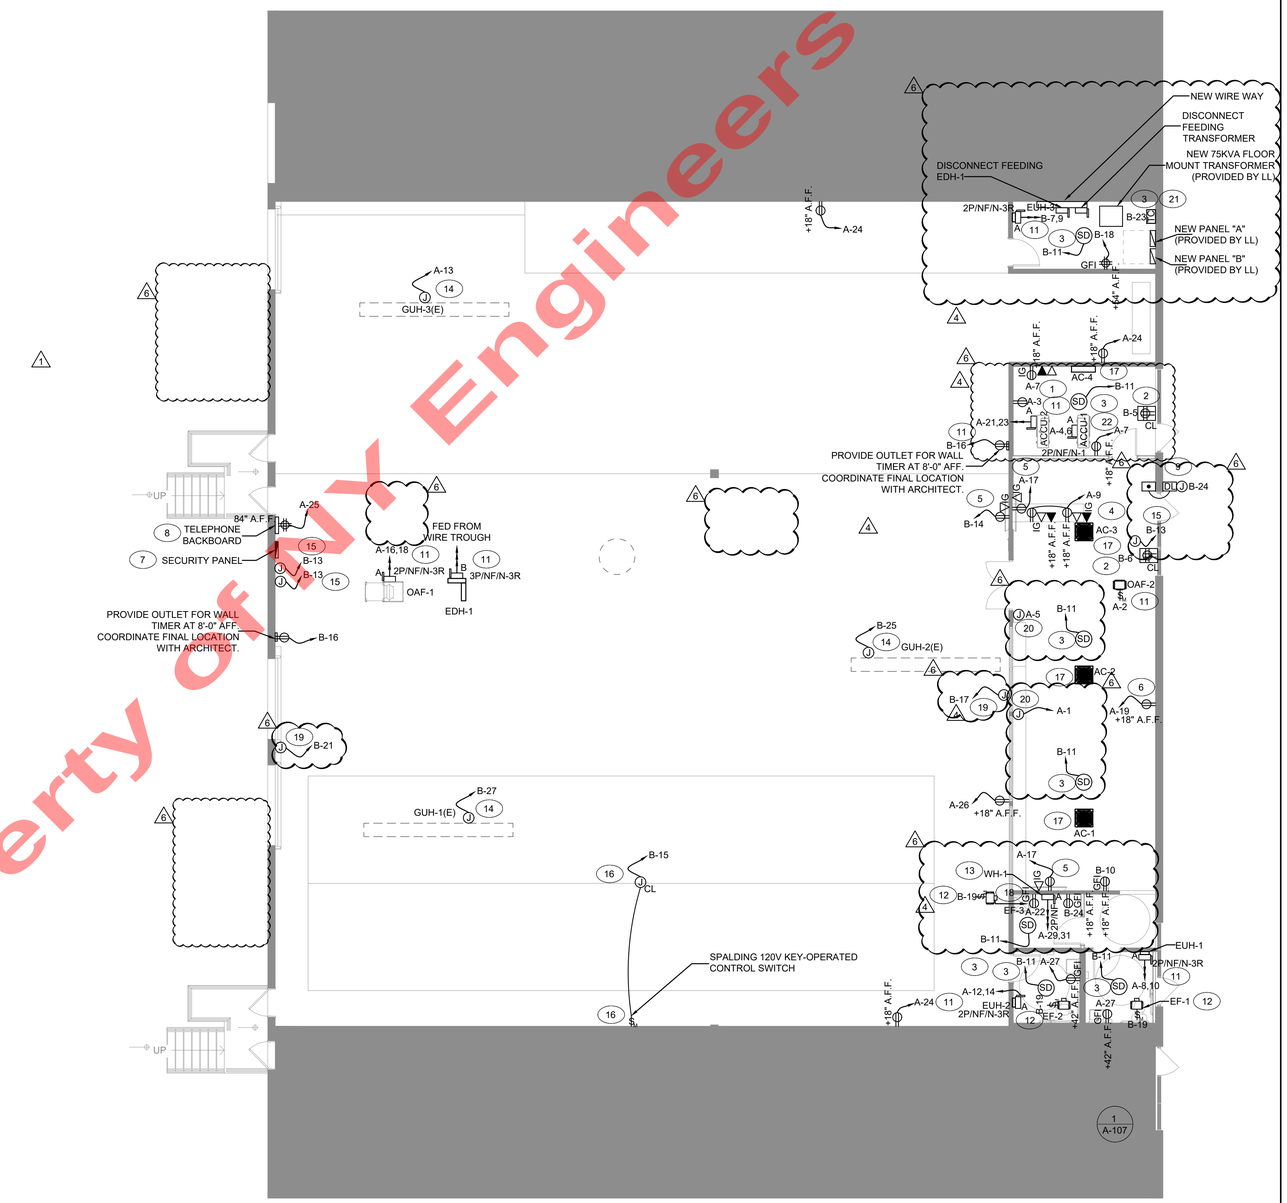

1 ELECTRICAL POWER PLAN
SCALE: 1/8" = 1'-0"


Property of NY Engineers

PROJECT:
REDLINE ATHLETICS - FLEMINGTON NJ

DRAWING TITLE:
ELECTRICAL POWER PLAN


SHEET:
E-201

NOTE:
THIS INFORMATION MAY NOT CONTAIN ALL DETAILS REQUIRED FOR CONSTRUCTION. APPROPRIATE MODIFICATION MAY BE REQUIRED TO ENSURE SUITABILITY OF THESE DRAWINGS FOR THE SPECIFIC APPLICATION. IT IS THE USER'S RESPONSIBILITY TO ENSURE INSTALLATION OF THE EQUIPMENT/SYSTEM IS IN ACCORDANCE WITH BUILDING/PROJECT SPECIFICATIONS, APPLICABLE CODES AND STANDARDS.

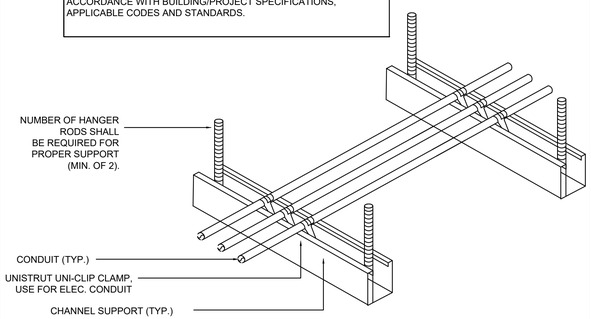


NOTES:
1. ALL CONDUIT MAY BE COMBINED ON SAME SUPPORT CHANNEL WHERE PRACTICAL.
2. SUPPORT CHANNEL LENGTH SHALL NOT BE DETERMINED UNTIL ALL PIPING, CONDUIT, ETC. TO BE SUPPORTED IS COORDINATED.
3. SUPPORT CHANNEL SPACING SHALL BE NO MORE THAN 10'-0".
4. UNISTRUT AND CONDUIT INSTALLATION MAY BE REVERSED.

1 CONDUIT SUPPRT DETAIL
N.T.S.

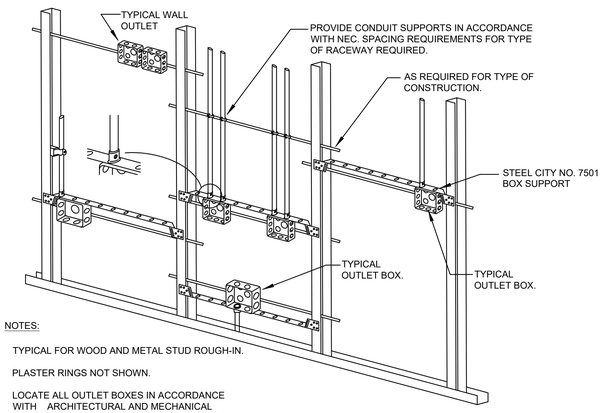

NOTES:
1. TYPICAL FOR WOOD AND METAL STUD ROUGH-IN.
2. PLASTER RINGS NOT SHOWN.
3. LOCATE ALL OUTLET BOXES IN ACCORDANCE WITH ARCHITECTURAL AND MECHANICAL DRAWINGS, AND WITH ALL APPLICABLE SHOP DRAWINGS.
4. IN ACCORDANCE WITH UBC 4304 OUTLETS ON OPPOSITE SIDES OF WALLS OR PARTITIONS IN THE SAME STUD SPACE MUST BE SEPARATED BY A MIN. OF 24" HORIZONTAL DISTANCE.

2 DETAIL TYPICAL ROUGH-IN REQUIREMENTS
N.T.S.

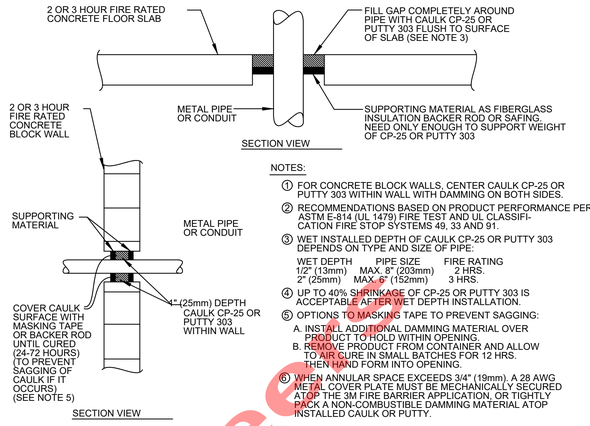


NOTES:
1. FOR CONCRETE BLOCK WALLS, CENTER CAULK CP-25 OR PUTTY 303 WITHIN WALL WITH DAMMING ON BOTH SIDES.
2. RECOMMENDATIONS BASED ON PRODUCT PERFORMANCE PER ASTM E-814 (UL 1479) FIRE TEST AND UL CLASSIFICATION FIRE STOP SYSTEMS 49, 33 AND 91.
3. WET INSTALLED DEPTH OF CAULK CP-25 OR PUTTY 303 DEPENDS ON TYPE AND SIZE OF PIPE:

WET DEPTH	PIPE SIZE	FIRE RATING
1/2" (13mm)	MAX. 8" (203mm)	2 HRS.
2" (25mm)	MAX. 6" (152mm)	3 HRS.

4. UP TO 40% SHRINKAGE OF CP-25 OR PUTTY 303 IS ACCEPTABLE AFTER WET DEPTH INSTALLATION.
5. OPTIONS TO MASKING TAPE TO PREVENT SAGGING:
   A. INSTALL ADDITIONAL DAMMING MATERIAL OVER PRODUCT TO HOLD WITHIN OPENING.
   B. REMOVE PRODUCT FROM CONTAINER AND ALLOW TO AIR CURE IN SMALL BATCHES FOR 12 HRS. THEN HAND FORM INTO OPENING.
6. WHEN ANNULAR SPACE EXCEEDS 3/4" (19mm), A 28 AWG METAL COVER PLATE MUST BE MECHANICALLY SECURED ATOP THE 3M FIRE BARRIER APPLICATION, OR TIGHTLY PACK A NON-COMBUSTIBLE DAMMING MATERIAL ATOP INSTALLED CAULK OR PUTTY.

3 FIRE SUPPORT DETAIL
N.T.S.

NOTES:
1. ALL CONDUCTORS IN VERTICAL RACEWAYS SHALL BE SUPPORTED IN ACCORDANCE WITH ARTICLE 300.19 OF NEC. CABLE SUPPORTS SHALL BE LOCATED AT THE INTERVALS REQUIRED BY THE NEC.
2. CABLE SUPPORT SYSTEM SHALL BE AS MANUFACTURED BY O-Z GEDNEY WITH pOZI-GRIP "S-STYLE" WEDGING PLUG OR APPROVED EQUAL.
3. FOR THREADLESS CONDUIT (RIGID, IMC OR EMT), ATTACH CONDUIT BODY TO MALE THREADS OF A SET SCREW OR COMPRESSION CONNECT, AS PERMITTED BY SPECIFICATIONS.
4. PROVIDE PULL BOX AT EACH LOCATION OF CABLE SUPPORTS. PULL BOX SHALL BE SIZED AS PER CODE TO ACCOMMODATE ALL CONDUITS.

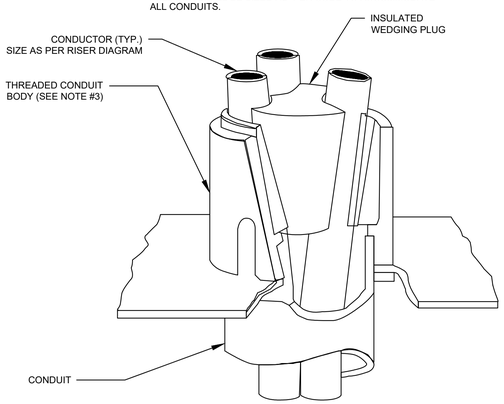


4 VERTICAL CABLE SUPPORT DETAIL
N.T.S.

MANUAL MODE OPERATION:
1. PUSHBUTTON PRESS IS REQUIRED TO TURN LOAD ON.
2. LOAD TURNS OFF WHEN SENSOR TIMES OUT OR BY PRESSING PUSH BUTTON.
3. IF DAYLIGHT SENSOR IS ENABLED AND LIGHT LEVEL IS ABOVE SETPOINT, LOAD WILL NOT TURN ON.

AUTOMATIC MODE OPERATION:
1. WHEN SENSOR ACTIVATES LOAD TURNS ON.
2. PUSHBUTTON CAN BE USED TO TURN LOAD ON OR OFF. IF PUSHBUTTON IS USED TO TURN LOAD OFF, SENSOR MUST TIME OUT FIRST, BEFORE LOAD CAN TURN BACK ON AUTOMATICALLY.
3. IF DAYLIGHT SENSOR IS ENABLED AND LIGHT LEVEL IS ABOVE SETPOINT, LOAD WILL NOT TURN ON.

SENSOR TYPES INCLUDE:
ONW-D-1001-MV-N

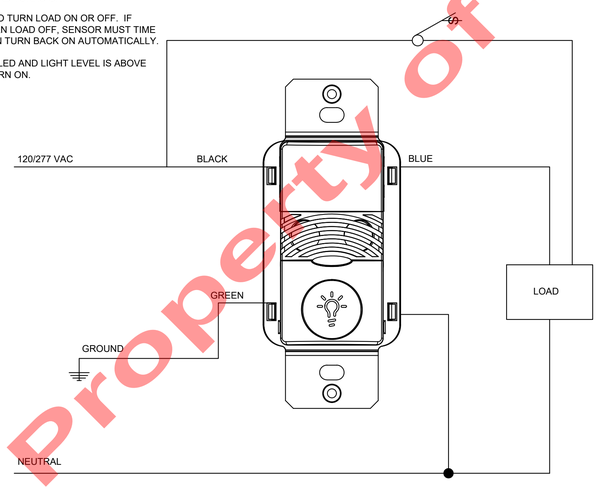

5 LOW VOLTAGE WALL SWITCH SENSOR(NEUTRAL CONNECTION) OCCUPANCY/VACANCY - SINGLE LEVEL
N.T.S.

Property of NY Engineers

PROJECT:
REDLINE ATHLETICS - FLEMINGTON NJ

DRAWING TITLE:
ELECTRICAL DETAILS

SHEET:
E-301

PANEL: A (NEW)

MOUNTING: SURFACE

208Y/120 VOLTS, 3 PHASE, 4 WIRE — PANEL LOCATION: BOH

MAIN CB: 200A — MLO: NA — BUS: 225A — MIN, — FED FROM: 75 KVA TRANSFORMER

NOTE: L : LIGHTING, H : HVAC LOAD, M : MOTOR LOAD, R : RECEPTACLES, O : OTHER/MISC. (TYPICAL),* GFI BREAKER

CKT NO.	TRIP AMPS	DESCRIPTION OF LOAD	LOAD TYPE	LOAD (KVA)	MINIMUM BRANCH CIRCUIT	PER PHASE (KVA) A	B	C	MINIMUM BRANCH CIRCUIT	LOAD (KVA)	LOAD TYPE	DESCRIPTION OF LOAD	TRIP AMPS	CKT NO.
1	20	PORTABLE DEHUMIDIFIERS	H	0.18	2#12, #12G, 3/4"C	0.40			2#12, #12G, 3/4"C	0.22	M	OAF-2	15	2
3	20*	SERVICE RECEPTACLE	R	0.18	2#12, #12G, 3/4"C		2.16		2#10, #10G, 3/4"C	1.98	H	ACCU-1	2P-25	4
5	20	PORTABLE DEHUMIDIFIERS	H	0.18	2#12, #12G, 3/4"C			2.16		1.98	H			6
7	20	RECEPTACLES - OFFICE	R	0.36	2#12, #12G, 3/4"C	0.86			2#12, #12G, 3/4"C	0.50	H	EUH-1	2P-20	8
9	20	FRONT DESK RECEPTACLES	R	0.36	2#12, #12G, 3/4"C		0.86			0.50	H			10
11	20	CEILING FANS	M	0.98	2#12, #12G, 3/4"C			1.48	2#12, #12G, 3/4"C	0.50	H	EUH-2	2P-20	12
13	20	GUH-3(E)	H	0.31	2#12, #12G, 3/4"C	0.81				0.50	H			14
15	20	SPARE					1.04		2#12, #12G, 3/4"C	1.04	H	OAF-1	2P-15	16
17	20	TV RECEPTACLES - LOBBY	R	0.36	2#12, #12G, 3/4"C			1.40		1.04	H			18
19	20	RECEPTACLE - LOBBY	R	0.18	2#12, #12G, 3/4"C	0.18						SPARE	20	20
21	2P-25	ACCU-2	H	1.98	2#10, #10G, 3/4"C		2.16		2#12, #12G, 3/4"C	0.18	R	DEDICATED MOP SINK RECEPTACLE	20	22
23			H	1.98				2.52	2#12, #12G, 3/4"C	0.54	R	RECEPTACLES - CONVENIENCE	20	24
25	20	RECEPTACLE - TELEPHONE BACKBOARD	R	0.36	2#12, #12G, 3/4"C	0.36						SPARE	20	26
27	20	RECEPTACLES - RESTROOM	R	0.36	2#12, #12G, 3/4"C		0.36					SPARE	20	28
29	2P-20	WH-1	O	2.50	2#12, #12G, 3/4"C			2.50				SPARE	20	30
31			O	2.50		2.50						SPARE	20	32
33		SPACE					0.00					SPARE	20	34
35		SPACE						0.00				SPARE	20	36
37	3P-100	SUB-PANEL-B	O	5.34	4#3, #8G, 1 1/4"C	5.34						SPACE		38
39			O	8.43			8.43					SPACE		40
41			O	3.94				3.94				SPACE		42
		TOTAL CONNECTED LOAD (KVA)				10.45	15.00	14.00						

PANEL: B (NEW)

MOUNTING: SURFACE

208Y/120 VOLTS, 3 PHASE, 4 WIRE — PANEL LOCATION: BOH

MAIN CB: NA — MLO: 125A — BUS: 125A — MIN, — FED FROM: PANEL-A


NOTE: L : LIGHTING, H : HVAC LOAD, M : MOTOR LOAD, R : RECEPTACLES, O : OTHER/MISC. (TYPICAL)

CKT NO.	TRIP AMPS	DESCRIPTION OF LOAD	LOAD TYPE	LOAD (KVA)	MINIMUM BRANCH CIRCUIT	PER PHASE (KVA) A	B	C	MINIMUM BRANCH CIRCUIT	LOAD (KVA)	LOAD TYPE	DESCRIPTION OF LOAD	TRIP AMPS	CKT NO.
1	20	TIME CLOCK	O	0.20	2#12, #12G, 3/4"C	2.00			2#12, #12G, 3/4"C	1.80	L	TURF AREA LIGHT	20	2
3	20	TURF AREA LIGHT	L	1.80	2#12, #12G, 3/4"C		3.60		2#12, #12G, 3/4"C	1.80	L	TURF AREA LIGHT	20	4
5	20	SHOW WINDOW RECEPTACLE	L	1.00	2#12, #12G, 3/4"C			2.00	2#12, #12G, 3/4"C	1.00	L	SHOW WINDOW RECEPTACLE	20	6
7	2P-20	EUH-3	H	0.50	2#12, #12G, 3/4"C	0.50						SPARE	20	8
9			H	0.50			0.87		2#12, #12G, 3/4"C	0.37	O	DRINKING FOUNTAIN	20	10
11	20	SMOKE DETECTOR	O	0.20	2#12, #12G, 3/4"C			0.30	2#12, #12G, 3/4"C	0.10	L	STORAGE & STAFF BREAK AREA LIGHTS	20	12
13	20	MOTORIZED/FIRE SMOKE DAMPER	M	0.20	2#12, #12G, 3/4"C	0.38			2#12, #12G, 3/4"C	0.18	R	TV RECEPTACLE - TURF AREA	20	14
15	20	BATTING CAGE MOTOR	M	1.00	2#12, #12G, 3/4"C		1.36		2#12, #12G, 3/4"C	0.36	R	RECEPTACLES - WALL TIMER	20	16
17	20	FUTURE CEILING FAN	M	0.98	2#12, #12G, 3/4"C			1.34	2#12, #12G, 3/4"C	0.36	R	STORAGE & STAFF BREAK AREA RECEPTACLE	20	18
19	20	LOBBY, OFFICE AND JANI. CL. AND RESTROOM AREA LIGHTS +EF-1, EF-2 & EF-3	L	0.77	2#12, #12G, 3/4"C	1.97			2#12, #12G, 3/4"C	1.20	L	EXTERIOR SIGNAGE	20	20
21	20	FUTURE CEILING FAN	M	0.49	2#12, #12G, 3/4"C		2.29		2#12, #12G, 3/4"C	1.80	L	TURF AREA LIGHT	20	22
23	20	TIME CLOCK	O	0.20	2#12, #12G, 3/4"C			0.30	2#12, #12G, 3/4"C	0.10	O	WI-FI DOOR LOCK	20	24
25	20	GUH-2(E)	H	0.31	2#12, #12G, 3/4"C	0.49			2#12, #12G, 3/4"C	0.18	R	RECEPTACLES - JANI. CL.	20	26
27	20	GUH-1(E)	H	0.31	2#12, #12G, 3/4"C		0.31					SPARE	19	28
29	20	SPARE						0.00				SPARE	20	30
31	20	SPARE				0.00						SPARE	20	32
33	20	SPARE					0.00					SPARE	20	34
35	20	SPARE						0.00				SPARE	20	36
37		SPACE				0.00						SPACE		38
39		SPACE					0.00					SPACE		40
41		SPACE						0.00				SPACE		42
		TOTAL CONNECTED LOAD (KVA)				5.34	8.43	3.94						

GENERAL NOTES:

1. ALL ARE NEW BREAKERS UNLESS OTHERWISE NOTED.
2. ELECTRICAL CONTRACTOR TO VERIFY THE EXACT PANEL SIZES AND INCOMING FEEDER SIZE.
3. E.C. SHALL VERIFY THE EXISTING BREAKER RATING AND SIZES IN FIELD AND ACCORDINGLY UPDATE THE PANEL SCHEDULE TO MATCH THE EQUIPMENT REQUIREMENTS.

1 ELECTRICAL PANEL SCHEDULE
SCALE: N.T.S.

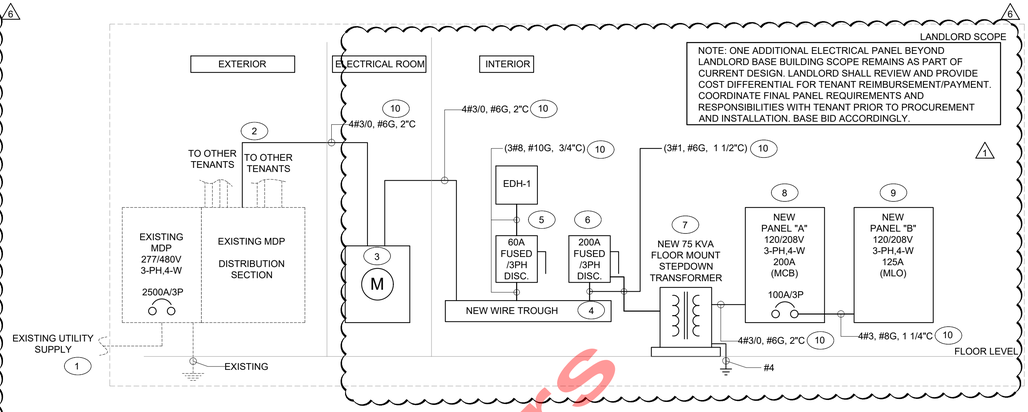

KEY NOTES: (#)

1. EXISTING 277/480V, 3-PHASE, 4-WIRE, ELECTRICAL SERVICE FROM UTILITY FOR THE ENTIRE SPACE SHALL REMAIN. E.C SHALL VERIFY EXACT ELECTRICAL DISTRIBUTION/INCOMING LOCATION/RATING/VOLTAGE/ PHASE/WIRE OF EXISTING ELECTRICAL SERVICE IN FIELD WITH ARCHITECT/OWNER. INFORM ENGINEER ON RECORD FOR ANY DISCREPANCY BEFORE COMMENCING ANY WORK. BASE BID ACCORDINGLY.
2. EXISTING 200A, 277/480V, 3-PHASE, 4-WIRE, ELECTRICAL SERVICE FROM EXISTING MDP DISTRIBUTION SECTION FOR THE PROJECT SPACE SHALL REMAIN. E.C SHALL VERIFY EXACT ELECTRICAL DISTRIBUTION/INCOMING LOCATION/RATING/VOLTAGE/ PHASE/WIRE OF EXISTING ELECTRICAL SERVICE IN FIELD WITH ARCHITECT/OWNER. INFORM ENGINEER ON RECORD FOR ANY DISCREPANCY BEFORE COMMENCING ANY WORK. BASE BID ACCORDINGLY.
3. NEW 200A, 277/480, 3-PHASE, 4-WIRE ELECTRICAL METER PROVIDED BY LANDLORD SERVING PROJECT SPACE. E.C. SHALL COORDINATE WITH OWNER /BASE BUILDING FOR LOCATION.
4. PROVIDE NEW WIRE TROUGH. SIZE PER CONDUCTOR FILL REQUIREMENTS AND INSTALL WITH REQUIRED SUPPORTS. E.C. SHALL COORDINATE LOCATION AND PROVIDE ALL NECESSARY ACCESSORIES FOR A COMPLETE INSTALLATION.
5. PROVIDE NEW 480V, 3-PHASE, 3-POLE, 60A, NEMA-1 FUSED DISCONNECT SWITCH FUSED AT 40A FOR EDH-1 , DISCONNECT SWITCHES SHALL BE HEAVY-DUTY, UL LISTED, AND SUITABLE FOR THE INTENDED APPLICATION. E.C. SHALL COORDINATE EXACT LOCATIONS AND EQUIPMENT CONNECTION REQUIREMENTS IN THE FIELD. PROVIDE ALL NECESSARY CONDUIT, WIRING, AND ACCESSORIES FOR A COMPLETE AND OPERATIONAL INSTALLATION.
6. PROVIDE NEW 200A, 277/480V, 3-PHASE, 4-WIRE FUSED DISCONNECT SWITCH FUSED AT 125A AS PRIMARY OVERCURRENT PROTECTION FOR TRANSFORMER. VERIFY EXACT RATINGS AND COORDINATE INSTALLATION REQUIREMENTS WITH EQUIPMENT NAMEPLATE AND FIELD CONDITIONS PRIOR TO INSTALLATION. PROVIDE ALL NECESSARY CONDUIT, WIRING, AND ACCESSORIES FOR A COMPLETE AND OPERATIONAL INSTALLATION.
7. NEW 75 KVA, 3-PHASE, FLOOR MOUNTED TRANSFORMER PROVIDED BY LANDLORD WITH 277/480V PRIMARY AND 120/208V SECONDARY SHALL REMAIN. E.C. SHALL VERIFY THE TRANSFORMER IS INSTALLED ON A STRUCTURALLY RATED FLOOR PAD WITH PROPER VIBRATION ISOLATION. MAINTAIN 3' FRONT CLEARANCE AND SIDE/REAR CLEARANCES PER THE MANUFACTURER'S INSTRUCTIONS. ENSURE ACCESSIBILITY, LABELING, GROUNDING, AND DISCONNECTS IN COMPLIANCE WITH NEC SECTIONS 110.26, 450.11, 250, AND 450.3. E.C. SHALL COORDINATE THE TRANSFORMER LOCATION WITH THE ARCHITECT/LANDLORD TO ENSURE ALL CODE-REQUIRED CLEARANCES ARE MAINTAINED. BASE BID ACCORDINGLY.
8. NEW 200A (MCB), 120/208V, 3-PHASE, 4-WIRE ELECTRICAL PANEL "A" PROVIDED BY LANDLORD FOR THE PROJECT SPACE. E.C. SHALL COORDINATE WITH ARCHITECT/OWNER FOR EXACT LOCATION IN FIELD. BASE BID ACCORDINGLY.
9. NEW 125A (MLO), 120/208V, 3-PHASE, 4-WIRE ELECTRICAL PANEL "B" PROVIDED BY LANDLORD FOR THE PROJECT SPACE. E.C. SHALL COORDINATE WITH ARCHITECT/OWNER FOR EXACT LOCATION IN FIELD. BASE BID ACCORDINGLY.
10. E.C TO FIELD VERIFY THE EXACT LENGTH OF THE CABLE AND CHECK THE VOLTAGE DROP IS UNDER LIMIT PER NEC BEFORE INSTALLATION.

2 ELECTRICAL RISER DIAGRAM
SCALE: N.T.S.

GENERAL NOTES:

1. E.C. SHALL VERIFY THE INCOMING SERVICE AMPERAGE, VOLTAGE, NUMBER OF PHASES, WIRE SIZE AND DISTRIBUTION IN FIELD.
2. E.C. TO COORDINATE FAULT CURRENT (ISC) RATING WITH UTILITY COMPANY AND AHJ PRIOR TO COMMENCING ANY WORK.
3. E.C. SHALL VERIFY THE EXACT POWER DISTRIBUTION & INCOMING CONNECTION TO ALL PANELS IN FIELD. INFORM ENGINEER FOR ANY DISCREPANCY FOUND.


PROJECT:
REDLINE ATHLETICS - FLEMINGTON NJ

DRAWING TITLE:
ELECTRICAL PANEL SCHEDULES & RISER DIAGRAM

SHEET:
E-401